

Rpt. 6.

For the information of Surveyors and the Committee only.

Received at

Office

16 JAN 1918

19

## Lloyd's Register of Shipping.

(Report on Vessel No. 304,80

Port Hull

s/s John Jacobs

No. ✓ SHIP FORGINGS OR CASTINGS.

I have to report that the undermentioned Iron or Steel Forgings or Castings, manufactured by Messrs L. S. Forster & Son Ltd of Sunderland for the Vessel No. 840, being built by Cochrane & Son Ltd of Selby, have been inspected by me as set forth below and found to be, so far as can be seen, Sound

Mark on Forgings or Castings.

Lloyd's


No. 1020

D. D. Williamson.

Sunderland, 14-1-18

	STERN FRAME.	RUDDER FRAME.	STEM.
Material*	Scrap Iron	Scrap Iron	
How made	Forged	Forged	
Dimensions	6' x 3 1/4"	4 1/2' dia 4 1/2' x 3 1/2' x 3 1/2'	
Progress on Inspection	Forged & Finished	Forged & Finished	
Date when Inspected	25-7-17 to 4-10-17	11-12-17 to 11-1-18	
CASTINGS.			
Tests on Standard Test Pieces.			
Tensile Test—			
Tons per square inch			
Extension per cent.			
Cold Bending Test—			
Angle before fracture			
Drop Test—			
Height from ground			
Hammering Test—			
If made according to Rules and found satisfactory			

SKETCHES OF FRAMES SHOWING POSITION AND DESCRIPTION OF WELDS OF FORGINGS.

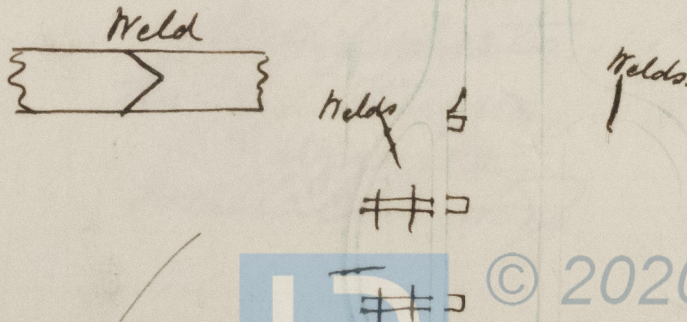

Fee (if any chargeable) £

To be paid at

\* If of Iron, state whether scrap or puddled Iron. If of steel, state whether made on the Open Hearth process.

2nd, 6, 17. T.

005141-005153-0132

005141 005153 0135

State whether the Vessel has been built under Special Survey