


Nº 277.

Scale:  $\frac{1}{8}'' = 1 \text{ FOOT.}$

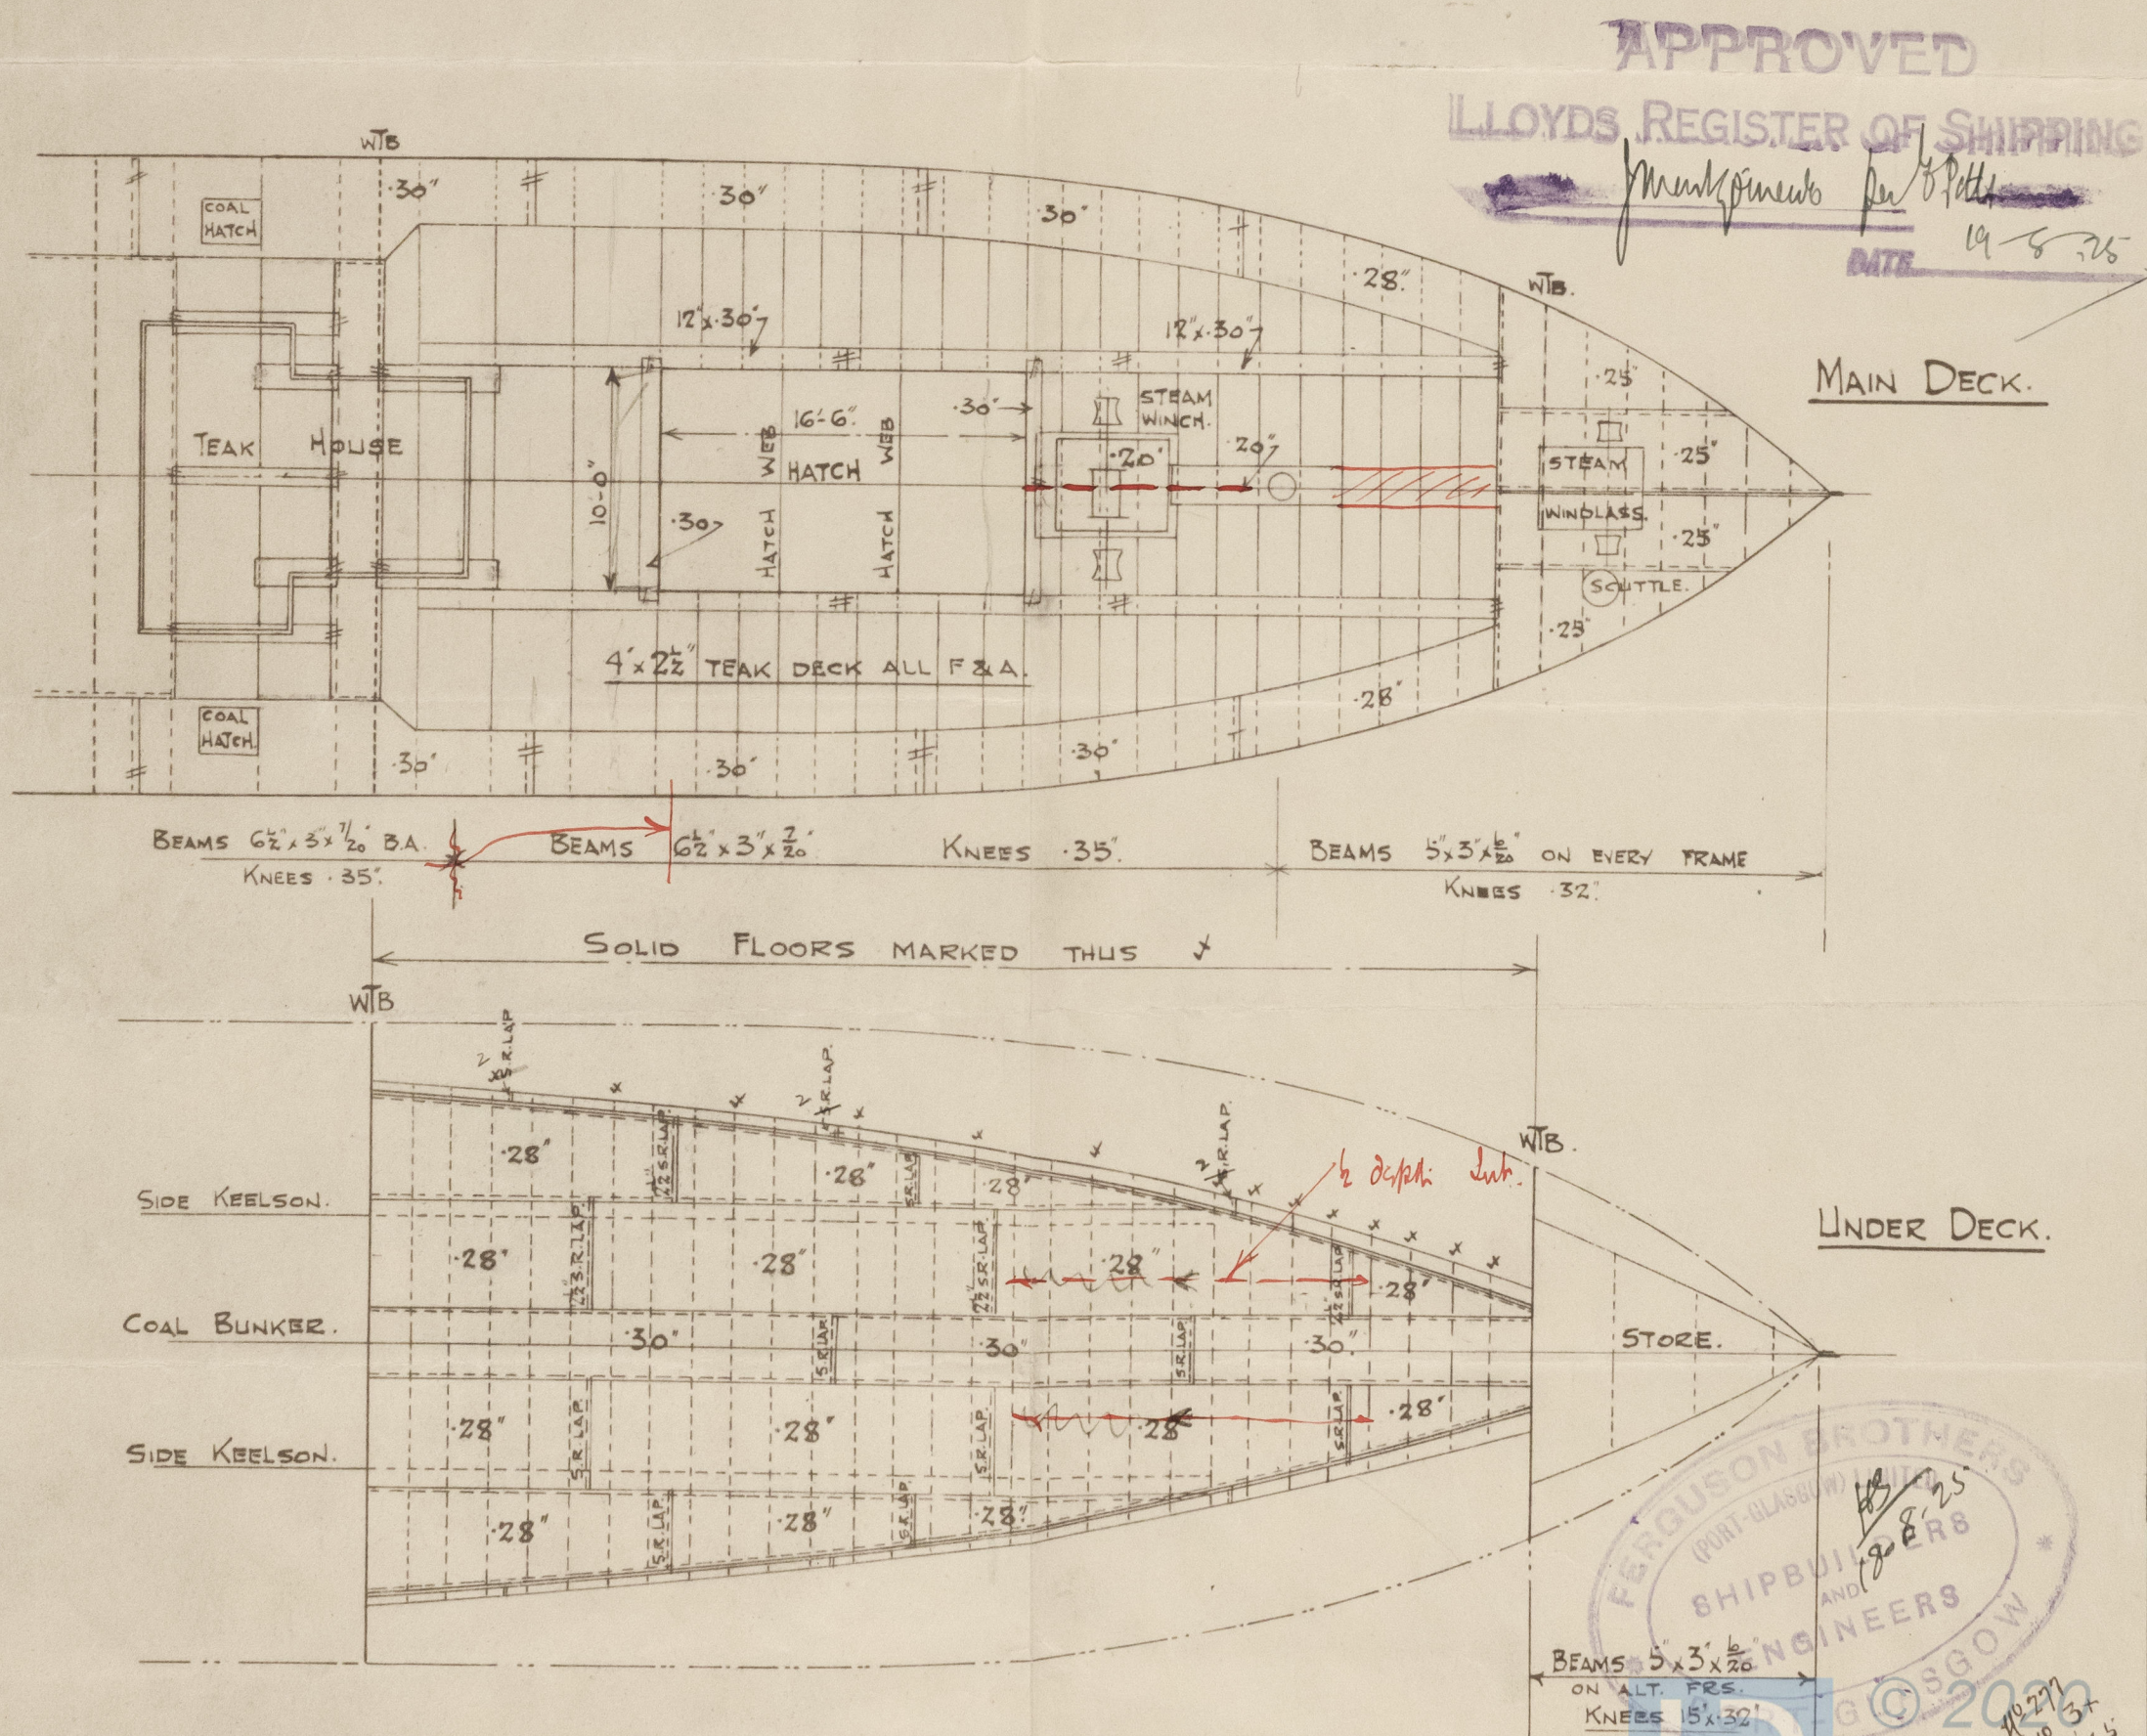

FERGUSON BROTHERS  
(PORT-GLASGOW)  
SHIPBUILDERS  
AND  
ENGINEERS  
GLASGOW

MS 5' 3" x 3' 6" x 20'  
N. ALT. PRES.  
KNEES 15' x 32'

2021  
40271  
10

Yarrow  
place  
18th Ave.  
J. M. M. M.



FERGUSON. BROS. LTD.

No 277.

AMENDMENTS. TO PROFILE  
AND DECK PLANS.

T. S. S. 'AZANIA'

Greek. Regt No. 18505

005141-005153-0241



© 2020

Lloyd's Register  
Foundation



new Profile.

005141-005153-0241



© 2020

Lloyd's Register  
Foundation