



N^o 277

AMENDMENT TO MIDSHIP SECTION.

SCALE: $\frac{1}{2}$ " = 1 ft.

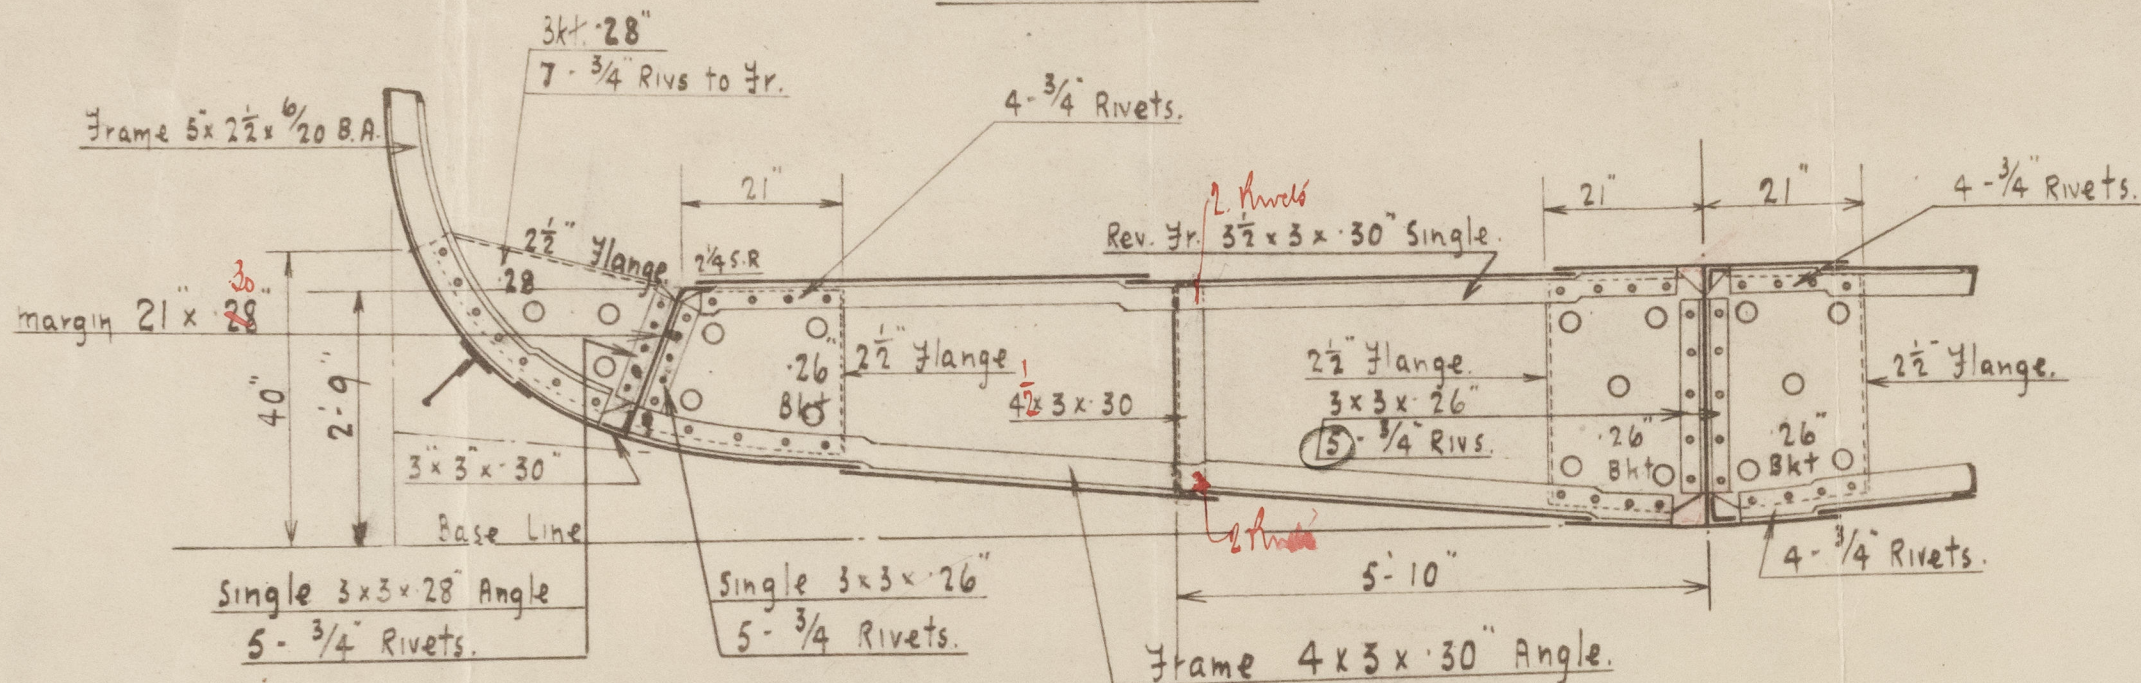

SECTION IN WAY OF BRACKET FLOOR

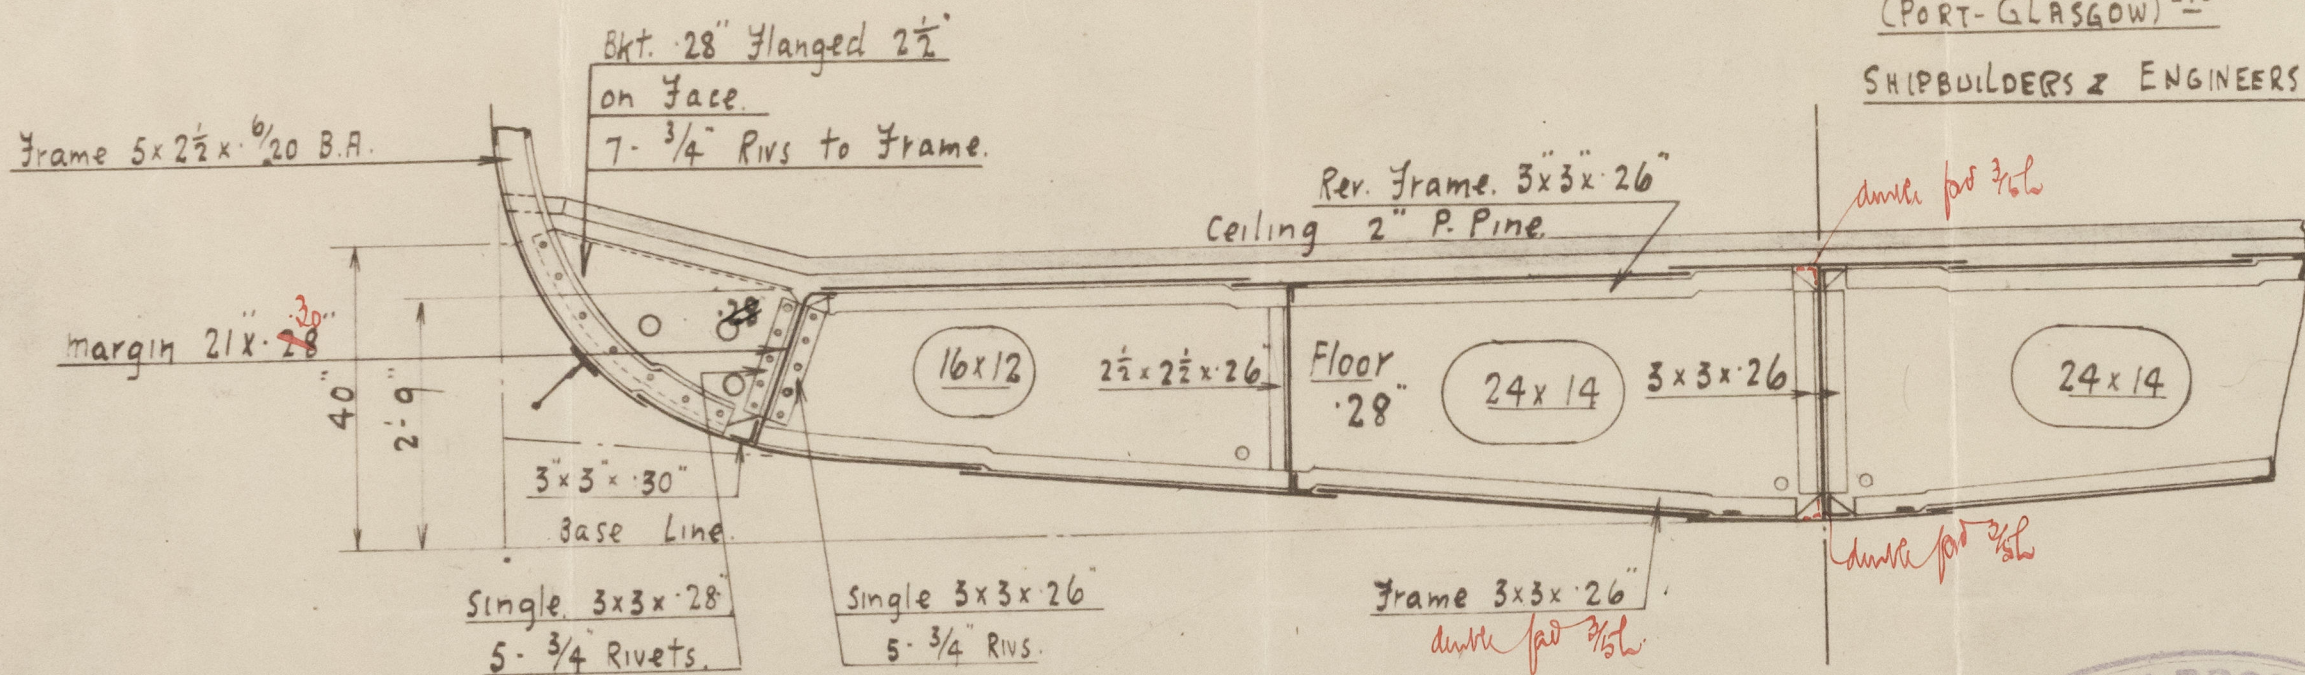

FERGUSON BROS.
(PORT-GLASGOW) LTD.
SHIPBUILDERS & ENGINEERS.

SECTION IN WAY OF SOLID FLOOR.


HALF SECTIONS IN WAY OF BALLAST TANK.

SOLID FLOOR EVERY 3RD FRAME & AS PER "PROFILE" PLAN.


APPROVED
LLOYDS REGISTER OF SHIPPING

Amendments for 19.8.25
DATE

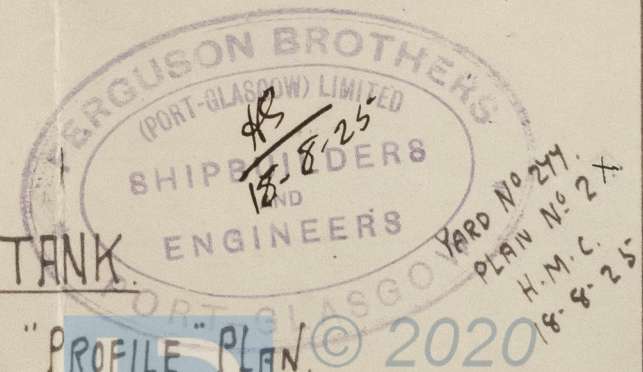

005141-005153-0242

Lloyd's Register
Foundation

FERGUSON. BROS. LTD.

No. 277.

AMENDMENTS. TO. MIDSHIP. SECTION.

T. S. S. "AZANIA"

Greek. Reg. No. 18505.

25 26 27 

005141-005153-0242



© 2020

Lloyd's Register
Foundation