

Lloyd's Register of Shipping.

(Report on Vessel No. 30,130 Port Hull)

No.

SHIP FORGINGS OR CASTINGS.

I have to report that the undermentioned Iron or Steel Forgings or Castings, manufactured by M^{rs} J. S. Forster & Sons Ltd of Sunderland for the Vessel No. 340 K, being built by Book Weldon & Hummel Ltd of Beverley have been inspected by me as set forth below and found to be, so far as can be seen, Sound

Mark on Forgings or Castings.

Lloyd's



No. 294

D. D. Williamson.

Sunderland 6-11-16

	STERN FRAME.	RUDDER FRAME.	STEM.
Material* ...	Scrap Iron	Scrap Iron	
How made ...	Forged	Forged	
Dimensions ...	4 1/2" x 2 3/8"	4 1/2" x 4 1/2" x 6"	
Progress on Inspection ...	Finished	Forged & Finished	
Date when Inspected	12-10-16	13-10-16 to 6-11-16	
CASTINGS.			
Tests on Standard Test Pieces.			
Tensile Test—			
Tons per square inch ...			
Extension per cent. ...			
Cold Bending Test—			
Angle before fracture ...			
Drop Test—			
Height from ground ...			
Hammering Test—			
If made according to Rules (and found satisfactory ...)			

SKETCHES OF FRAMES SHOWING POSITION AND DESCRIPTION OF WELDS OF FORGINGS.

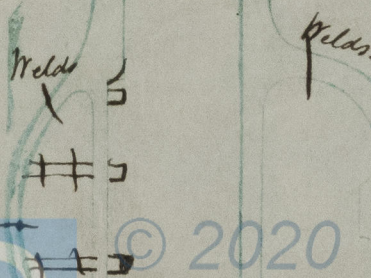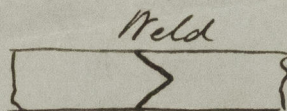

Fee (if any chargeable) £

To be paid at

* If of Iron, state whether scrap or puddled Iron. If of steel, state whether made on the Open Hearth process.

54

104

123

1844

1892

21

3

15-01-21

20

's Do

Qualit

© 2020

Lloyd's Register
Foundation