

SPECIAL NOTATIONS:
LONGITUDINAL FRAMING ON BOTTOM AND DECK
ELECTRICALLY WELDED*.

HOOFDAFM. :

L LENGTE LL.	$460' - 0'' =$	140,205 m.
B BREEDTE SPI	$59' - 0'' =$	17,982 m.
D HOLTE 1/2 ZIJDE	$34' - 0'' =$	10,363 m.

LLOYD'S NUMBERS:

$L \times D = 460 \times 34 = 15640$ ✓

$L(B+D) = 460 \times (59+34) = 42780$ ✓


$L:D = 460:34 = 13.52$ ✓

Part Shell plating
GEDEELTE HUIDBEPLATING

E. Weld
GEL. VERE
1. 5. 24


Forecastle
BAKDEK
GLAD STALEN DE
flat steel dec

WILTON-FUENKOORD, SCHIEDAM.					AFDELING: SCHIEPERSBOUW		EICH: 1100	
BOUW N ^o	GROEN	TEKEN N ^o	ABANT BL	MIRAL	MISE LUST			
720	501A	4	1	1	✓	Longitudinal plan <u>LANGS DOORSNEDE</u> EN and <u>DEKKEN Decks</u>		
						GET. N ^o 1 CEC. N ^o 1 MIE. N ^o 1 LUST. N ^o 1 HES. N ^o 1	A A A A A A A A	BLAD N ^o 100 REG N ^o 112209

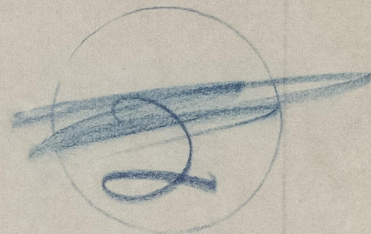

MITRA
RETAIN

RECORDS DEPT.
LONDON

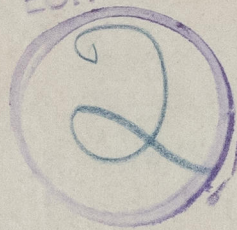

WILTON - FYENOORD
YARD N° 720

PROFILE & DECKS



© 2020

Lloyd's Register
Foundation