

SAN FERNANDO  
Seem. T.S. Record.

( 1/61 ending. afloat. -  
 28/11/60 afloat @ Singapore.  
 4/11/60 afloat @ Samarang. )

30870 { 5/65. (4034<sup>u</sup>) recorded.  
 8/61 — Rood. (Xim's skin)

30970 { 4/57. — do —

30870 { 7/53 1/2. —

30170 { 6/50 (NEW) tracked in Key Seal<sup>r</sup> at food. end  
 of tape.

10/11 H.W. dumpy. 12/49. Rudder up. w. 932.

30370. ↑ 3/47. ( 932 )

370. ↑ 3/44 a file.

20470. ↑ 8/41. 932 (grounding dumpy.)

30370. ↑ 10/39. 1/2.



20670. ↑ 5/36. —



© 2020

Lloyd's Register  
 Foundation

005187-005193-0280

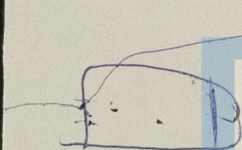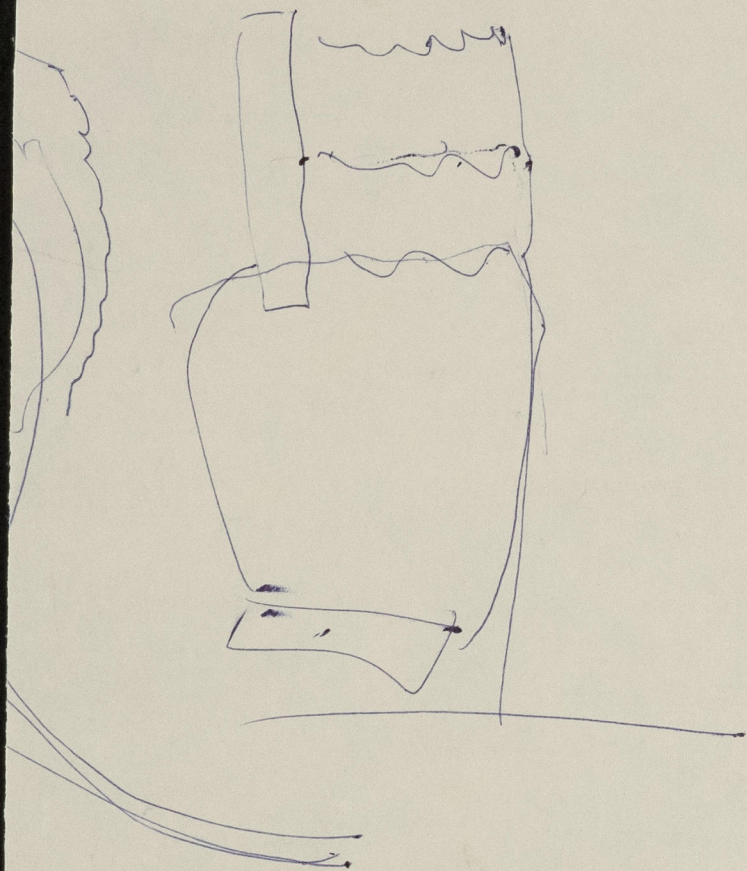

190.



© 2020

Lloyd's Register  
Foundation