


SKETCH OF GUDGEON WHERE RUDDERPOST

005193-0347

Mærsk. S. Aalborg Vægt
Yard No. 58.

Rüdder & Sternframe

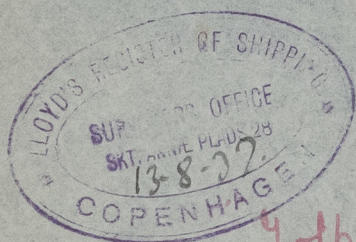

(5)

Gotken
s.s. "Latta" of Esbjerg
Exp. Report No. 10617

PLANS TRANSFERRED
TO SISTER VESSEL
PLANS TRANSFERRED
TO SISTER VESSEL

Kattegat



© 2020

Lloyd's Register
Foundation

005187-005193-0347