


# P.V. 6111

## MIDSHIP SECTION.

DIMENSIONS:- 176'-0" B.P. x 27'-6" MLD x 16'-0" MLD.

SCALE:-  $\frac{1}{2}$ " = 1 FOOT

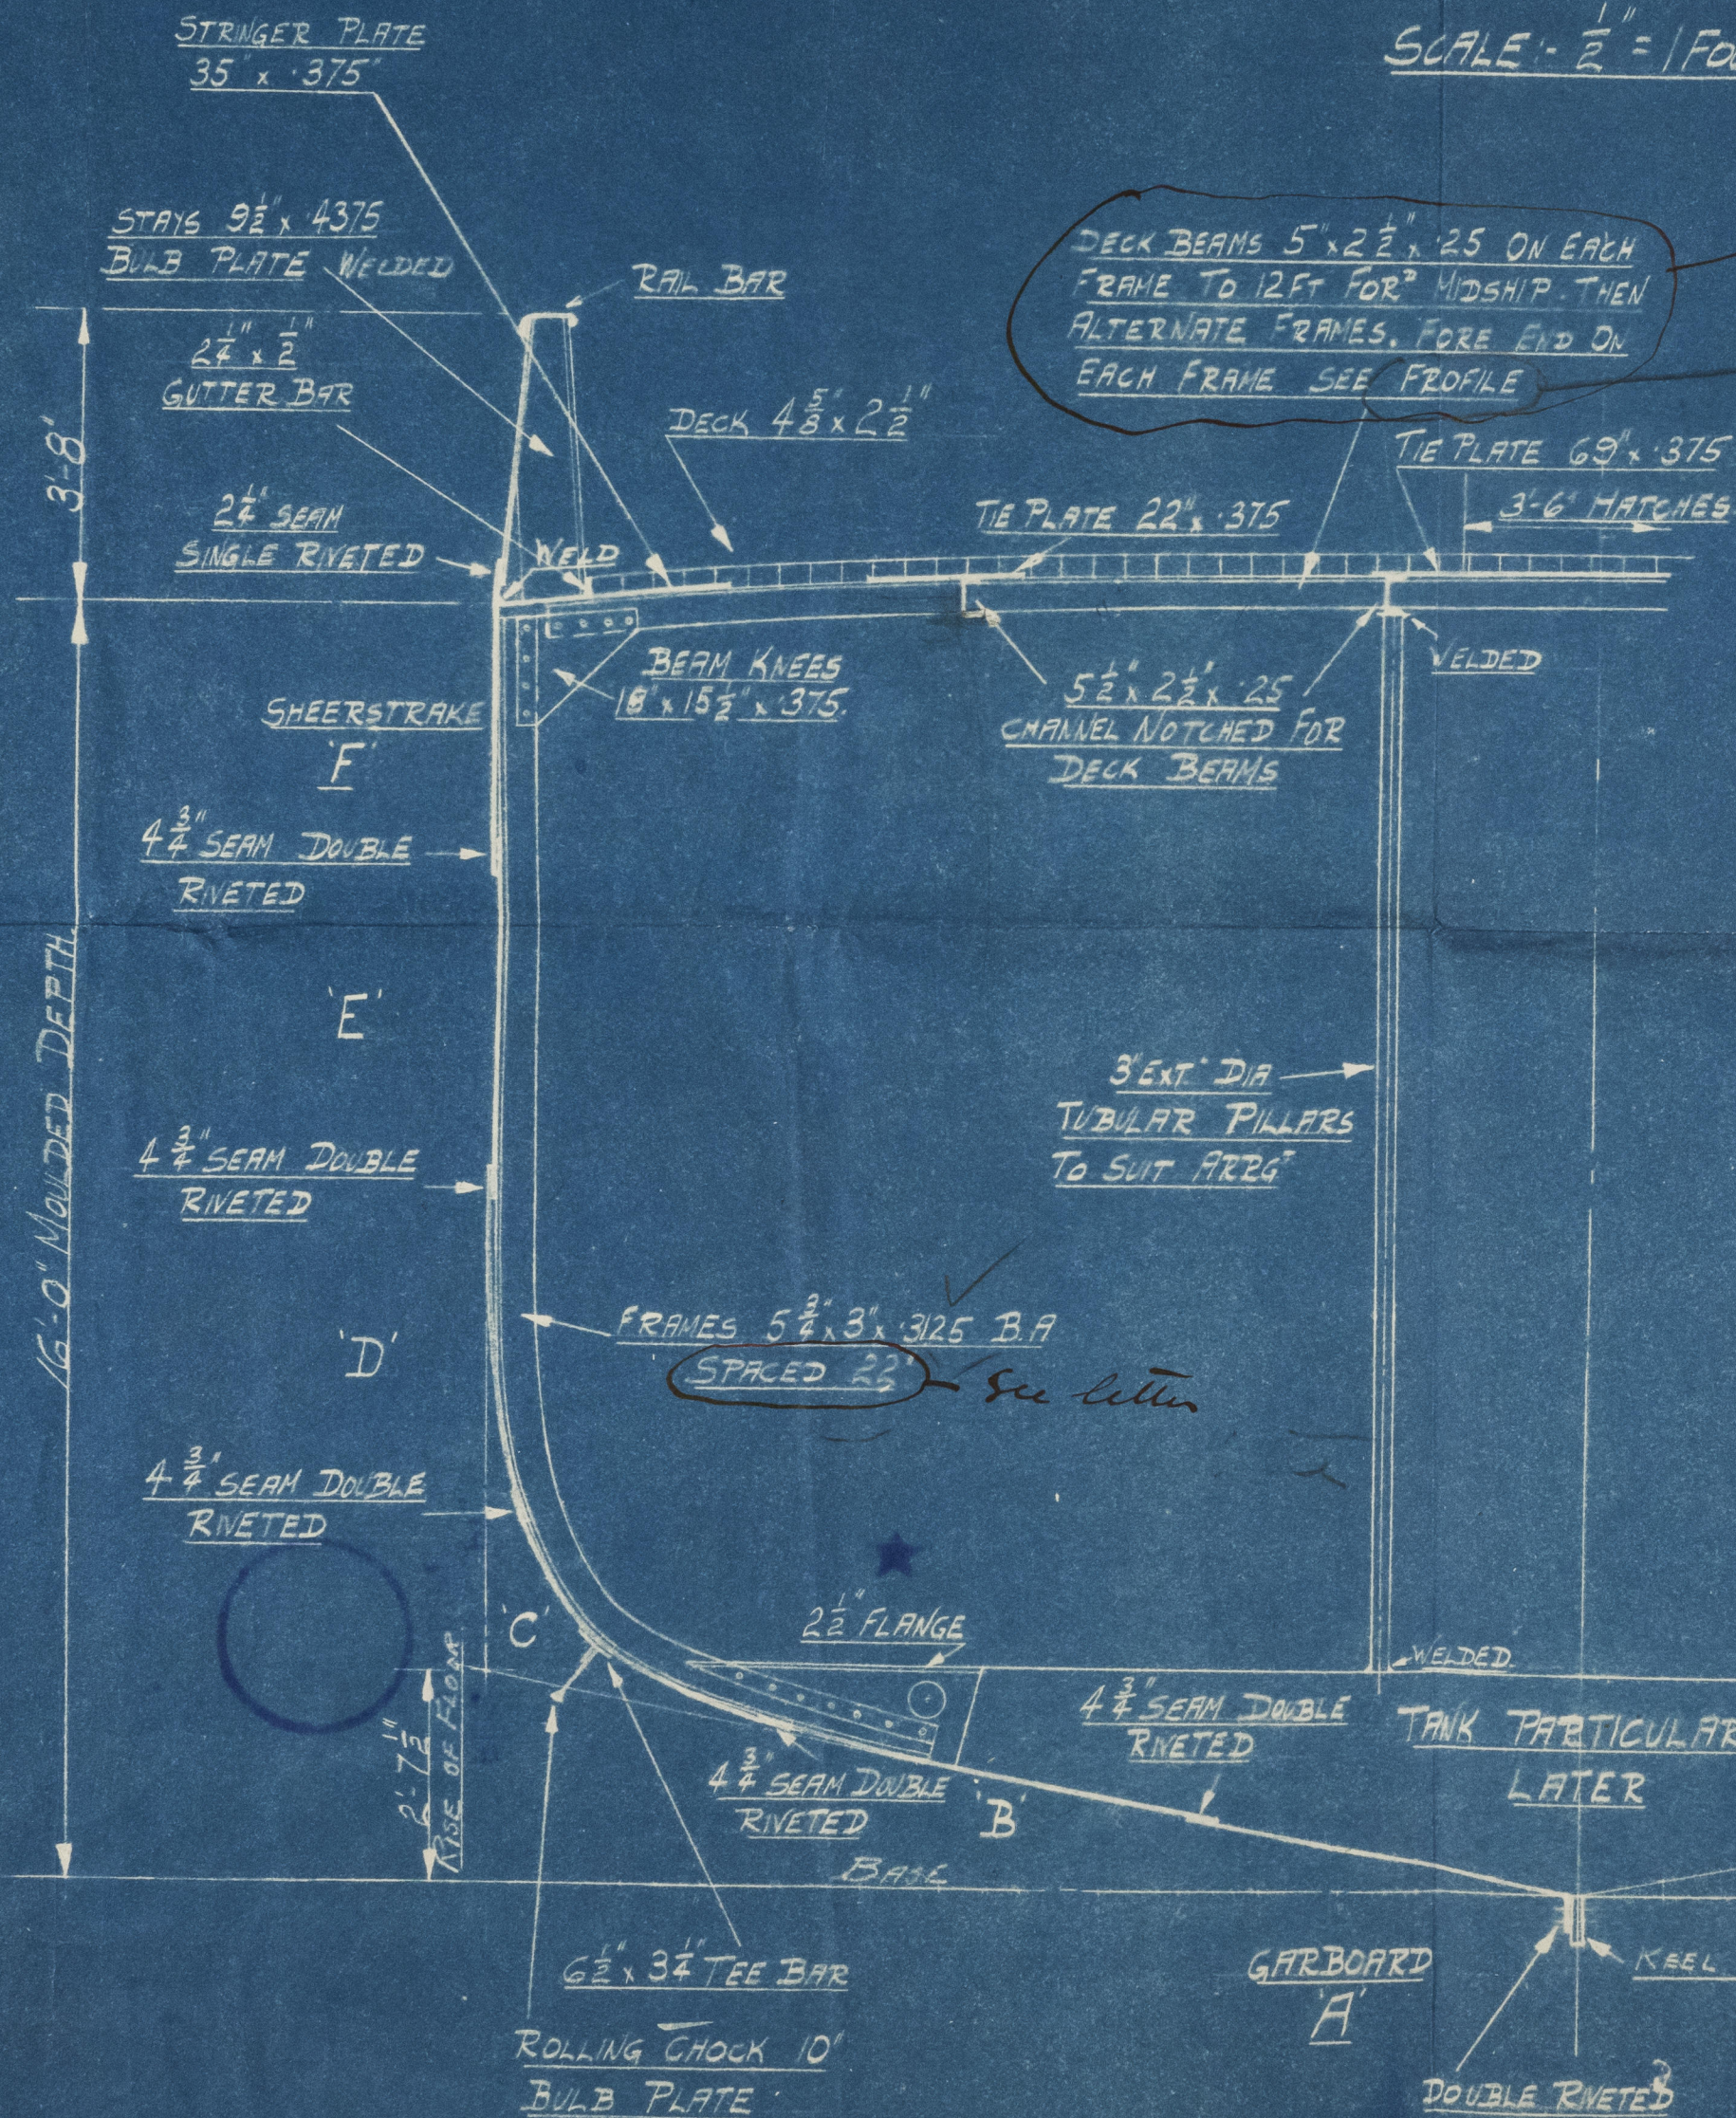

DECK BEAMS 5" x 2 1/2" x .25 ON EACH FRAME TO 12 FT FOR MIDSHIP THEN ALTERNATE FRAMES. FORE END ON EACH FRAME SEE PROFILE

See letter  
to be submitted

For Class & Equipment  
See letter.

STRAKE	PLATE THICKNESS		
	FOR	MIDSHIP	AFT.
GARBOARD A	$\frac{9}{20}$	$\frac{9}{20}$	$\frac{10}{20}$
B	$\frac{9}{20}$	$\frac{9}{20}$	$\frac{8}{20}$
C	$\frac{10}{20}$	$\frac{8}{20}$	$\frac{7 1}{2}}{20}$
D	$\frac{10}{20}$	$\frac{8}{20}$	$\frac{8}{20}$
E	$\frac{11}{20}$	$\frac{8}{20}$	$\frac{7}{20}$
SHEER F	$\frac{7 1}{2}}{20}$	$\frac{7 1}{2}}{20}$	$\frac{7 1}{2}}{20}$

See letter.

VERTICAL BUTTS OF SHELL  
PLATING WELDED

PARTICULARS IN ENGINE &  
BOILER SPACES LATER

Office  
5-11-47


29-10-47



"SLETNES" ★

*Midship section*

RECORDS DEPT.  
LONDON

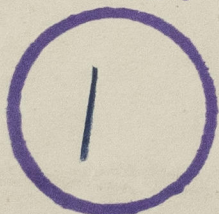

© 2020

Lloyd's Register  
Foundation