
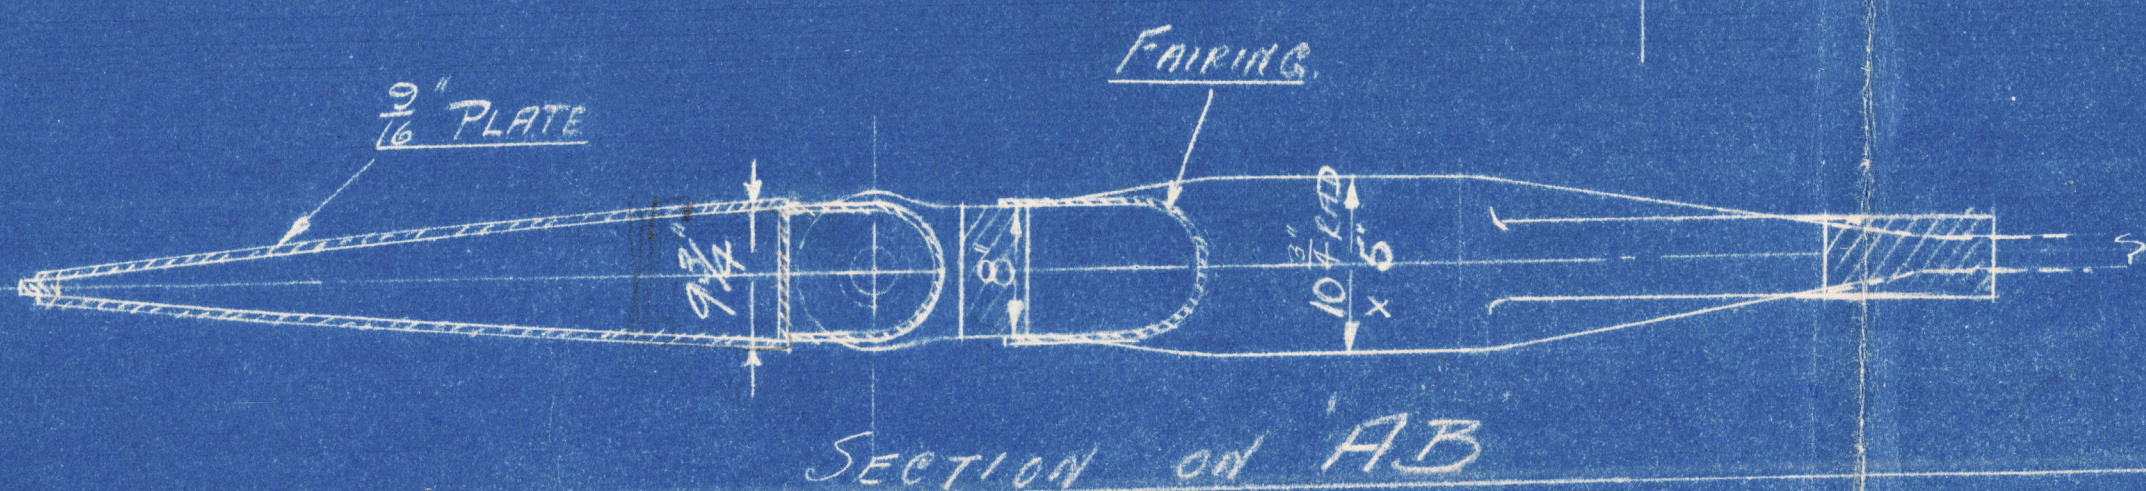
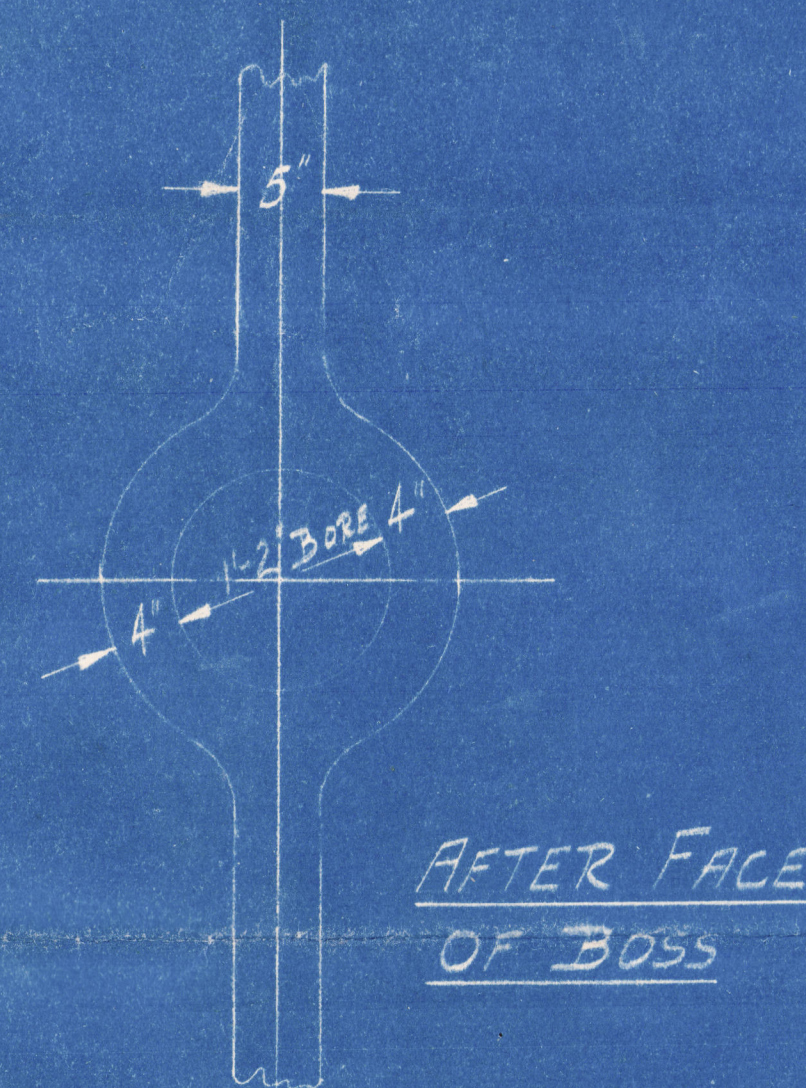


*Speed not exceeding 12 knots*

SPEED NOT TO EXCEED  
12 KNOTS.

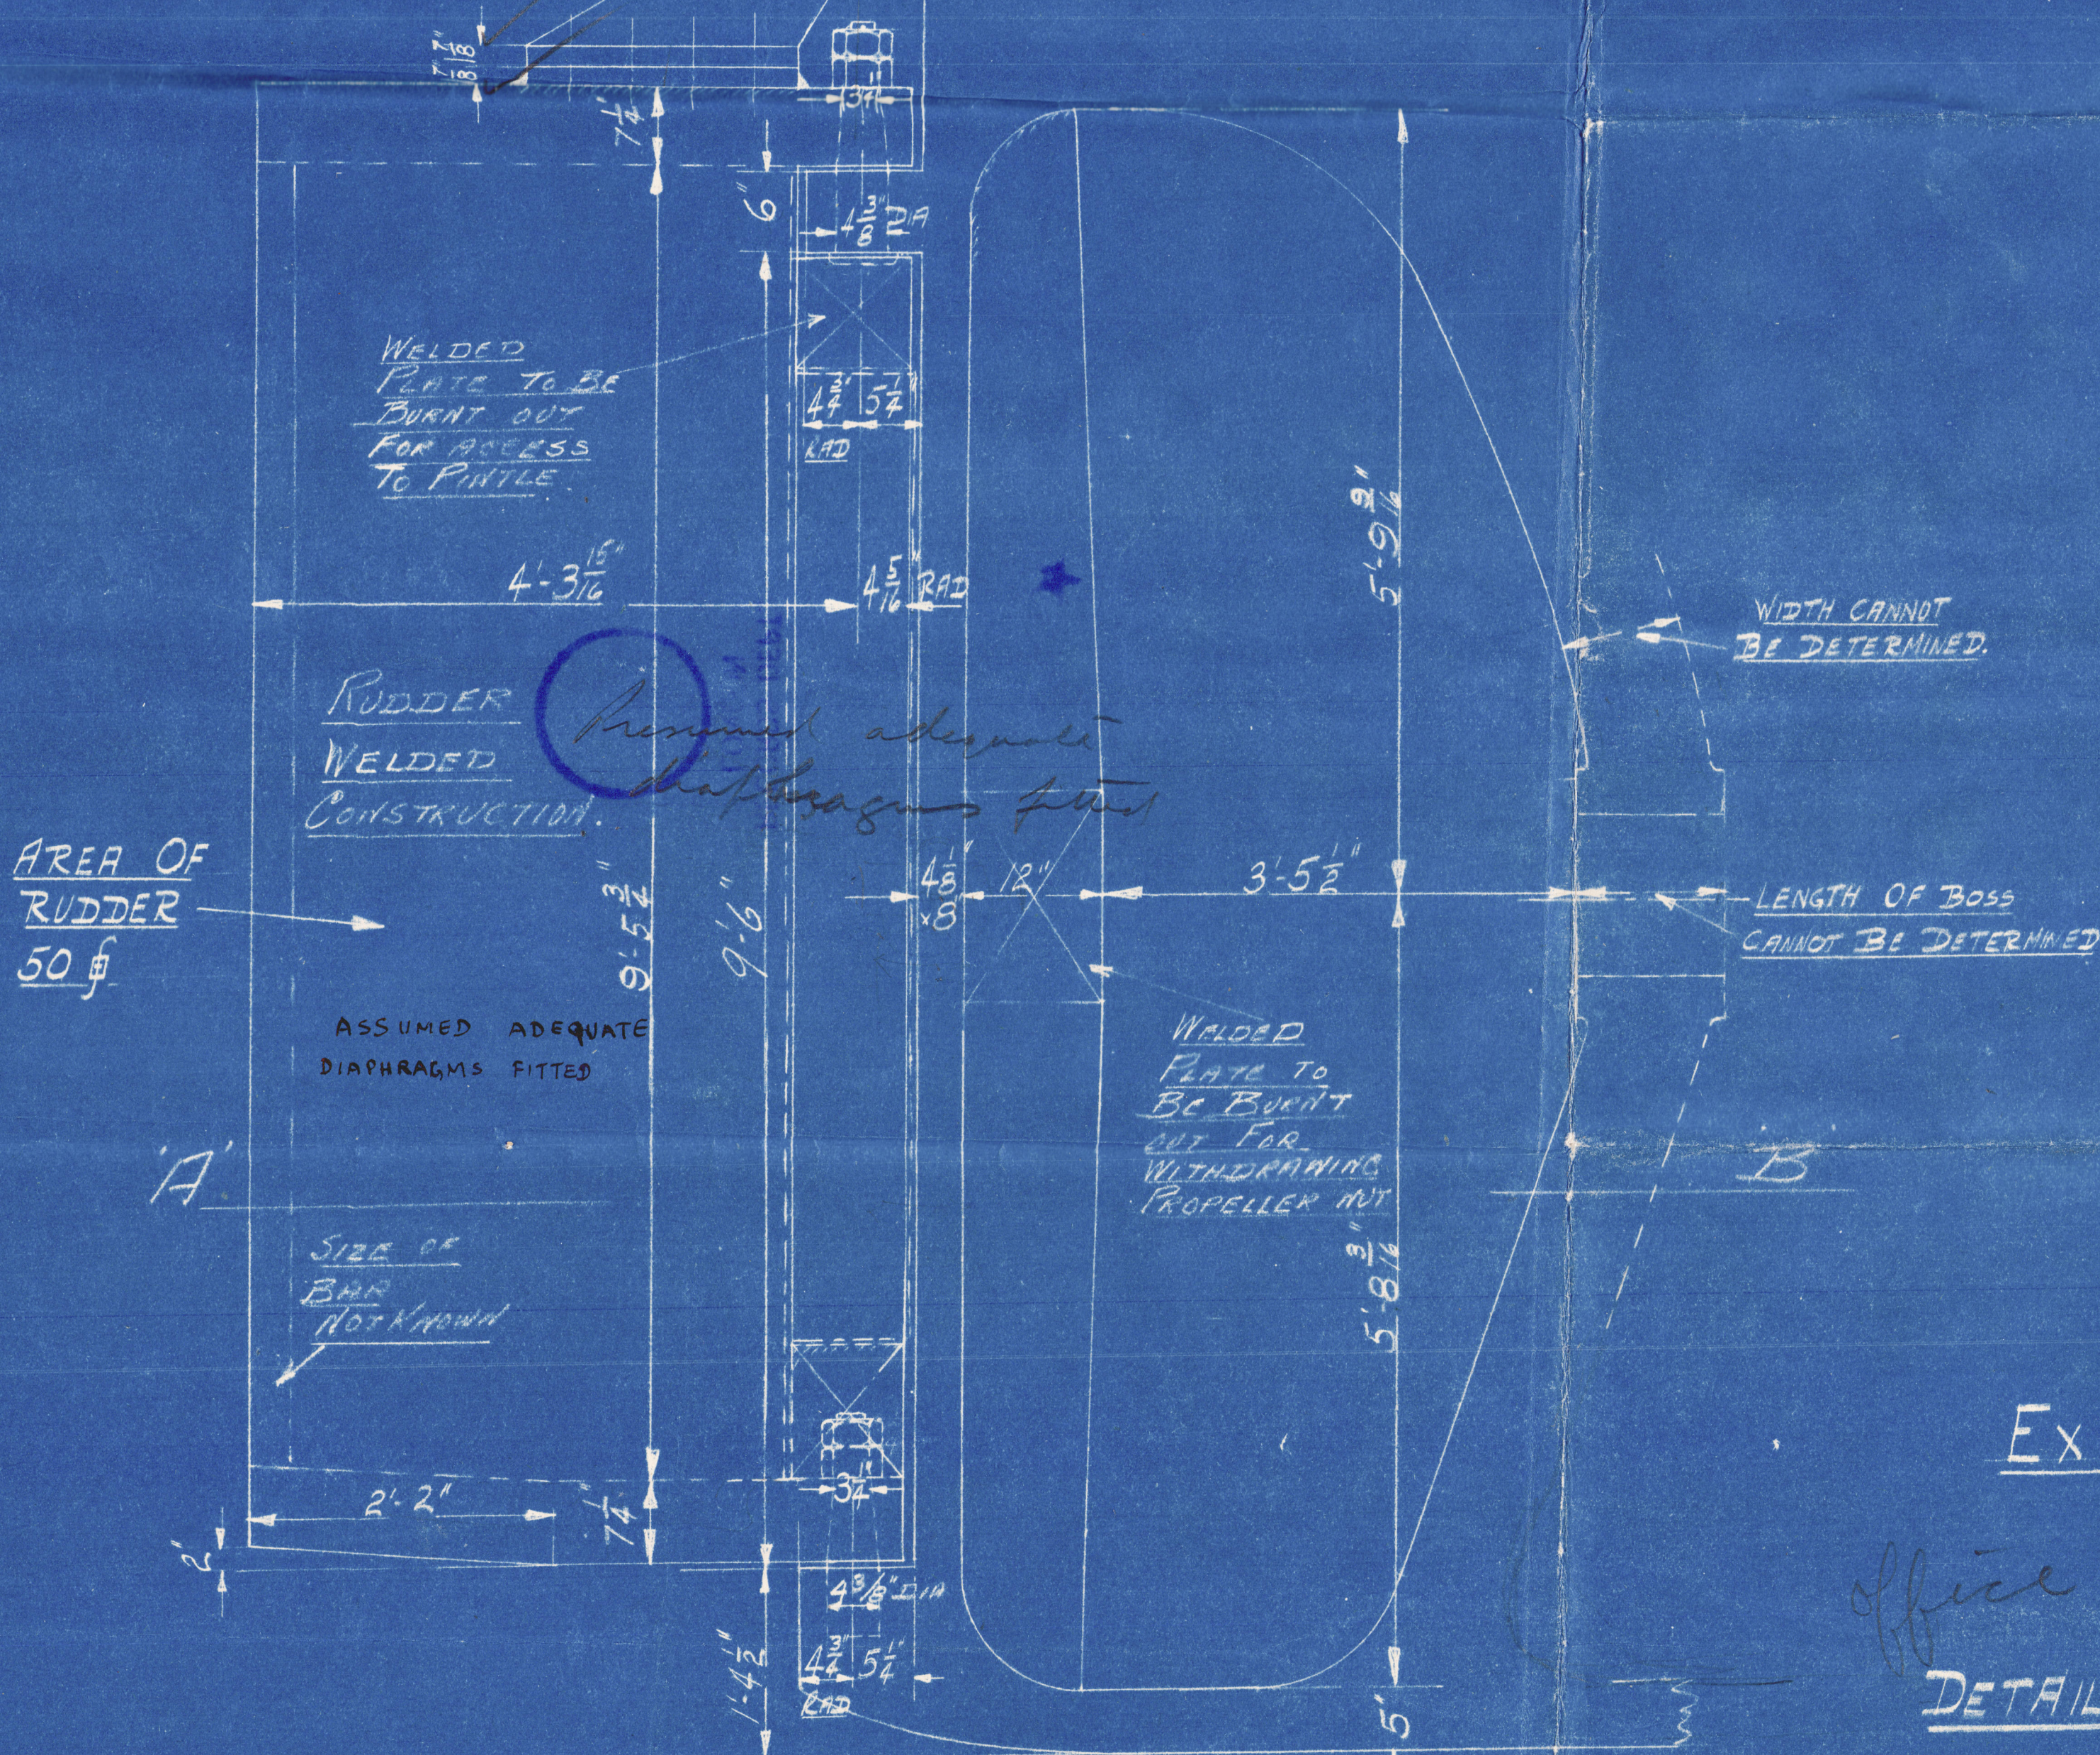

Ex GERMAN VESSEL P.V. 6111.

*Office* S.T. "LARWOT."

DETAIL OF STERN FRAME & RUDDER.

SCALE: 1" = 1 FOOT

LEAKE & WILSON  
Consulting Engineers & Engineers Agents  
120 ALFRED GELDER STREET  
HULL

4-12-47

Lloyd's Register



"SLETNES" ★

*Sternframe & rudder*

RECORDS DEPT.,  
LONDON

3

005194-005209-0003



© 2020

Lloyd's Register  
Foundation