


Copy to builders
28/4/39



Sir James Laing & Co

Proposed 4' 6" to ship
margin plate connection
1" = 1'

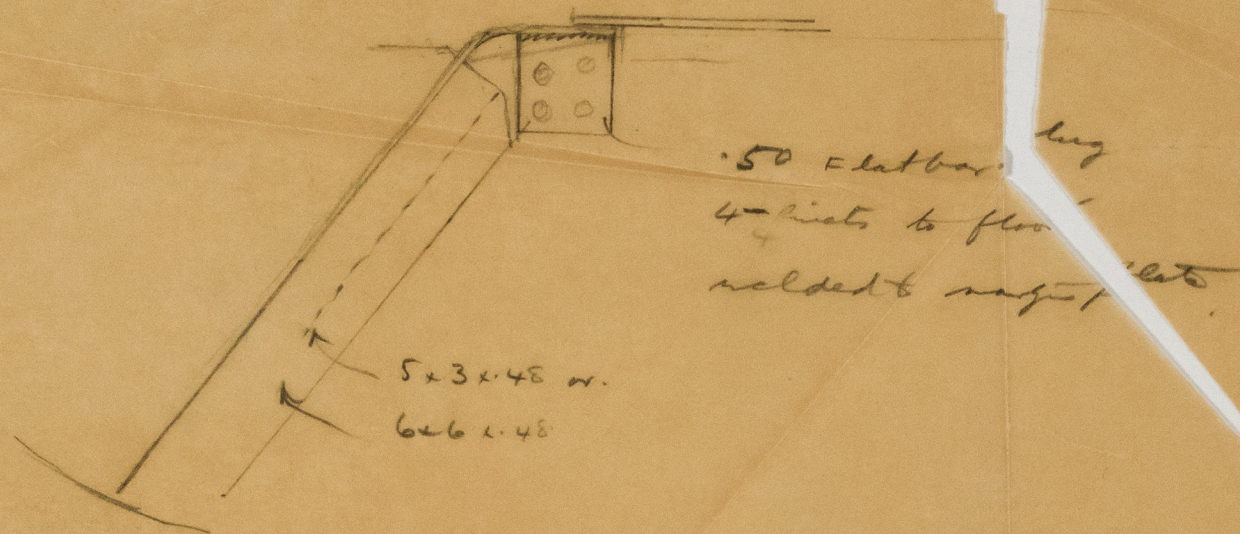

© 2021

Lloyd's Register
Foundation

005210-005218-0004