

S.S. CHARLTON HALL.

SSN^o 731

MIDSHIP SECTION

PRINCIPAL DIMENSIONS		
LENGTH B.P.	426' 6"	
BREADTH B.P.	57' 3"	
DEPTH MLD	56' 11"	
DEPTH MLD	56' 3 1/2"	
DEPTH MLD	27' 5 1/2"	
DEPTH MLD	11' 7 1/2"	
LOAD DRAFT MOULDED	24' 8 3/4"	


COMPLETE SUPERSTRUCTURE TYPE
 S.S. "WITH FREEBOARD" CORRESPONDING TO A DRAUGHT NOT
 EXCEEDING THAT CONTEMPLATED BY THE RULES FOR A COMPLETE
 SUPERSTRUCTURE VESSEL HAVING A TONNAGE OPENING.
 SCALE 1/2" = 1 FOOT.

ALL BULB ANGLE SECTIONS ARE LATEST BRITISH STANDARD.

EQUIPMENT TONNAGE	
To Fore Board Deck	450.5
Twain Decks	420.5
Forecastle	30.33
Saloon House	20.00
Side Houses & Passings	61.00
After Deck House	25.50
Officers House	9.25

2 BOWER ANCHORS (Stockless) 60 Cuts, One Spare (Stockless) 50 Cuts.
 13 Trawl Anchor 19 Cuts. 15 Stock
 225 FATHOMS 2 5/8" STEEL CHAIN CABLE
 90 FATHOMS 4 1/4" TREAD WIRE 120 FATHOMS 4 1/2" STEEL WIRE TOWLINE
 HANSEAS & WARPS: 2 at 90 FATHOMS 8" MANILA, 2 at 90 FATHOMS 7" MANILA.
 225 FATHOMS 2" TACLO

See letter

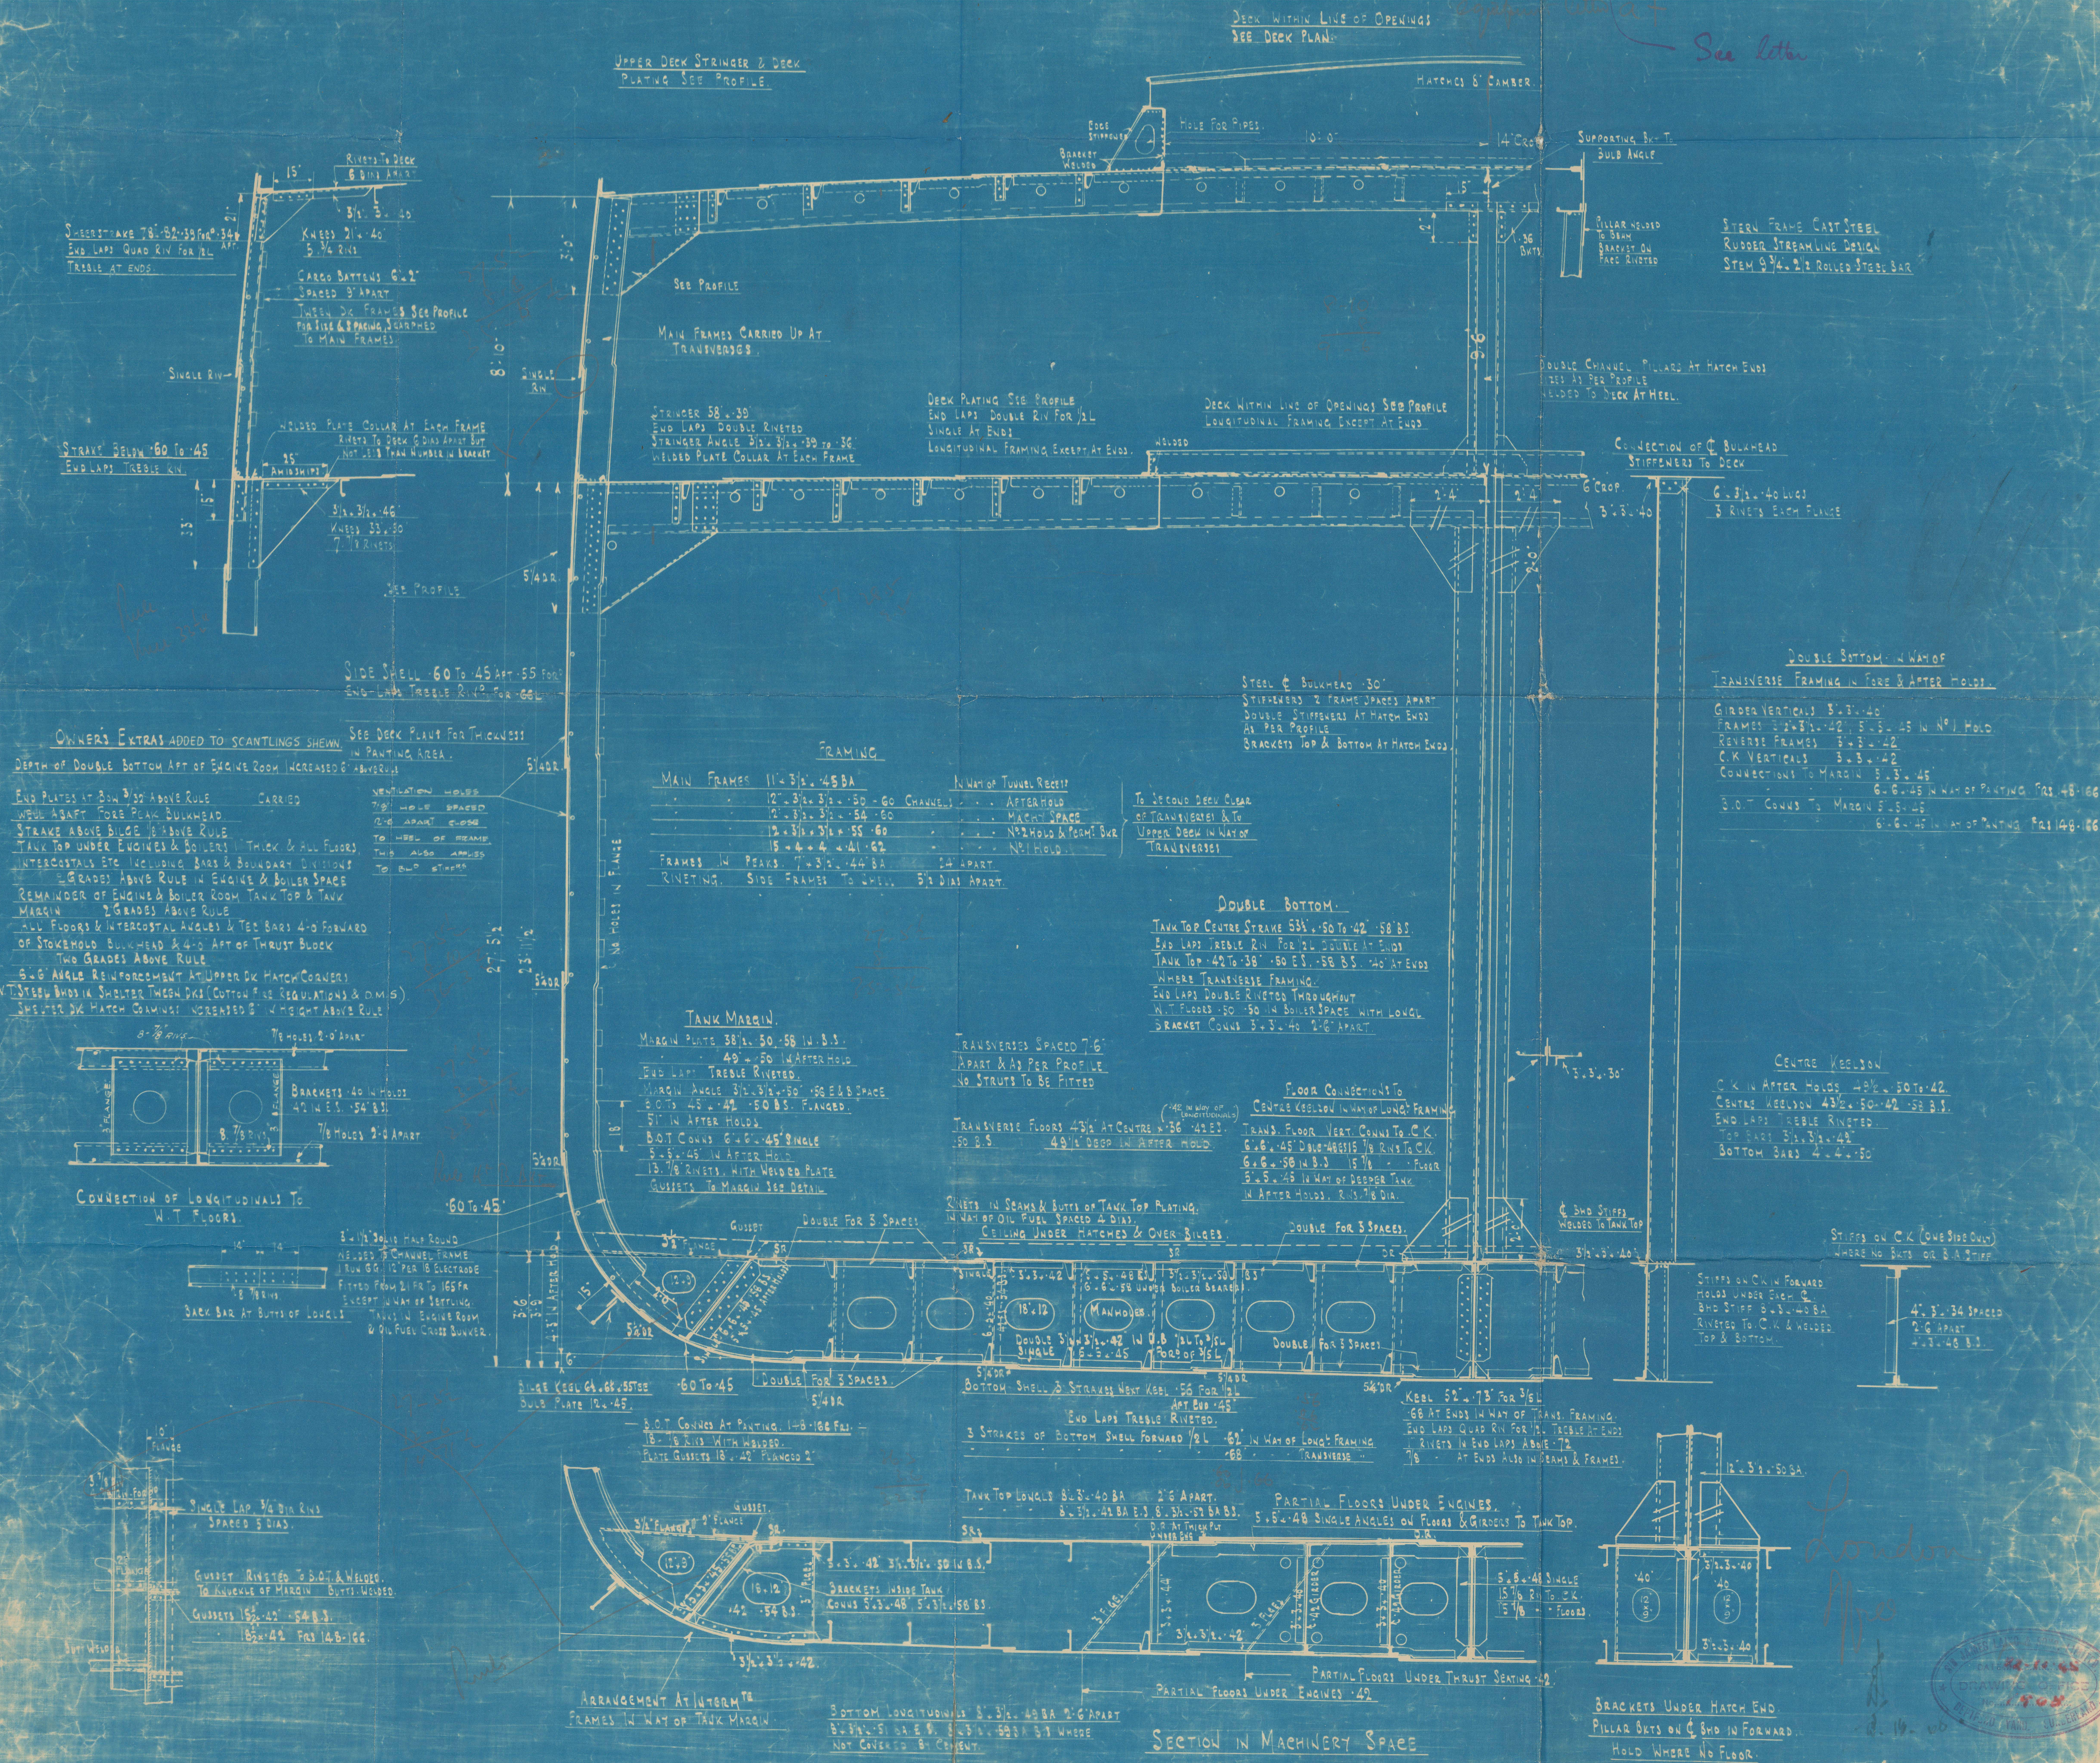


SECTION IN MACHINERY SPACE



"ST. ELWYN" ★

midship section

RECORDS DEPT.,
LONDON

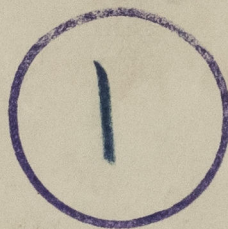

© 2021

Lloyd's Register
Foundation

8000-812500-012500