

PROPOSED VESSEL.

PROFILE.

LENGTH BP 426'6" • 57'3" BOW EXT. • 36'3" DEPTH W/P UPPER DEK



COMPLETE SUPERSTRUCTURE TYPE.

LLoyds REGISTER CLASSIFICATION *BSSIX W.W.L. FINESTON*



SCALE: 1/8" = 1 FOOT

NOTE: THIS PLAN INCLUDES ALL OWNERS' EXTENSIONS AS SHOWN IN SECTION.





MASTS, WINDLASS, WINCHES, STEERING GEAR ETC.
SUPPORTED TO SURVEYOR'S SATISFACTION.

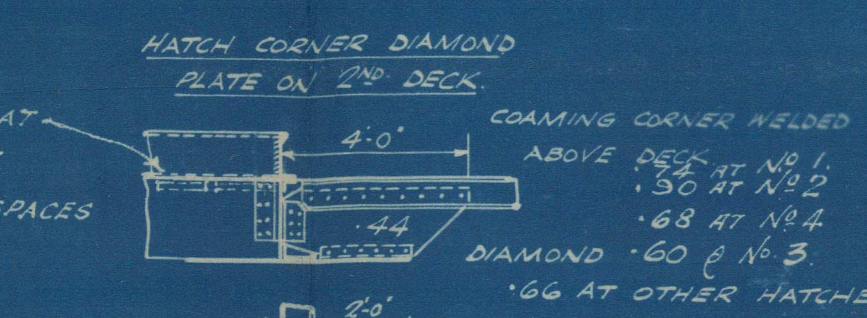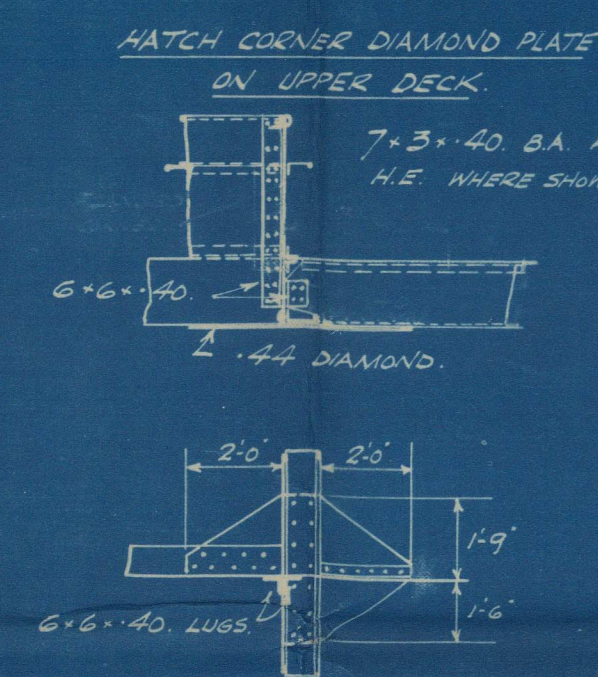

ANGLES FOR 2 SPACES AT EACH END OF NO. 1 & 2 HATCHWAYS & FOR 3 SPACES AT NO. 3.

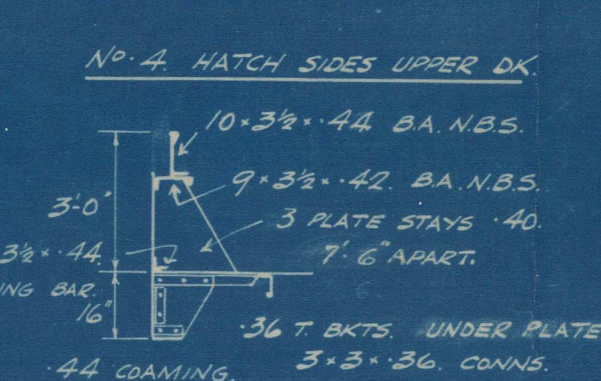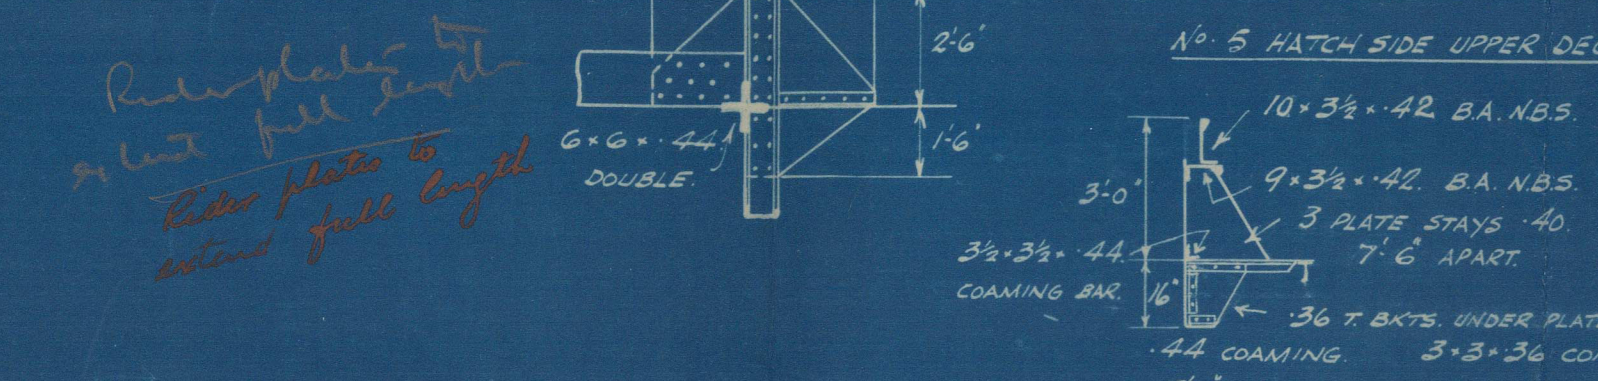

'T' DECK TRANSVERSES

 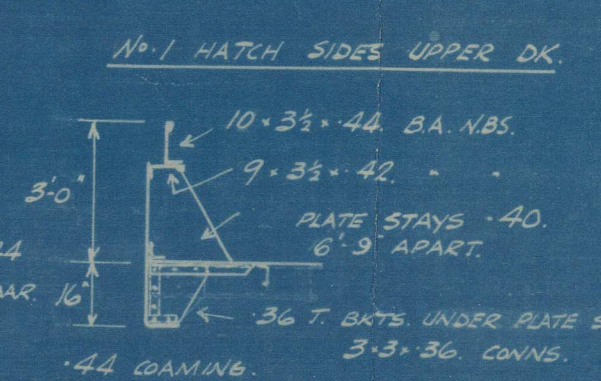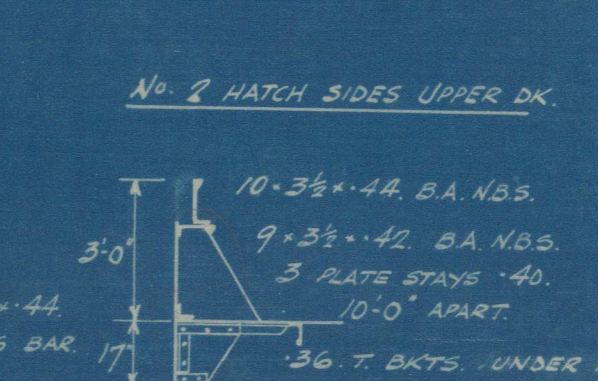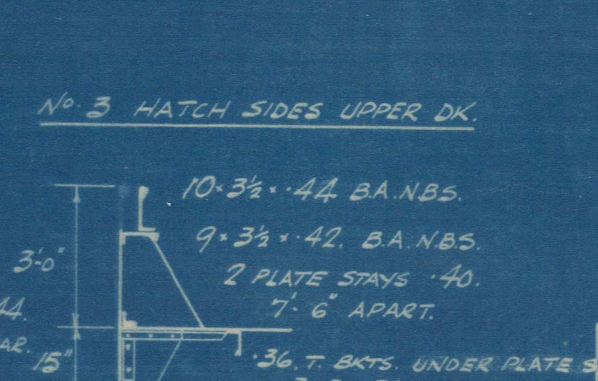

TRANSFERRED TO
L. R. SYSTEM

Profile

Sir J Laing & Sons. Prop. Ship

426' 6" x 57' 3" x 26' 3 1/2"

4/29


Now No 721.

St Edwin



CHARLTON HALL

RECORDS DEPT.
LONDON.

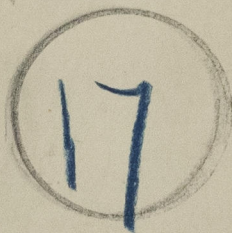

© 2021

Lloyd's Register
Foundation

005210-005218-0009

Profile
Laings