


B/T. "REMEDIOS"


Cubierta Principal
SIZES IN MILLIMETRES.

R = RENEW

ATTACHED TO
BARCELONA RPT N° 6837

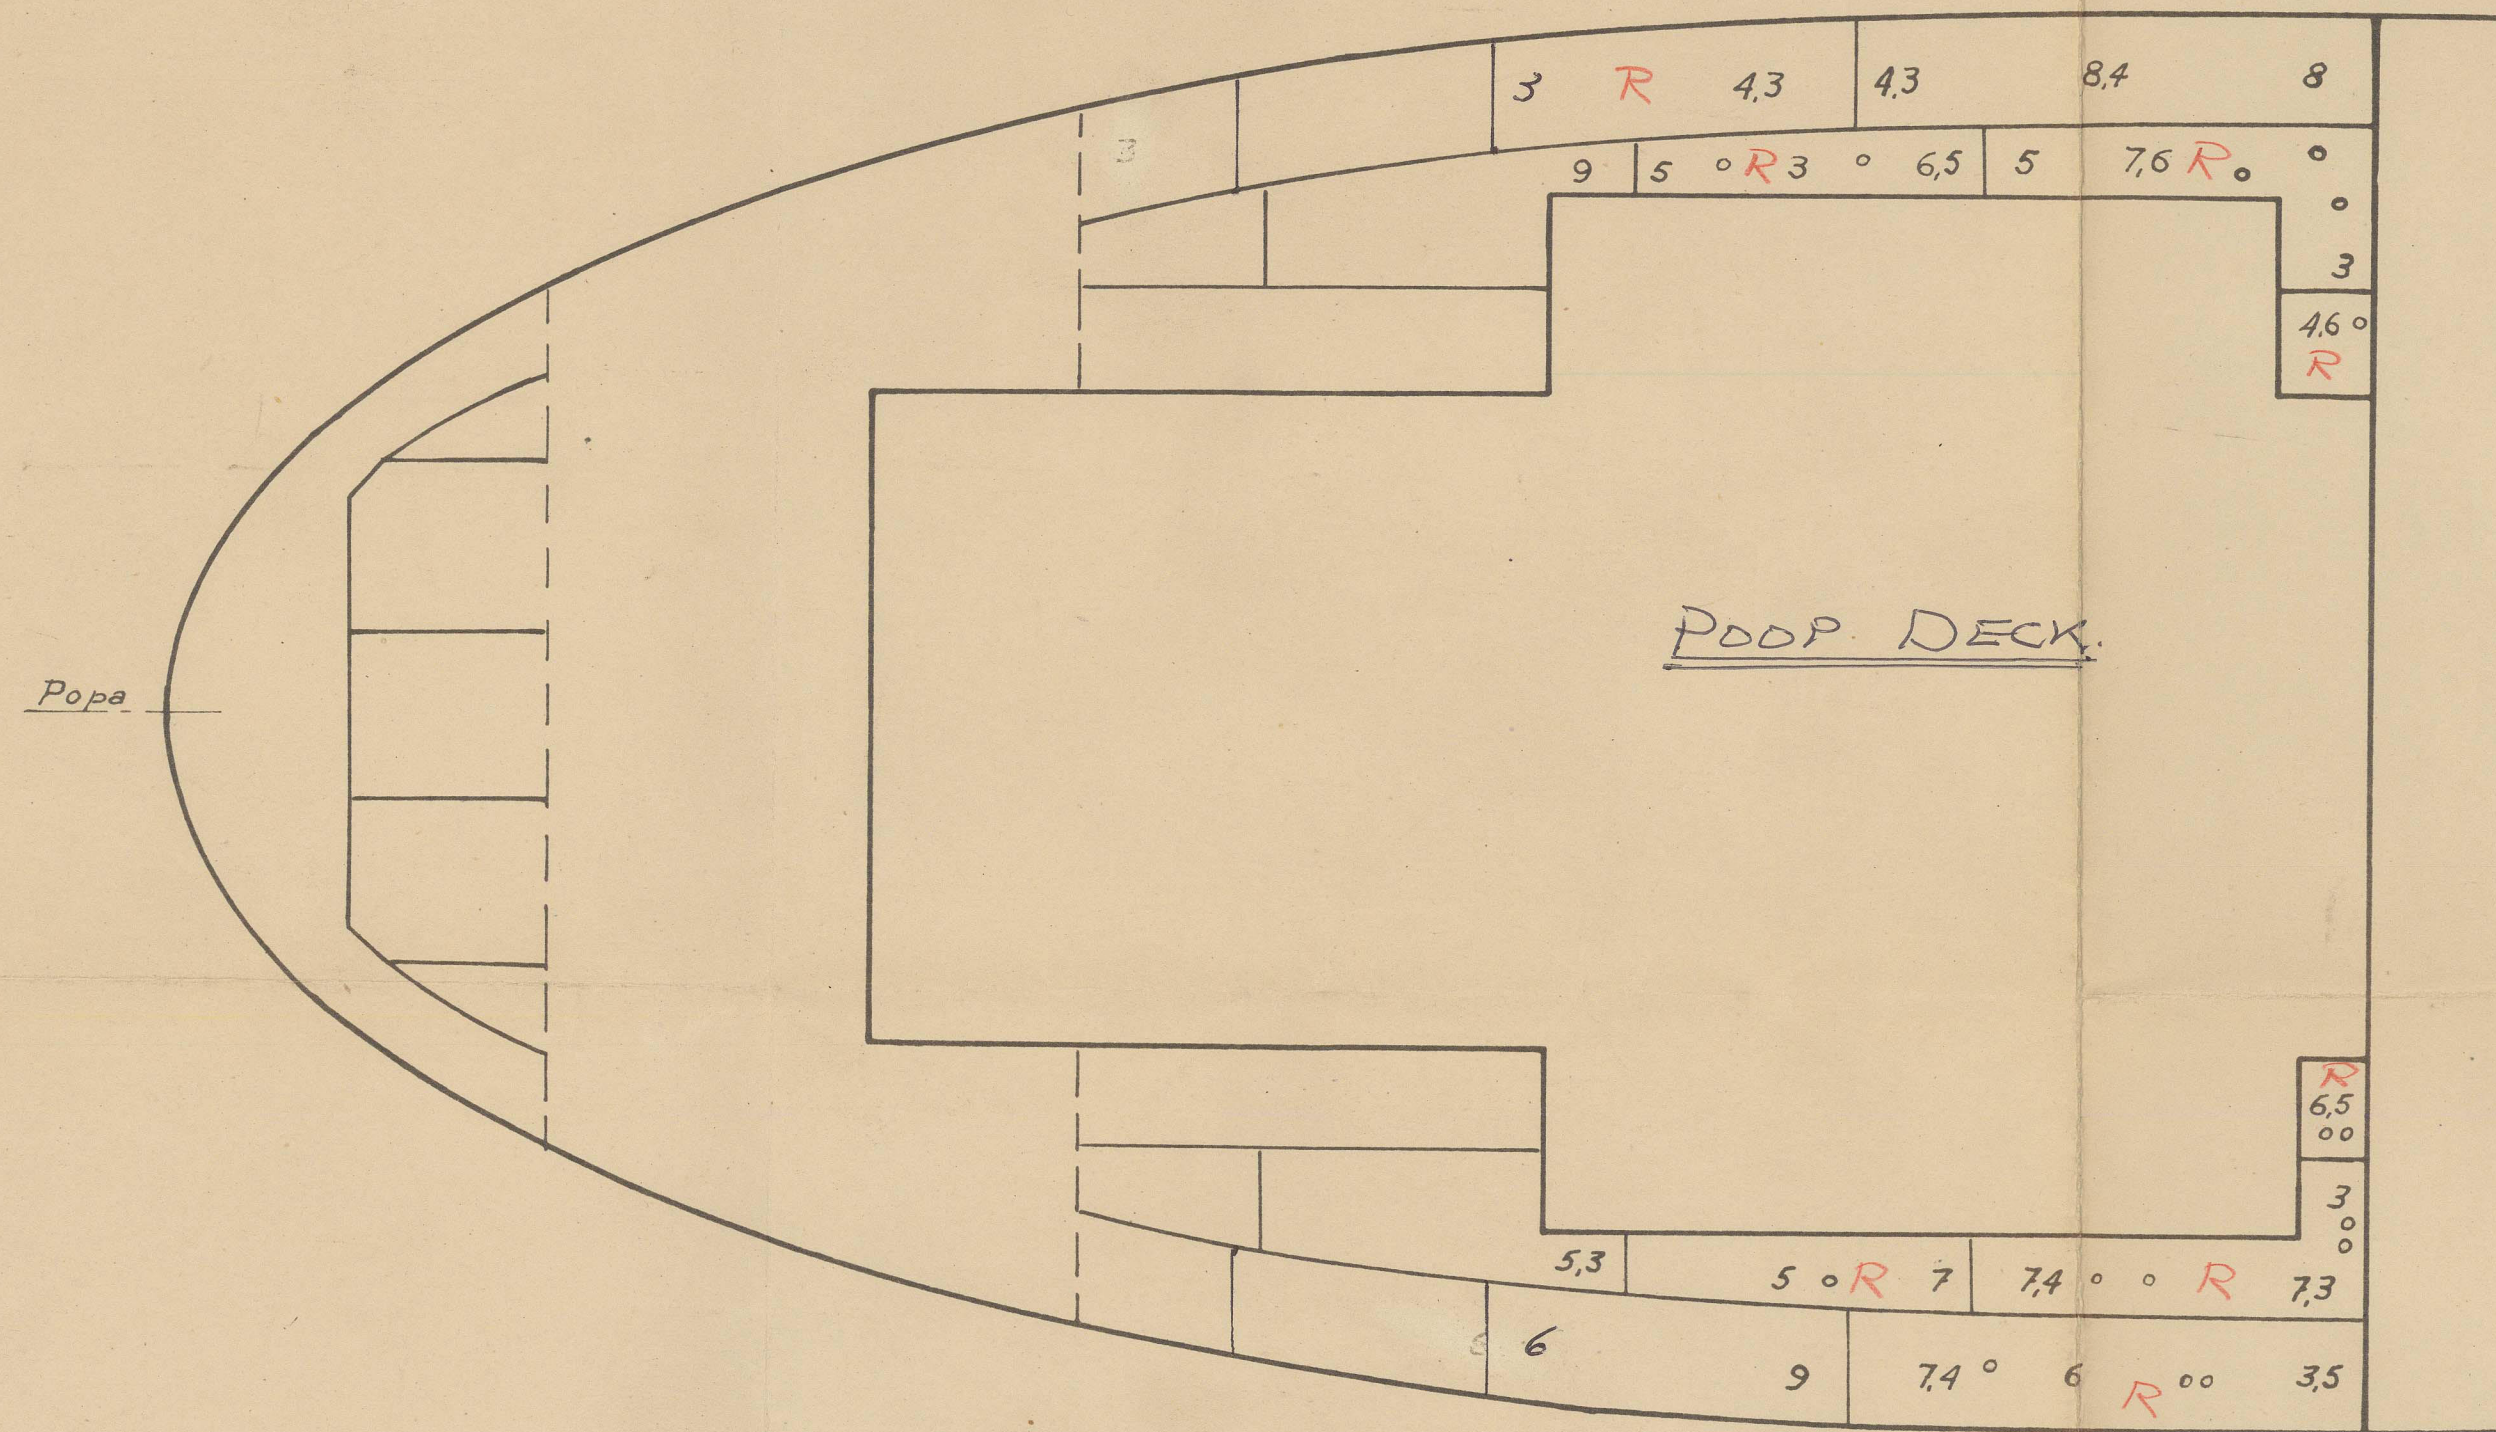

MAIN DECK

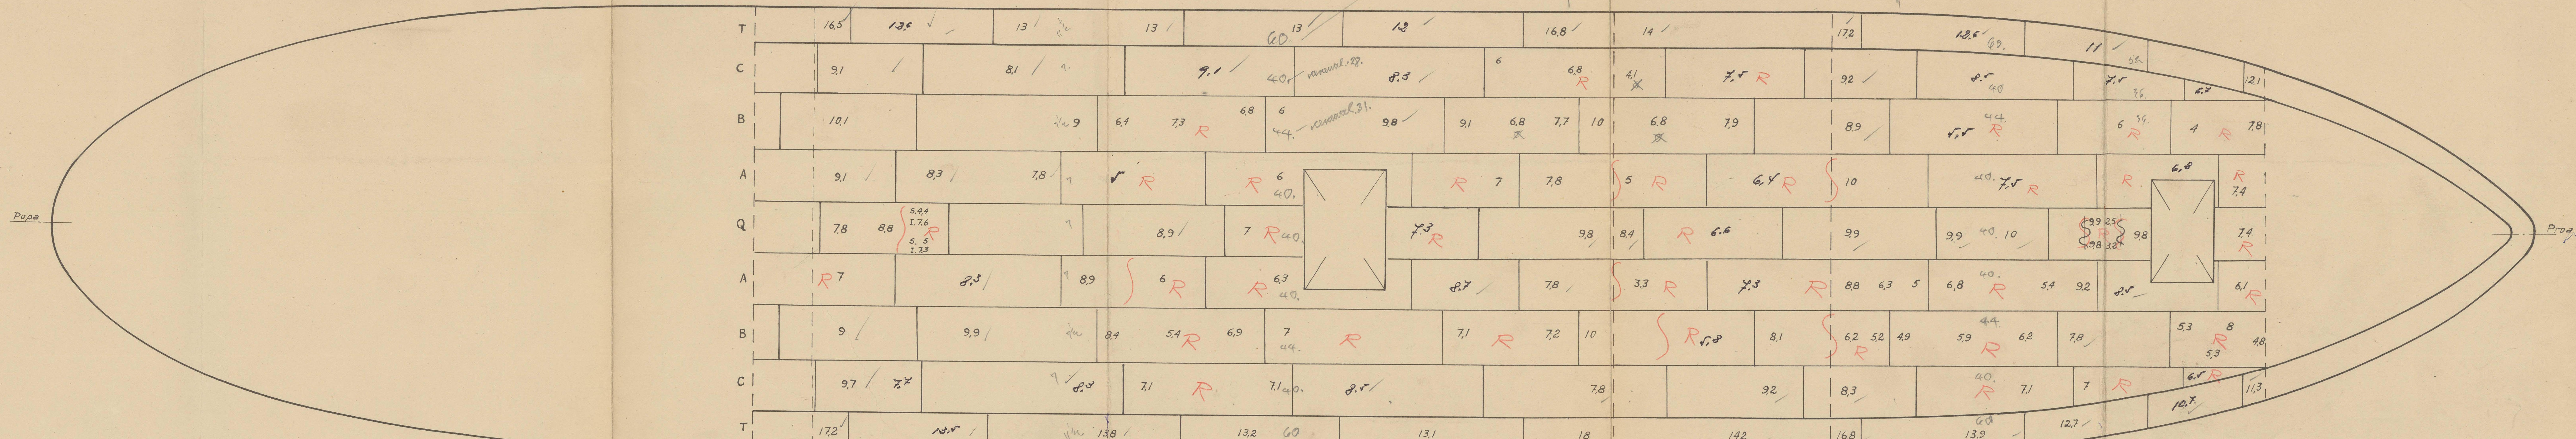

9 Mayo 1938 5070

B/T. "REMEDIOS"

MAIN DECK DRILLINGS

Cubierta Principal

Bch. 6837

9 - Mayo - 1958

5070

B/T. "REMEDIOS"

MAIN DECK DRILLINGS

Cubierta Principal

Bel. 6834



© 2021

Lloyd's Register
Foundation

005210 - 005218 - 0090