




PRINCIPAL DIMENSIONS.

LENGTH OVER ALL-----90'-0"
 LENGTH BETWEEN PERPENDICULARS-----70'-0"
 BREADTH MOULDED-----23'-0"
 DEPTH MOULDED-----12'-6"

FISH-SHOONER.

PROFIEL AND DECKPLAN.

SCALE 1/50 OF FULL SIZE.

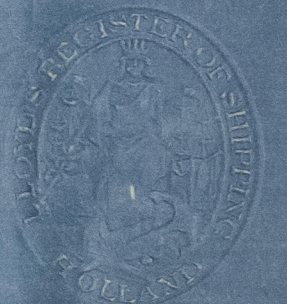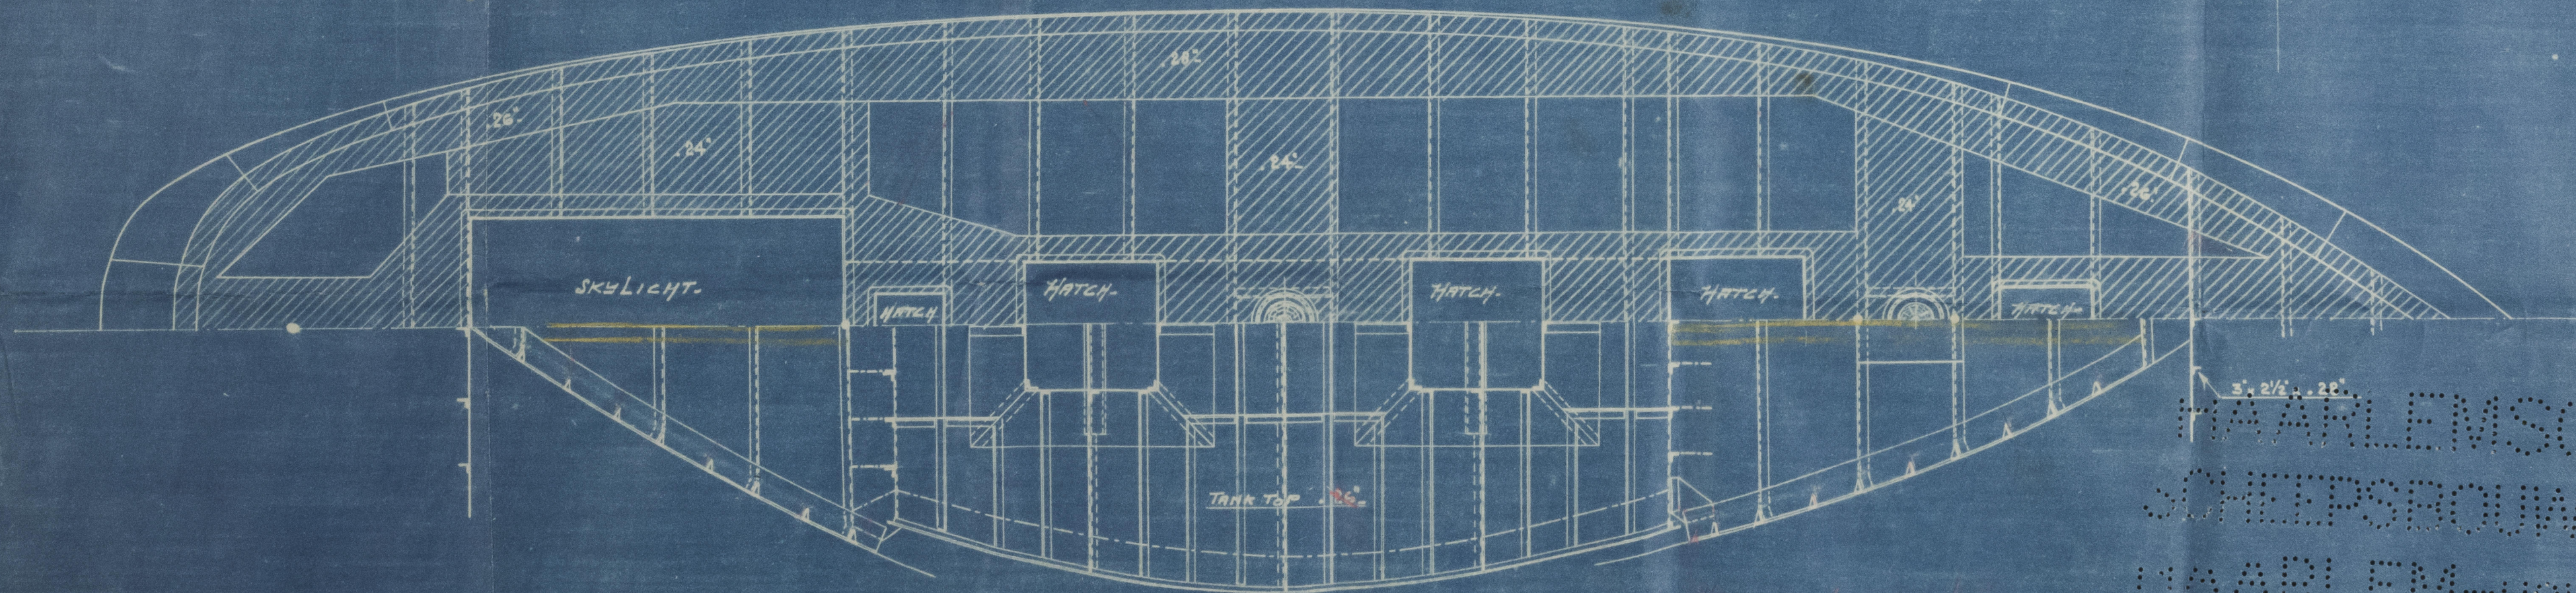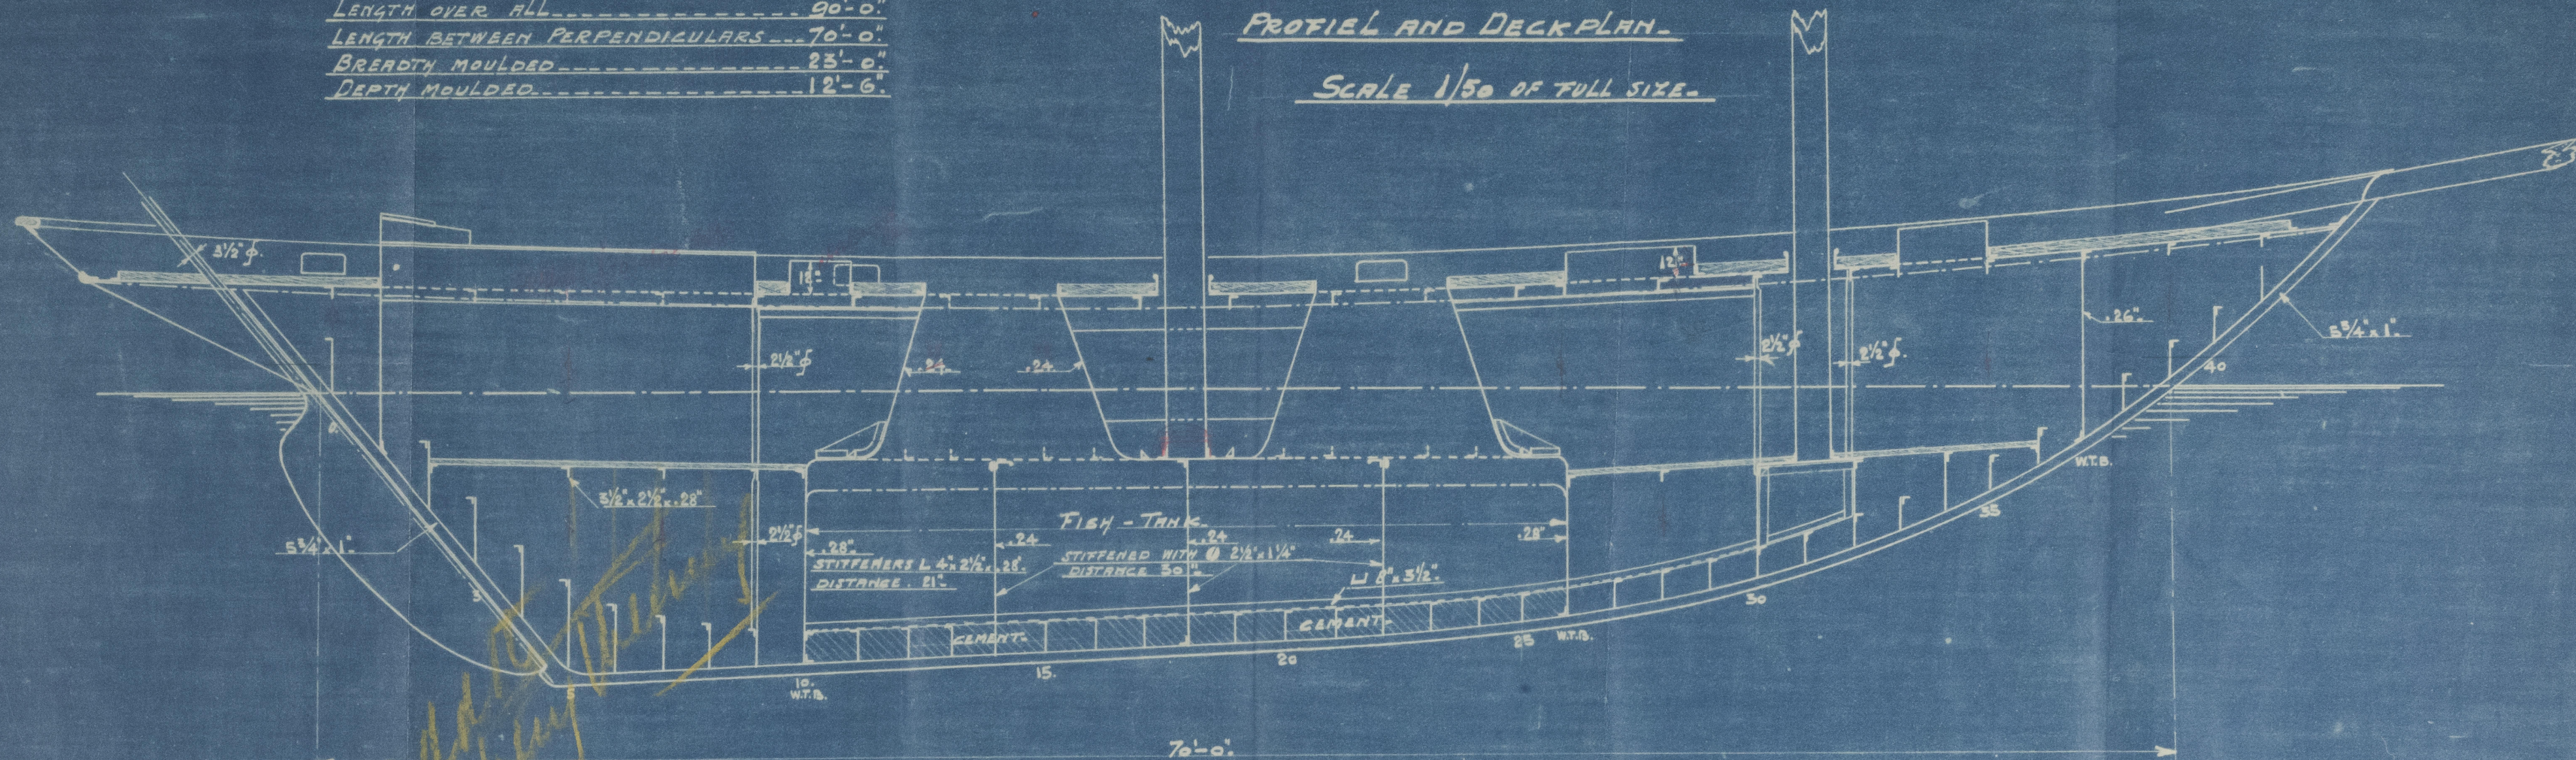

HAARLEMSCHE
 SCHEEPSBOUW-MY
 HAARLEM-HOLLAND



© 2021
 Lloyd's Register
 Foundation

The Haarlensche Scheepbouw Maats.
Laris No. 5.

Profile & Decks.

London

²
Don Julian

GEN. BOX NO 913.



© 2021

Lloyd's Register
Foundation

005219-005231-0224