

— S. S. No 100 —

MIDSHIP SECTION

— OF TWO —

STEEL SCREW TRAWLERS.

— DIMS: 120'-0" BP x 21'-6" x 12'-6" MLD. —

— TO CLASS 100 ALLOYS FOR FISHING PURPOSES —

SCALE 1/2" = 1 FOOT.

NUMERALS


HALF GIRTH	19.00'
BREADTH	10.75'
DEPTH	13.00'
1ST NO	42.75'
LENGTH	118.87'
2ND NO	5081.69'

$$\frac{L}{B} = 5.52$$

$$\frac{L}{D} = 9.14$$

EQUIPMENT No 5081

1 ANCHOR	5 1/4 CWTs	EX STOCK
1 "	4 3/4 "	" "
1 "	2 1/2 "	" "
30 FATHOMS	1" STUD LINK CHAIN	
60 "	6" HAWSER	
60 "	4 1/2" WARF	

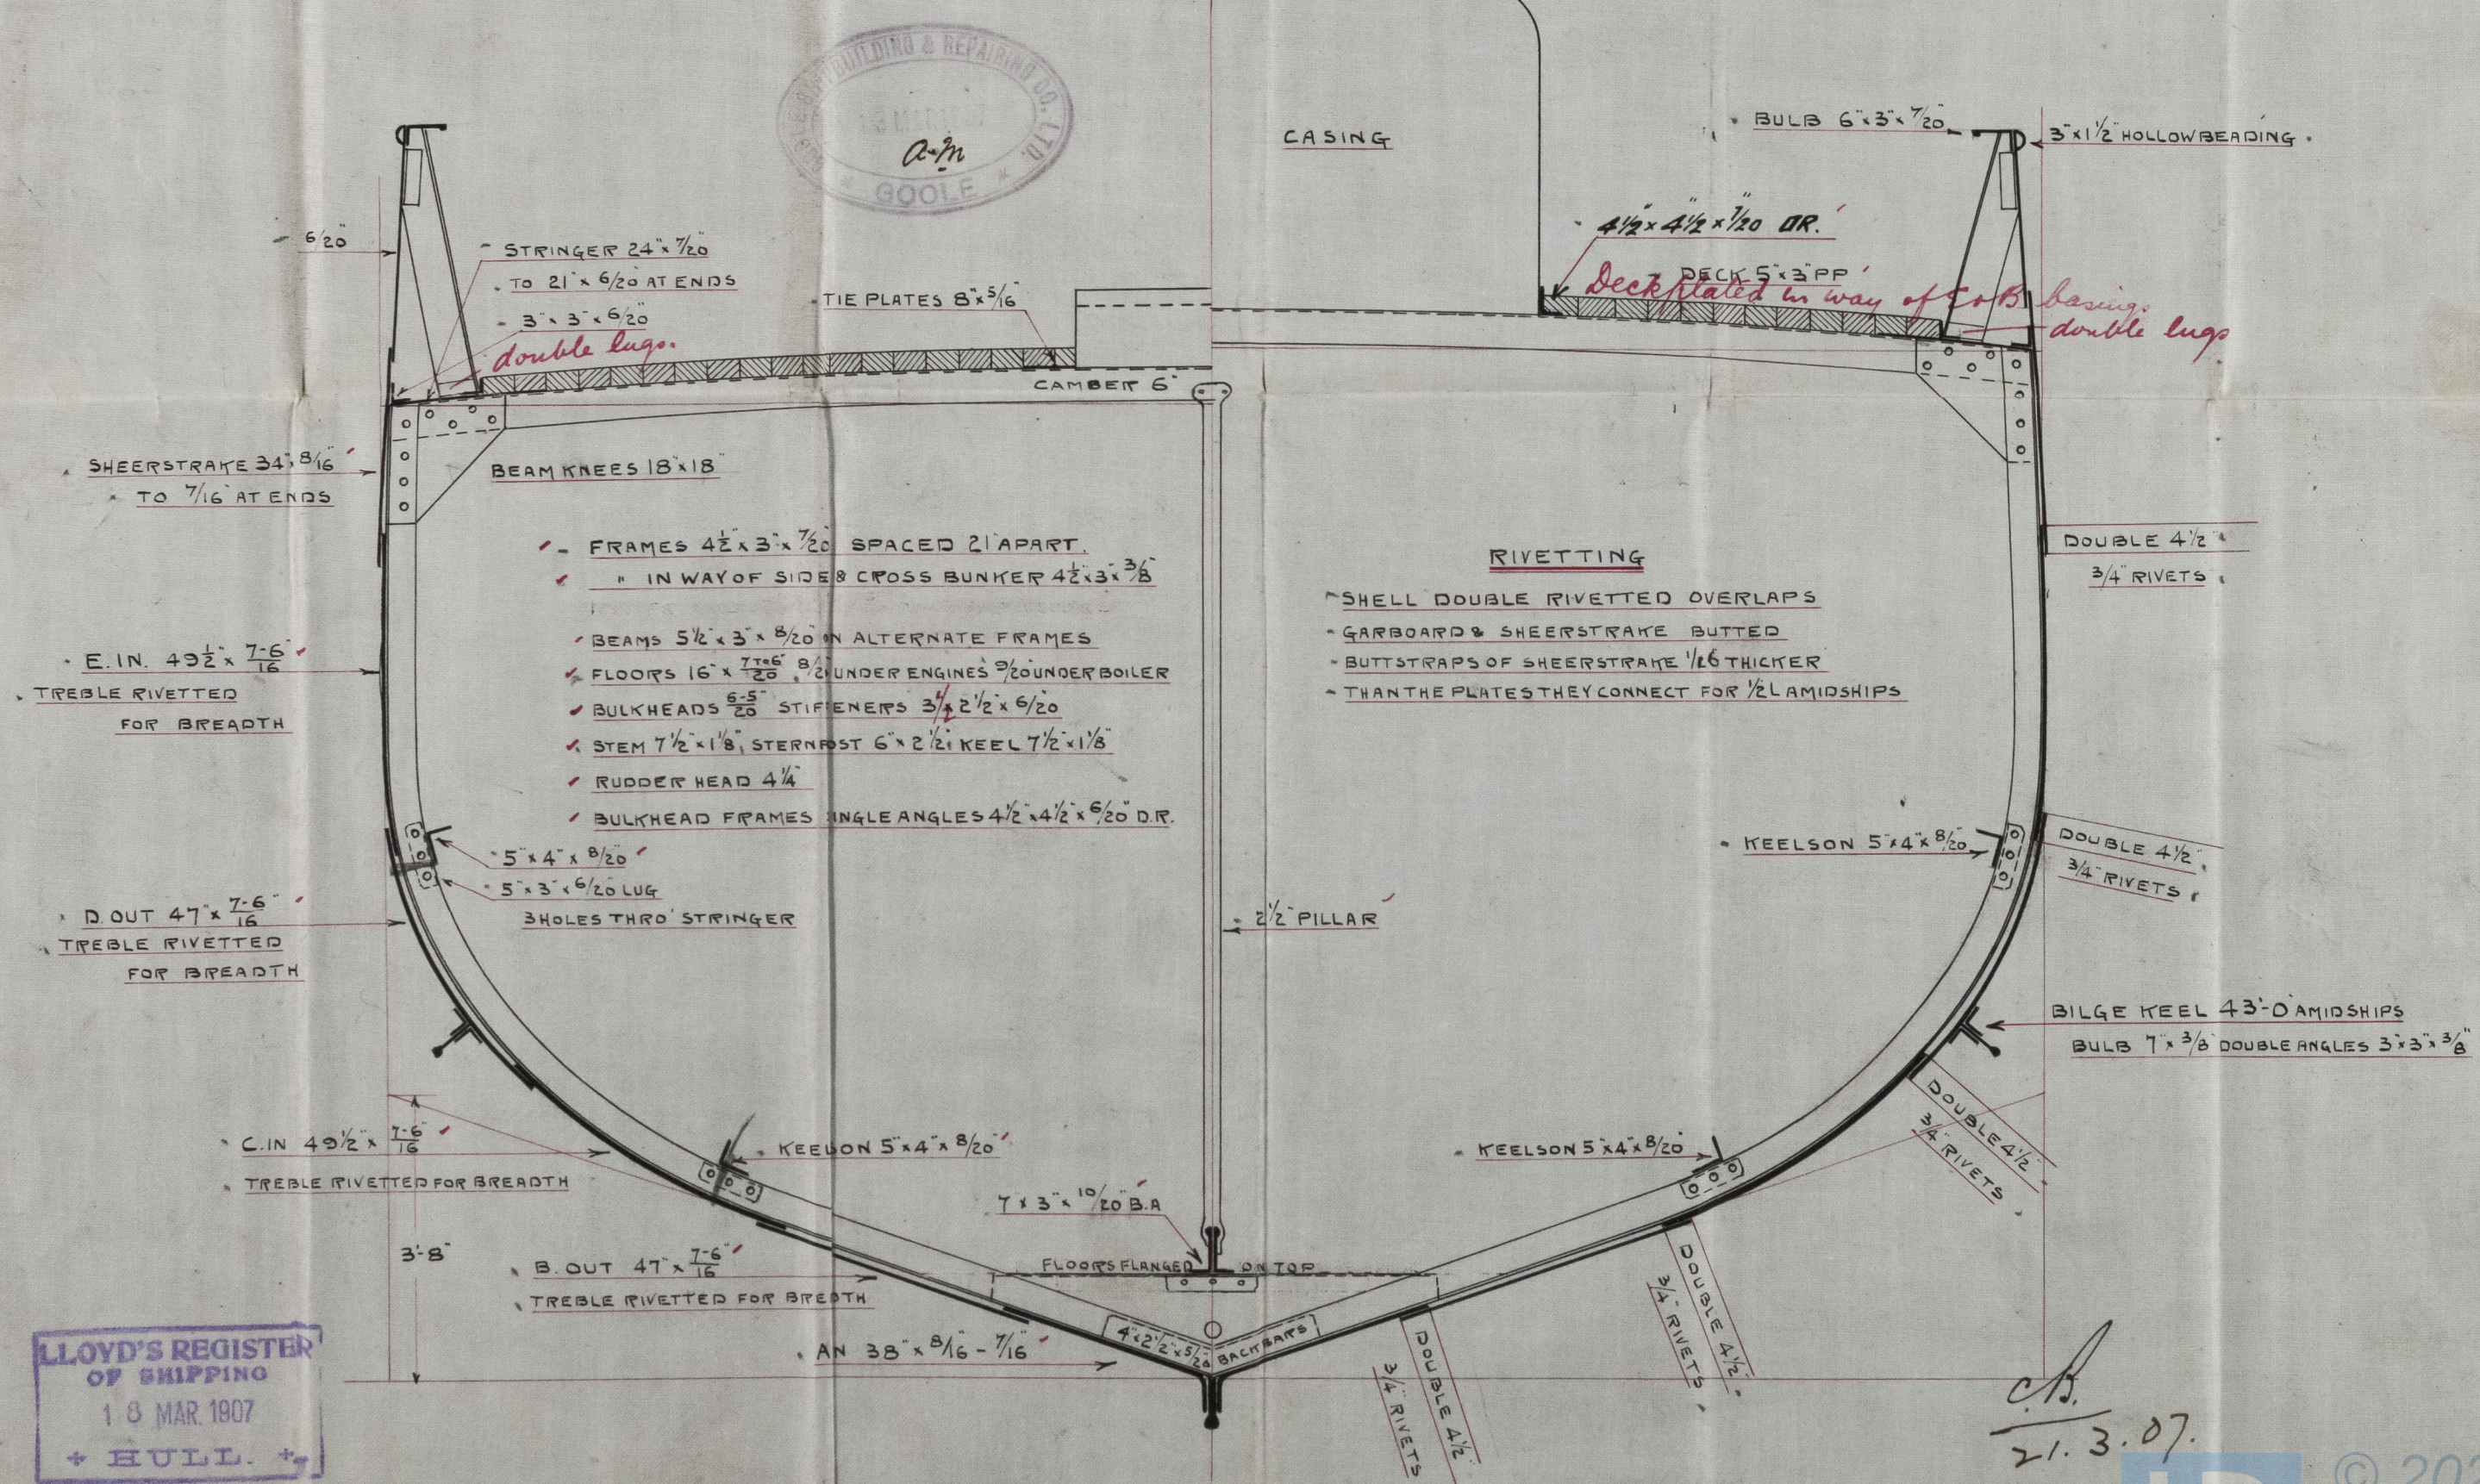

LLOYD'S REGISTER
OF SHIPPING
18 MAR 1907
+ HULL +

21.3.07.

Boole S. & R. Co. Ltd

No 100.

Midship Section.
S/s "Argon"

Hull. Report No 19440

© 2020

Lloyd's Register
Foundation

0600-897500-852540