

21.3.07.  
7.5.07.

—S. S. N° 100.—


—ELEVATION—

—DIMS: 120'-0" x 21'-6" x 12'-6" MOULDED—

—SCALE 1/4" = 1 FOOT—



PILLARS THROUGHOUT TO SATISFACTION OF  
SURVEYOR

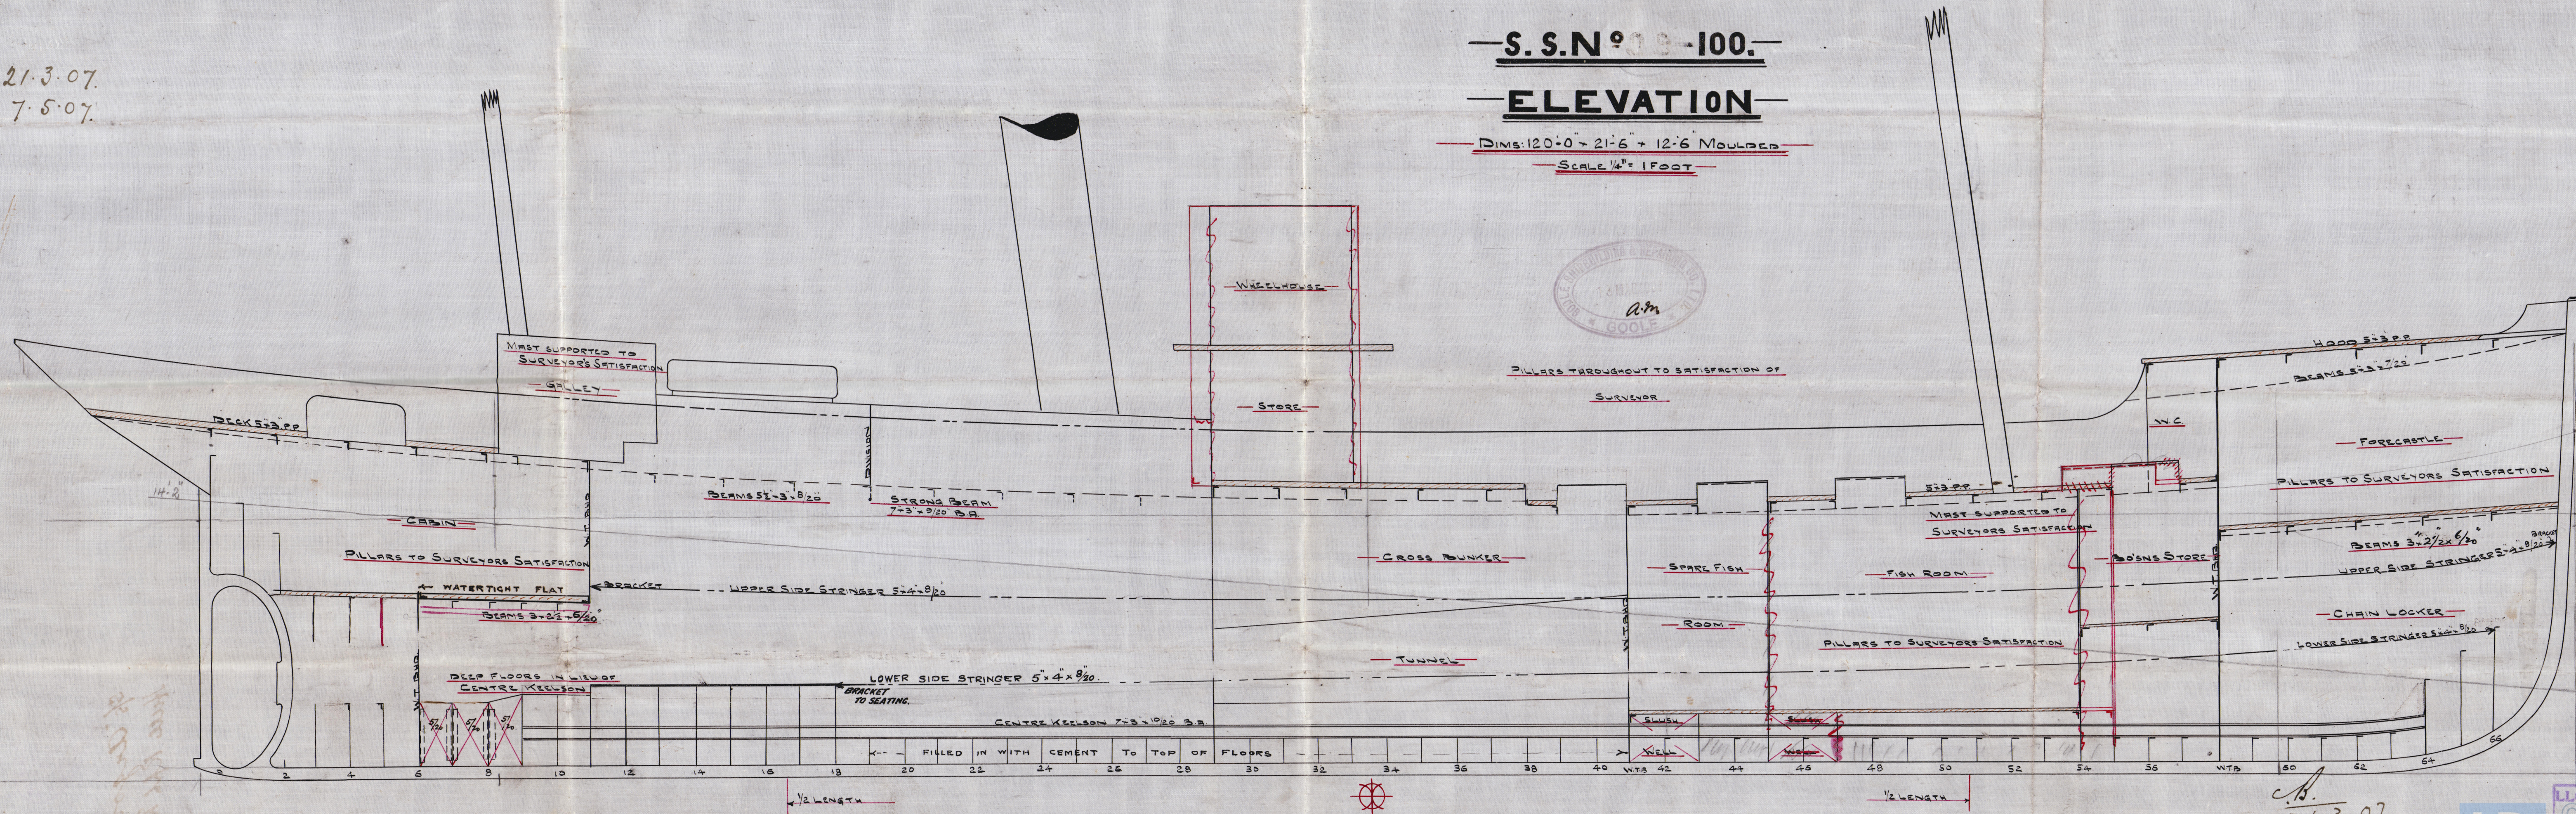


21.3.07.



Boole S. & R. C. Sim.

N. 100.

Profile.

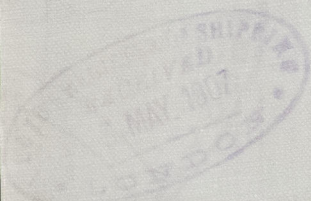

S/s 'Argow'  
Hull Rph No 19440



© 2020

Lloyd's Register  
Foundation

005258-005268-0071