

MIDSHIP SECTION

Nº 340

DIMENSIONS:- 117'-0" BP * 22'-6" EX * 14'-1" MLD.

SCALE $\frac{1}{2}" = 1 \text{ FOOT}$

CLASSED. 100. A.I. STEAM TRAWLER.

STEEL.

CASING AS PREVIOUSLY
APPROVED.

ANCHORS + CHAINS.

1 ANCHOR 5 $\frac{1}{4}$ CWT Ex Stock.


" 4 3/4 "

1 " 22 " " "

70 FATHOMS 1 STUD LINK CABLE
62 " 6" HAWES

60 4 1/2" WARD

12 MARK.

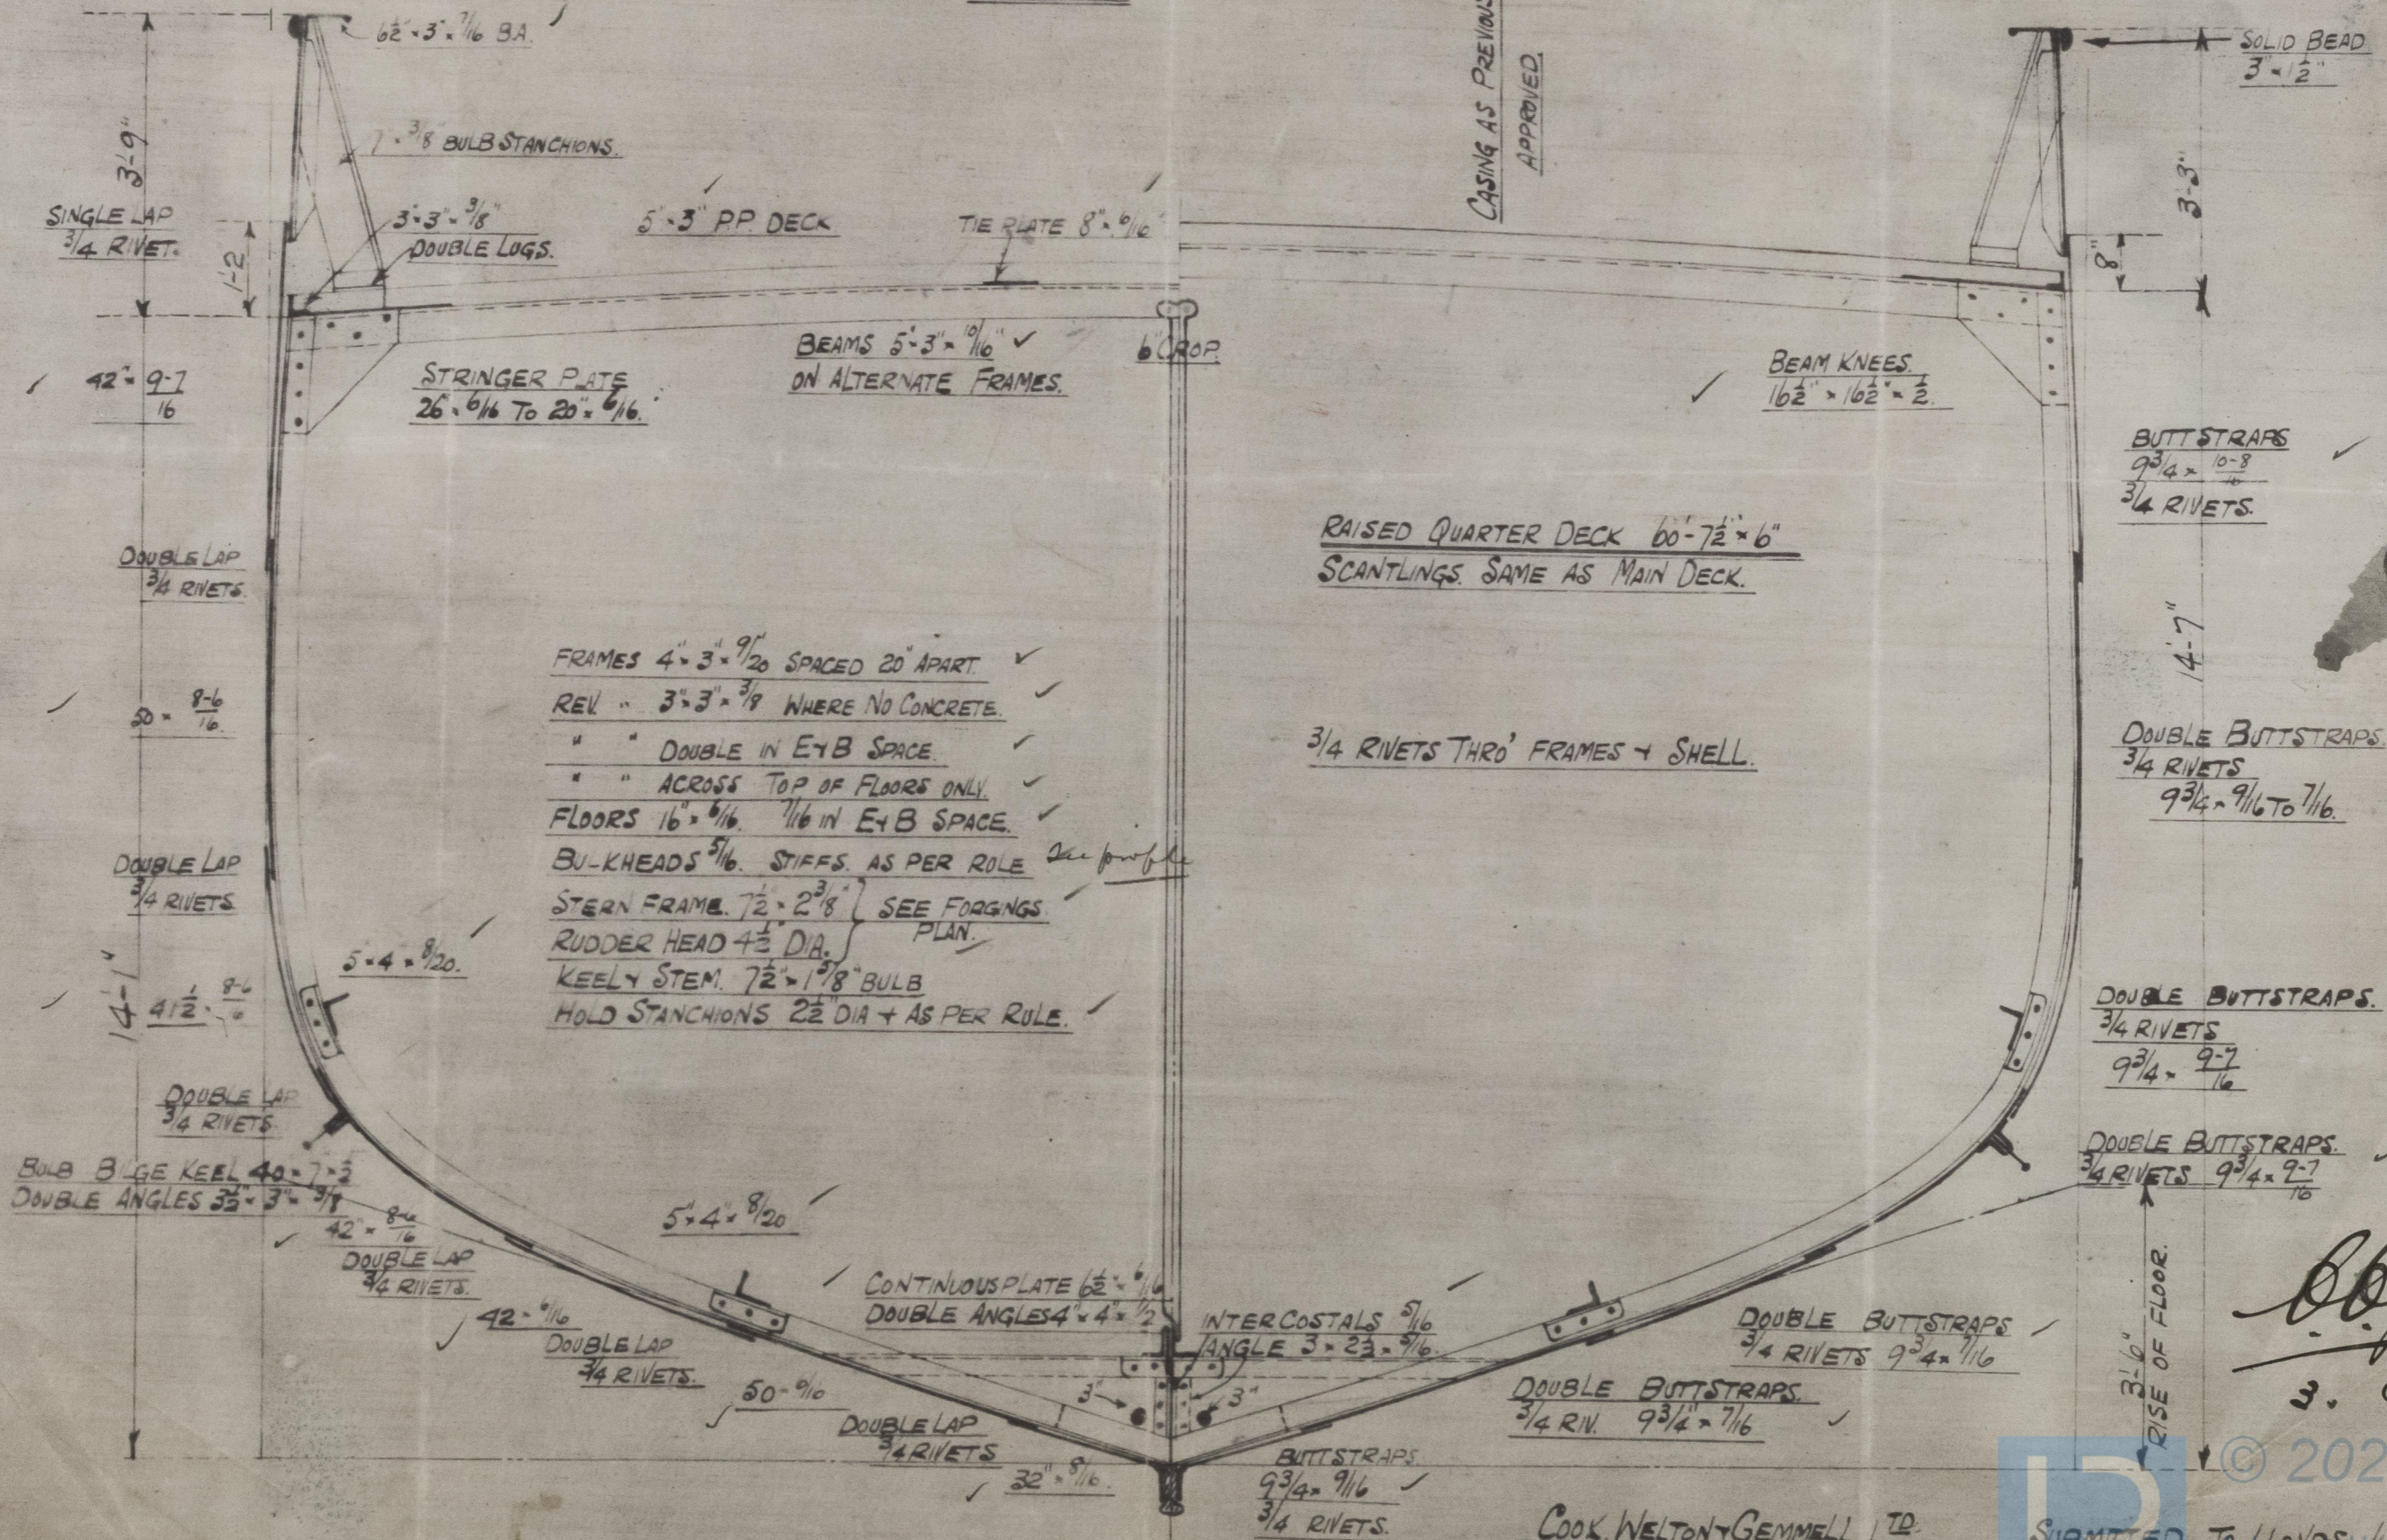

COOK. WELTON GEMMELL LTD.
SHIPBUILDERS
BEVERLEY.

SUBMITTED To LLOYDS JULY 15TH 1915
APPROVED BY



Foundation

005258-005268-0107


N^o 340

MIDSHIP SECTION

COOK WELTON & GEMMELL

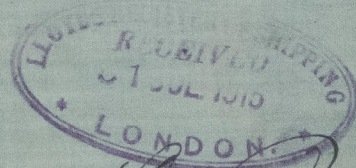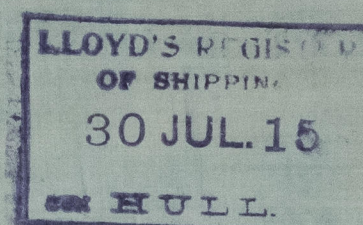

Walmont Hall 20th Nov 1915

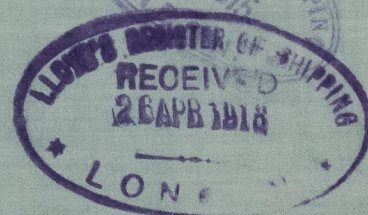

© 2020

Lloyd's Register
Foundation

005258-005268-0197