

[illegible]

PILLARING TO SURVEYORS SATISFACTION
SCALE $\frac{1}{4}'' = 1 \text{ FOOT.}$

N^o 340.

This is a detailed hand-drawn plan of a ship's hull, likely a small vessel or boat. The drawing shows the internal layout of the hull, including various compartments and structural details. Key features include:



- Structural Details:** The hull is divided into several sections by longitudinal and transverse lines. Dimensions are given for various parts, such as the width of the hull at different points (e.g., 6 1/16, 5 1/16, 7 1/16, 10 x 6 1/16) and the height of the hull (e.g., 2 1/2, 2 5/8, 2 1/2).
- Internal Compartments:** The hull is divided into several compartments, including:
 - Engine Compartment:** Located in the center of the hull, with a "SCARPH BEAM 6 1/2 x 2 1/16" and a "DOUBLE LAP" joint.
 - Boiler Compartment:** Located forward of the engine compartment, with a "TREBLE LAP" joint.
 - Hatch Compartments:** Three hatches are shown, each labeled "HATCH 3-5 x 3-4 18" ABOVE BEAMS".
 - Scuttle Compartments:** Three scuttles are shown, each labeled "SCUTTLE 5 1/16".
 - Entrance to Cabin:** Located at the stern of the hull.
- Other Features:**
 - Steel Skylight:** Located in the center of the hull, with dimensions 5-3 x 2-6 x 1-9.
 - Bunker Line:** A line indicating the location of the bunker.
 - Backbone:** A line indicating the location of the backbone.
 - Centre of Mast:** A point marked on the hull.

The drawing is signed "Cook, WELTON & GEMMELL LTD SHIPBUILDERS BEVERLEY" in the top right corner. There is also a signature "B.P." and the date "3.8.15" in the bottom right corner.

COOK WELTON & SEMMELL

N^o 340

PROFILE

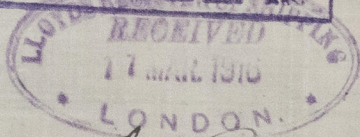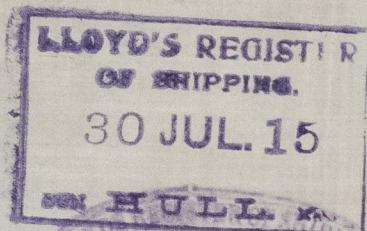

S. Dalton Tall Rpt No 29166



© 2020

Lloyd's Register
Foundation

8010-892500-852508