
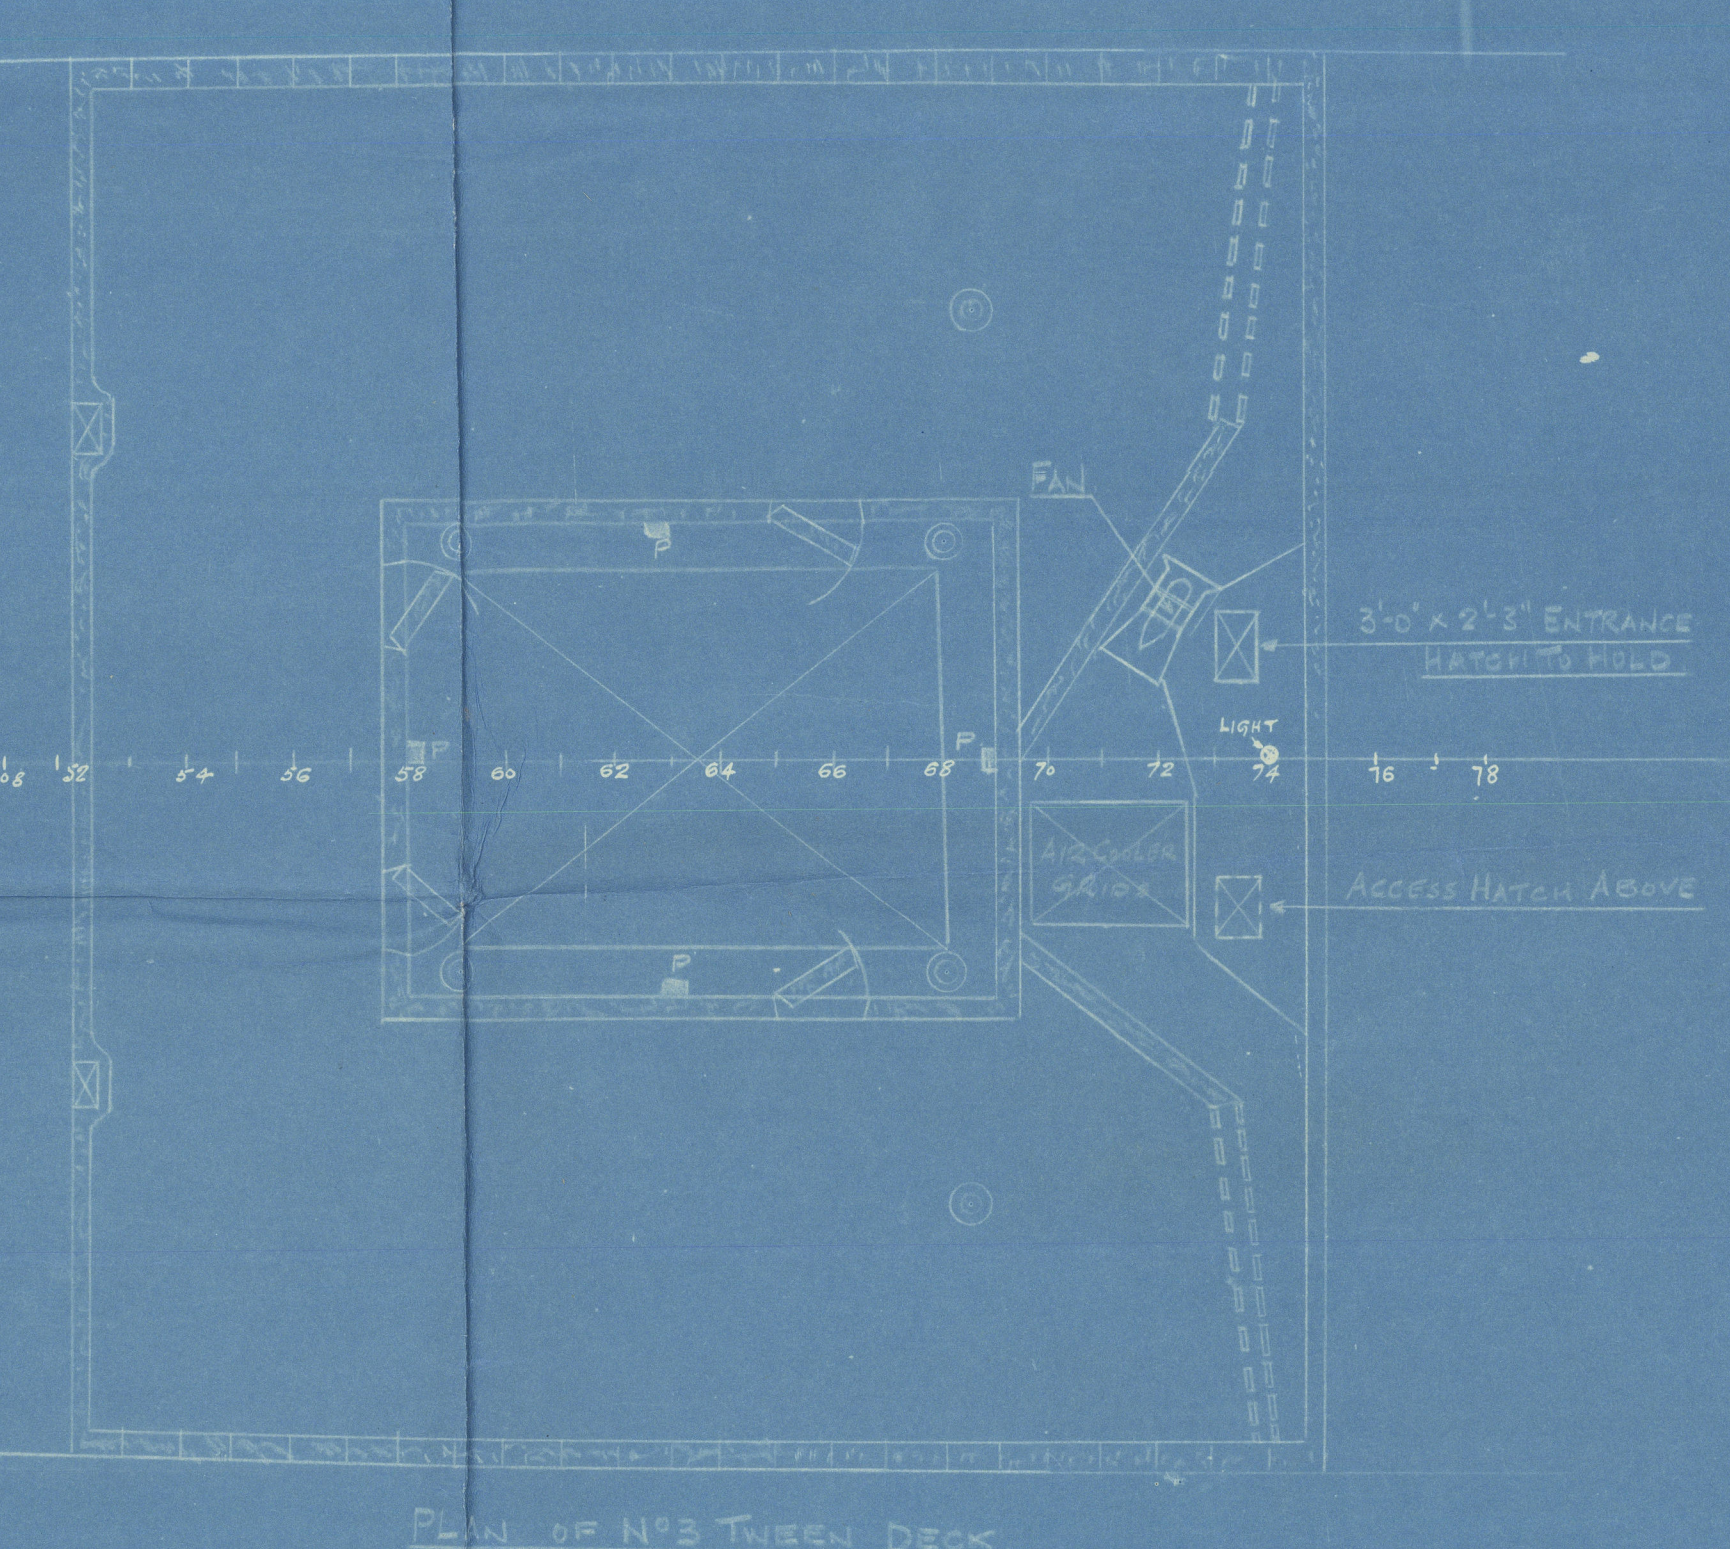
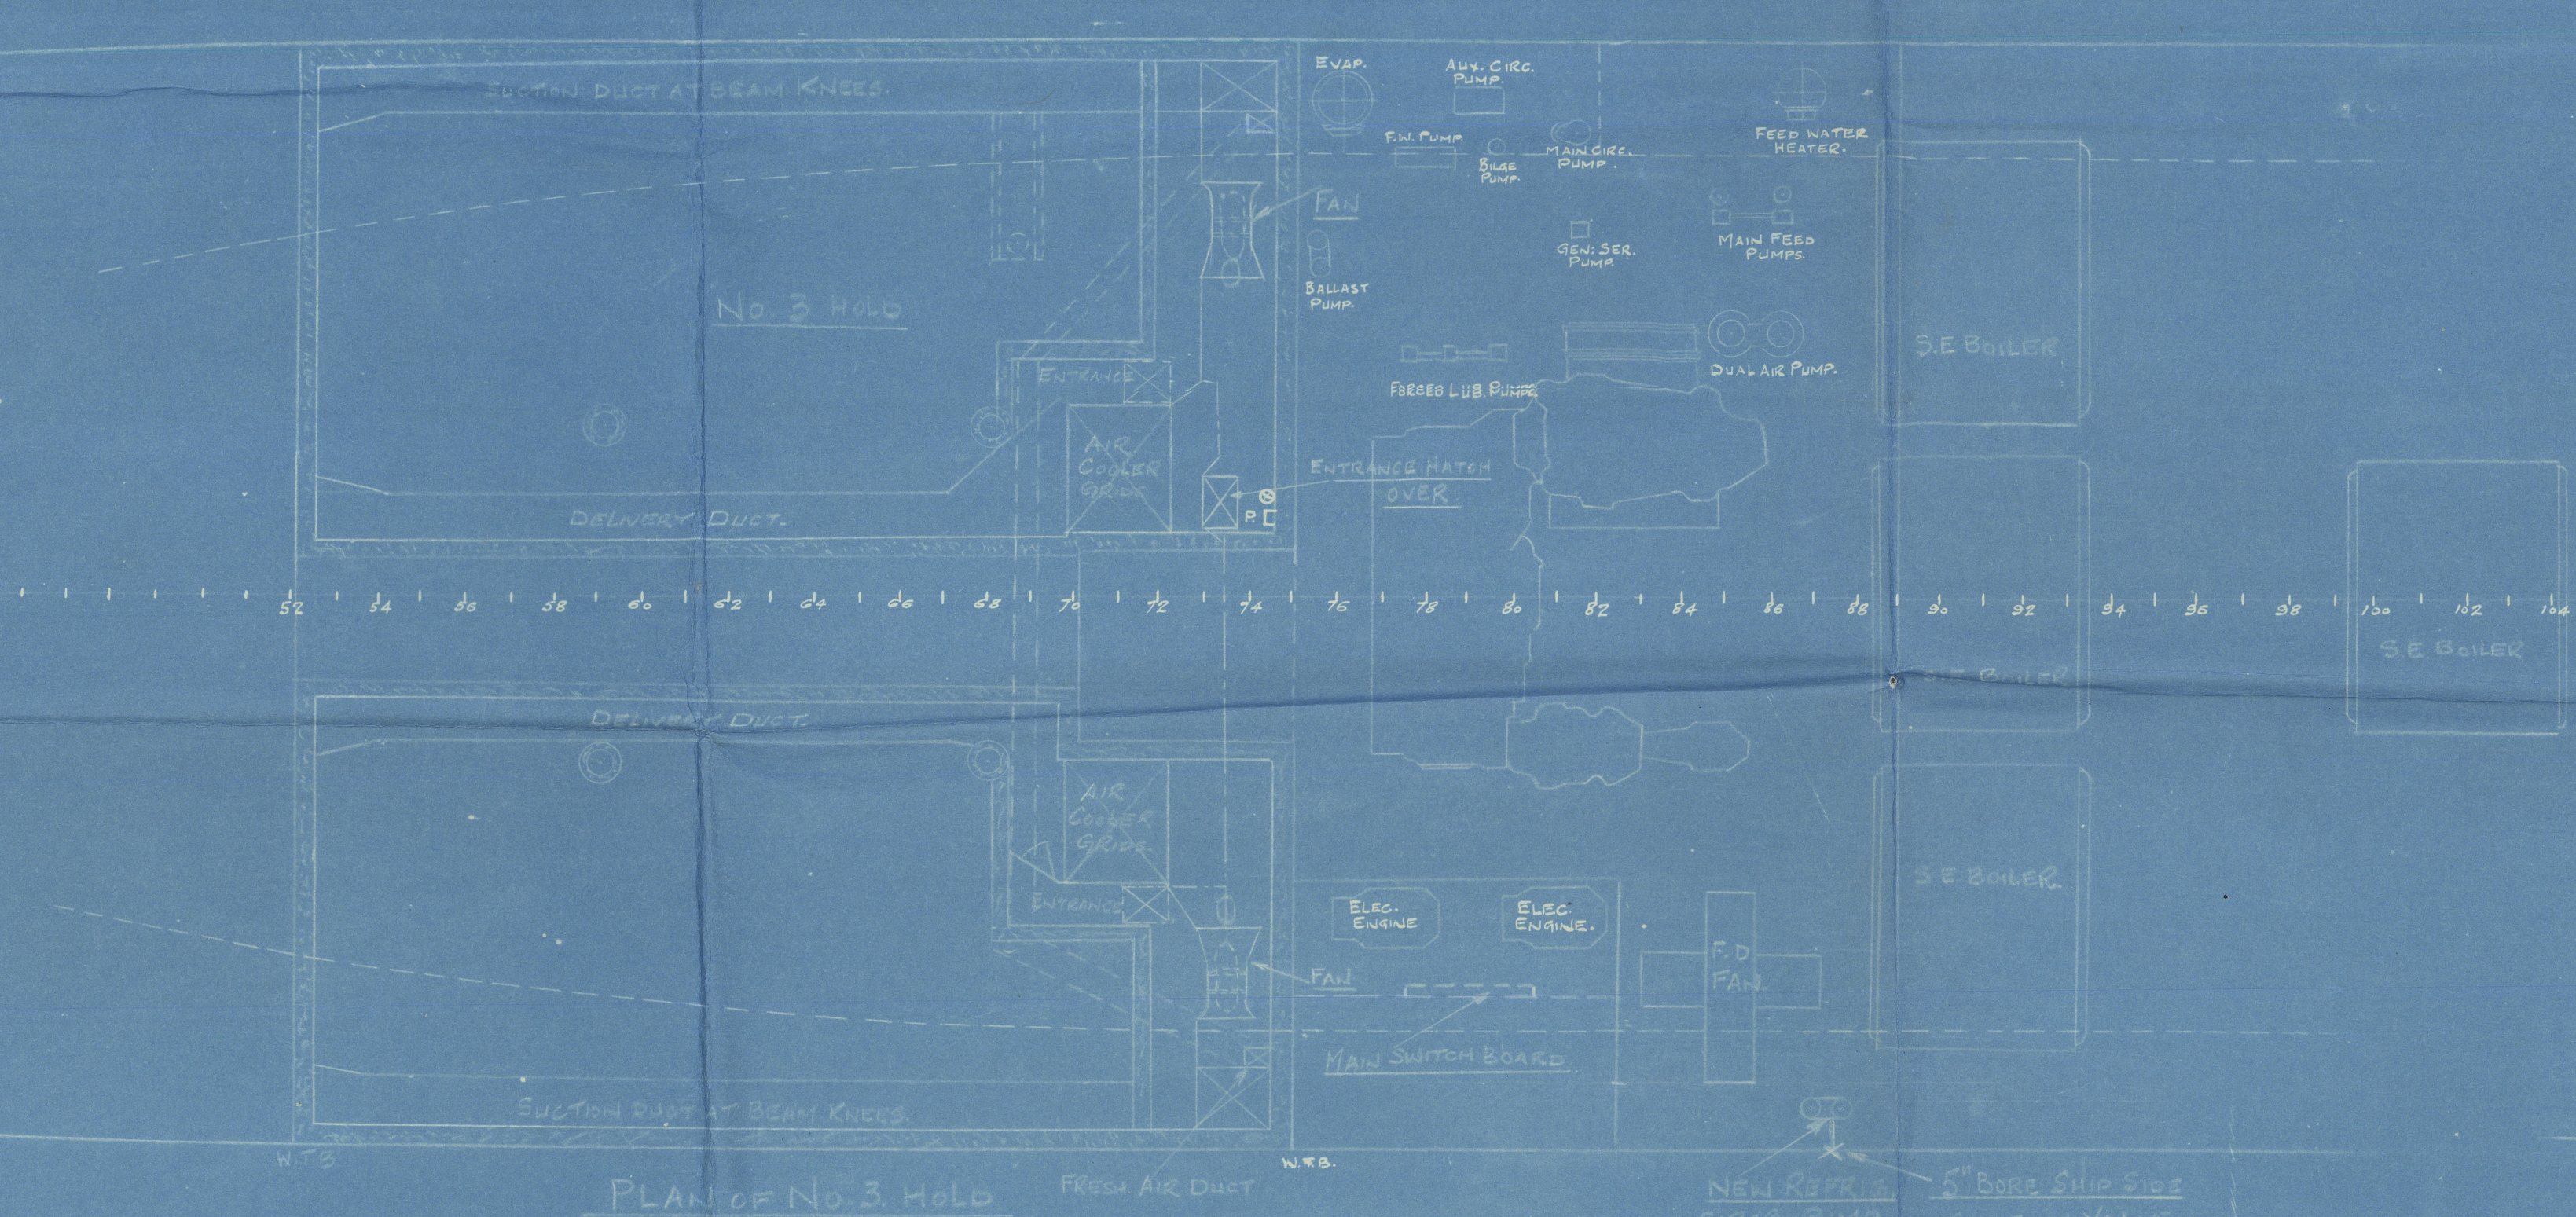
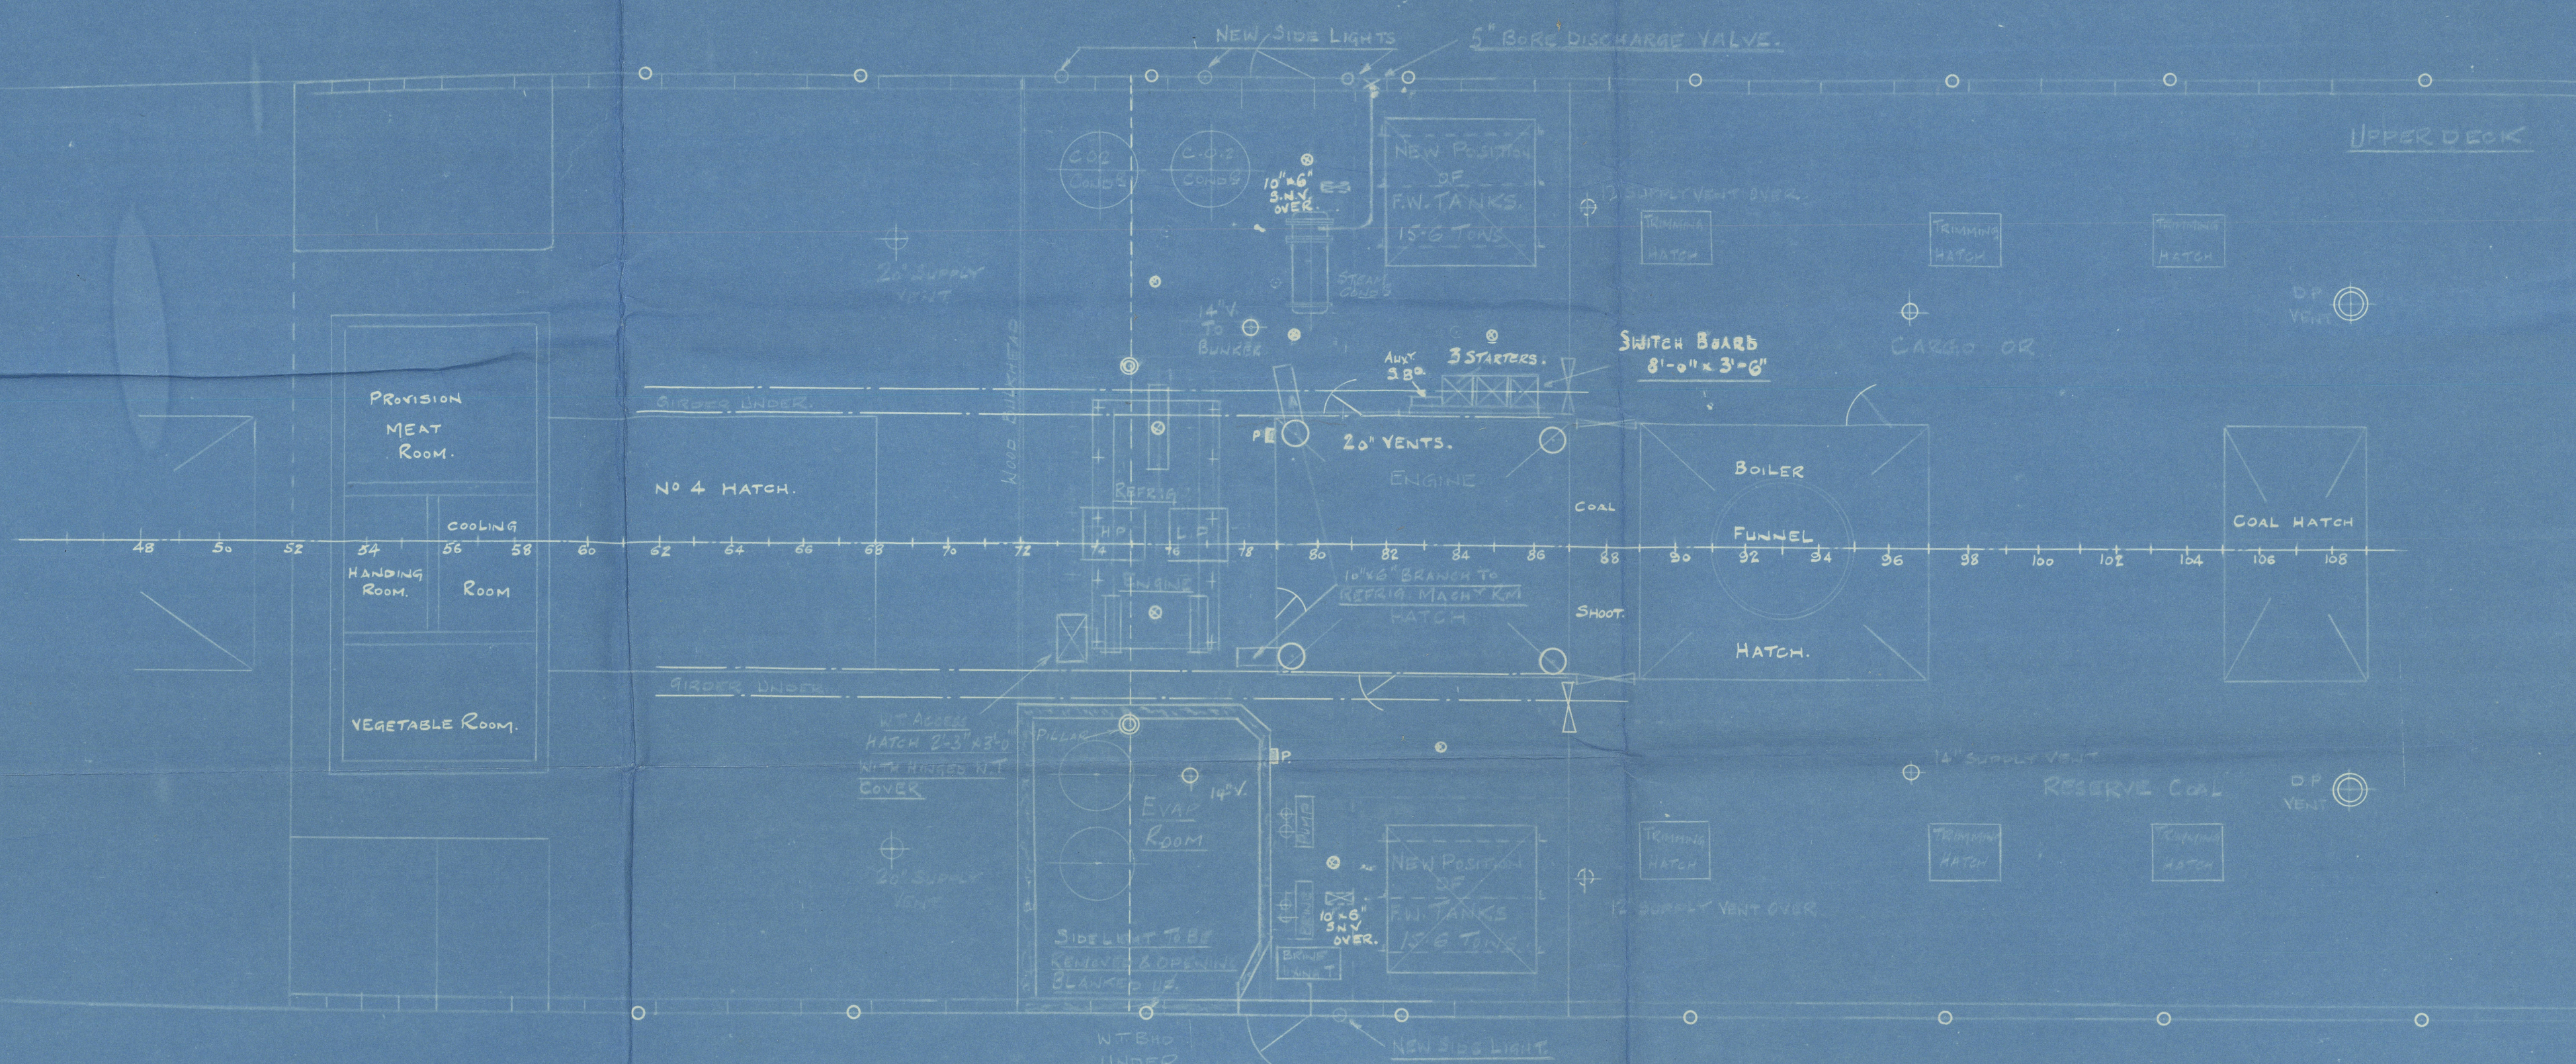


15/6/34

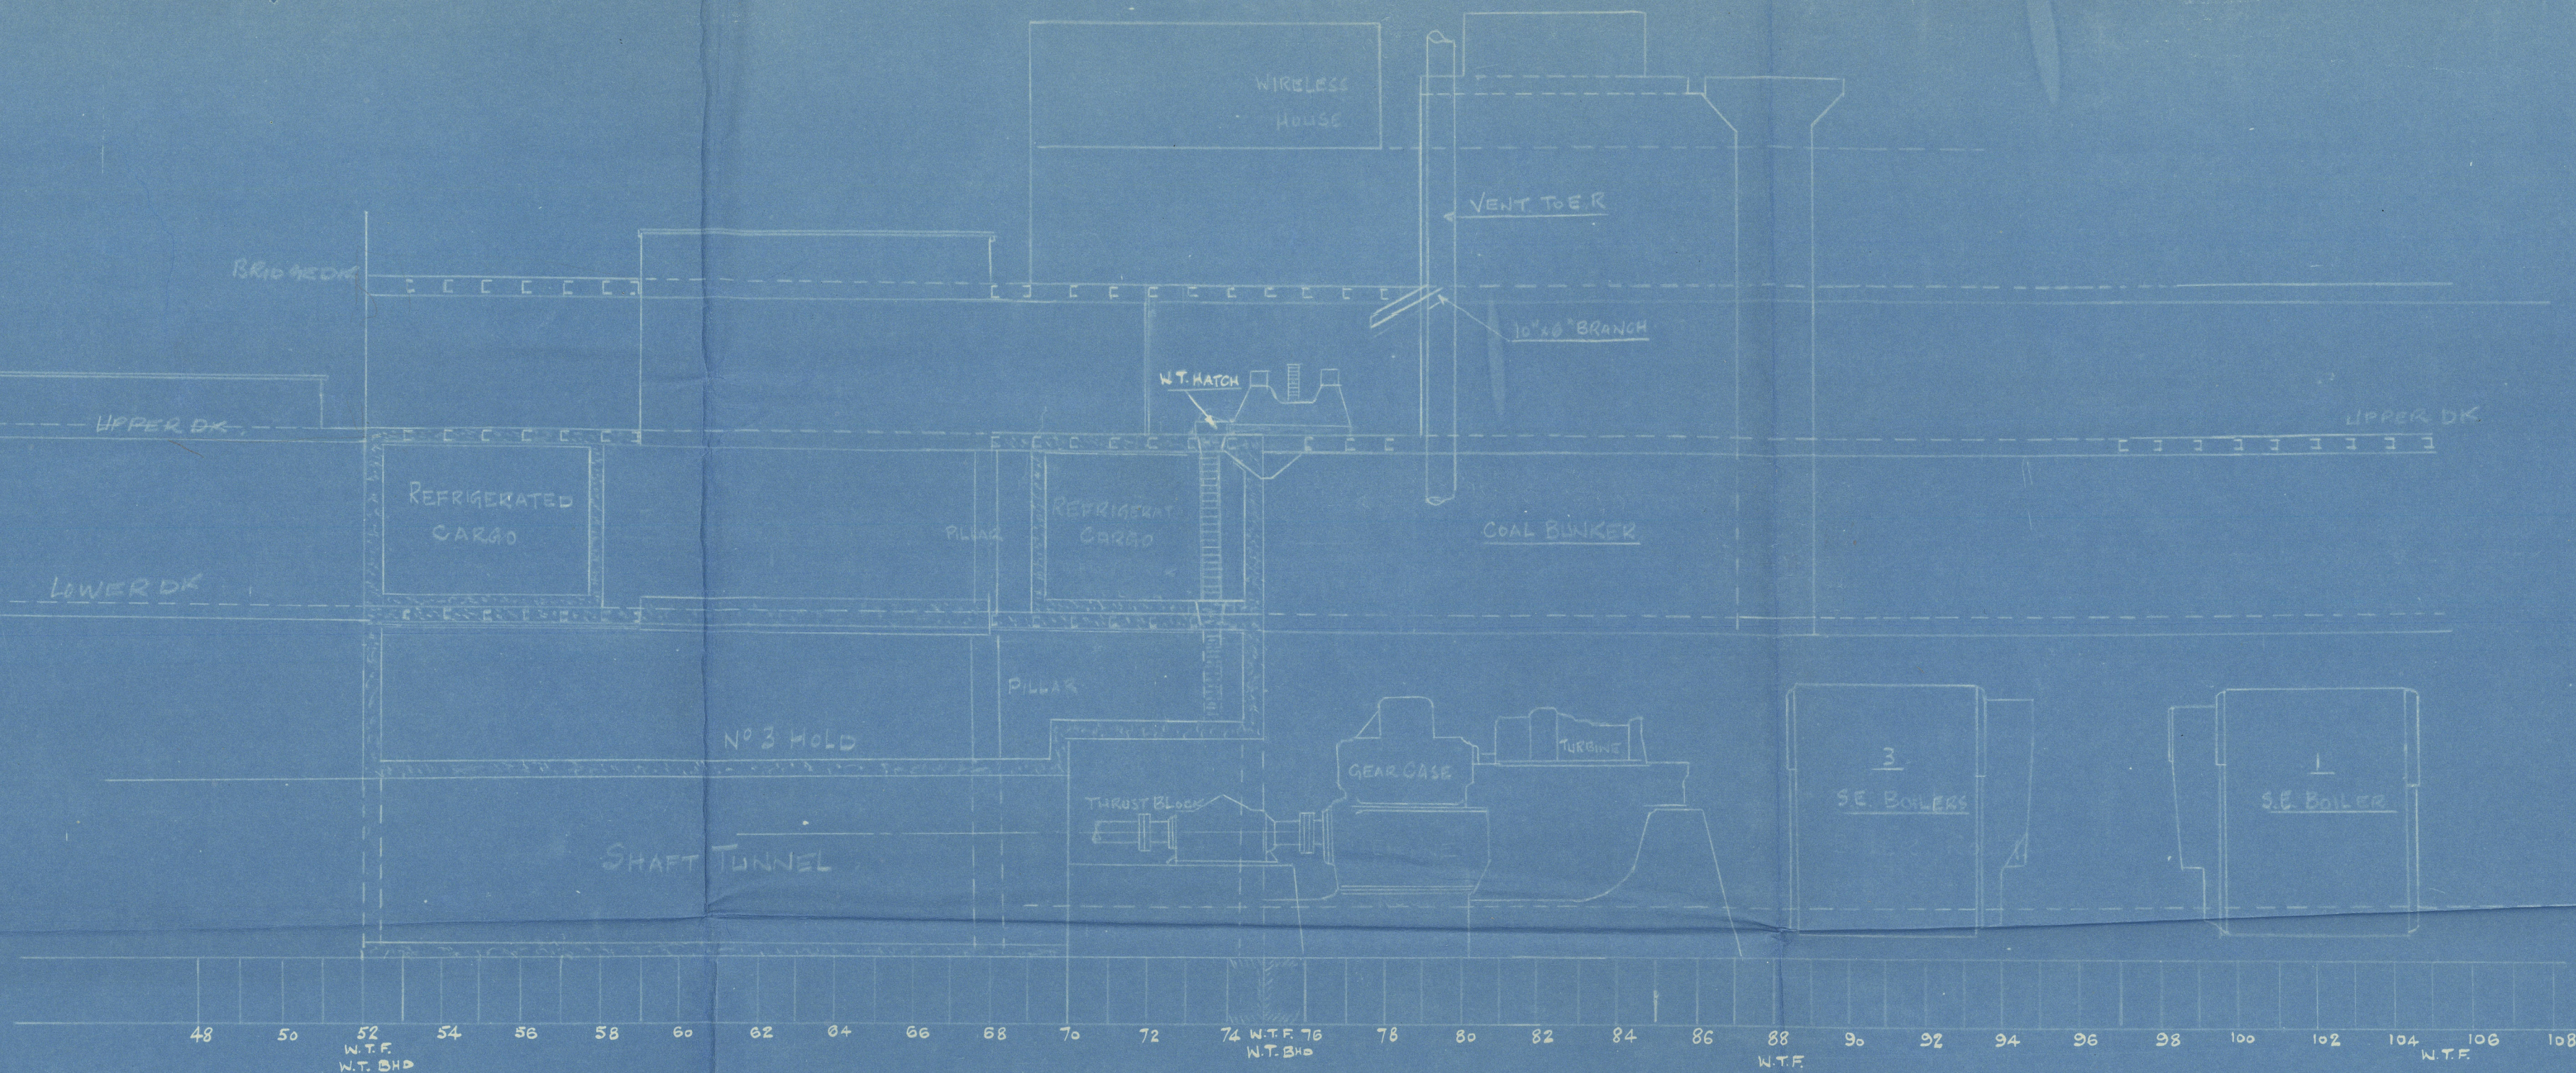

S.S. CALUMET.
 GENERAL ARRANGEMENT OF REFRIGERATION INSTALLATION
 SCALE 1/8" = 1'-0"
 ■ P — DENOTES PLUGS FOR ELECTRIC PORTABLE LIGHTS
 ○ — " ELECTRIC LIGHTS

ELDER ENGINEERING LTD.
SUPR. ENGINEERS
DRAWING OFFICE
DRAWING NO. A. 5351
WORKER NO. 21
DRAWN BY J.D.K.
DATE 23/5/34

The remaining requirements of the Rules for Refrigerating Machinery and Apparatus to be complied with.

Lloyd's Register Foundation

S.S. 'Calumet'

Plan of insulation

No 3 hold.

S.S. 'Calumet'

LIVERPOOL.

Report No. 104072

RMC. 50739



© 2020

005293-005300-0283

Lloyd's Register
Foundation