


SHIP NO. 350

— PROFILE & DECK PLAN. —

DIMENSIONS LENGTH BP 475'-0" BREADTH M^o 68'-0" DEPTH M^o 36'-0"

SCALE 1/8" = 1 FOOT

 


FURNESS. S. B. C^o L^{td}

N^o 350. SHIP.

PROFILE & DECKS
(AS FITTED)

"
S.S. ~~EMPIRE~~ COBBET "
MDB. RPT. No. 17394

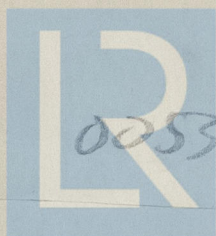

© 2021

005307-005307-005307-005307
Lloyd's Register
Foundation