

**MAIN DECK.**  
STRINGER BUTTS OVERLAPPED AND TREBLE RIVETED.  
ALL FORE-FT. BUTTS OF DECK PLATING OVERLAPPED  
AND DOUBLE RIVETED FOR 1/2 LENGTH.  
REMAINDER SINGLE RIVETED.  
STRINGER PLATE 72 3/4" x 44" TO 35" x 44" IN BRIDGE  
EXCEPT IN WAY OF HATCHWAYS.

**UPPER DECK.**  
STRINGER BUTTS OVERLAPPED & QUADRUPE RIVETED  
FOR 1/2 L. OUTSIDE BRIDGE. REMAINDER TREBLE RIVETED.  
BUTTS OF DECK PLATING OVERLAPPED & DOUBLE RIVETED  
FOR 1/2 L. REMAINDER SINGLE RIVETED.  
STRINGER PLATE 61 1/2" x 6" TO 35" x 44" 48 IN BRIDGE  
EXCEPT IN WAY OF HATCHWAYS.

**BRIDGE DECK.**  
STRINGER BUTTS OVERLAPPED AND TREBLE RIVETED.  
BUTTS OF DECK PLATING OVERLAPPED & DOUBLE RIVETED.  
STRINGER PLATE 60" x 54".

# DECK PLATING PLAN.

N<sup>o</sup> 400-1.55

SCALE 1/8" = 1 FOOT.

N<sup>o</sup> 406

10.4.03

APPROVED

APPROVED

LLOYD'S REGISTER OF SHIPPING



LLOYD'S REGISTER OF SHIPPING

Montgomery per 4/11/26

Montgomery per 4/11/26

DATE 21.10.26

DATE 21.10.26

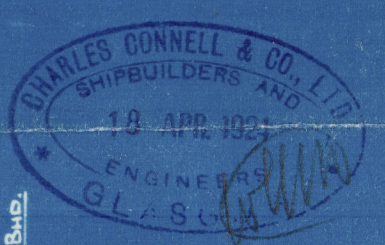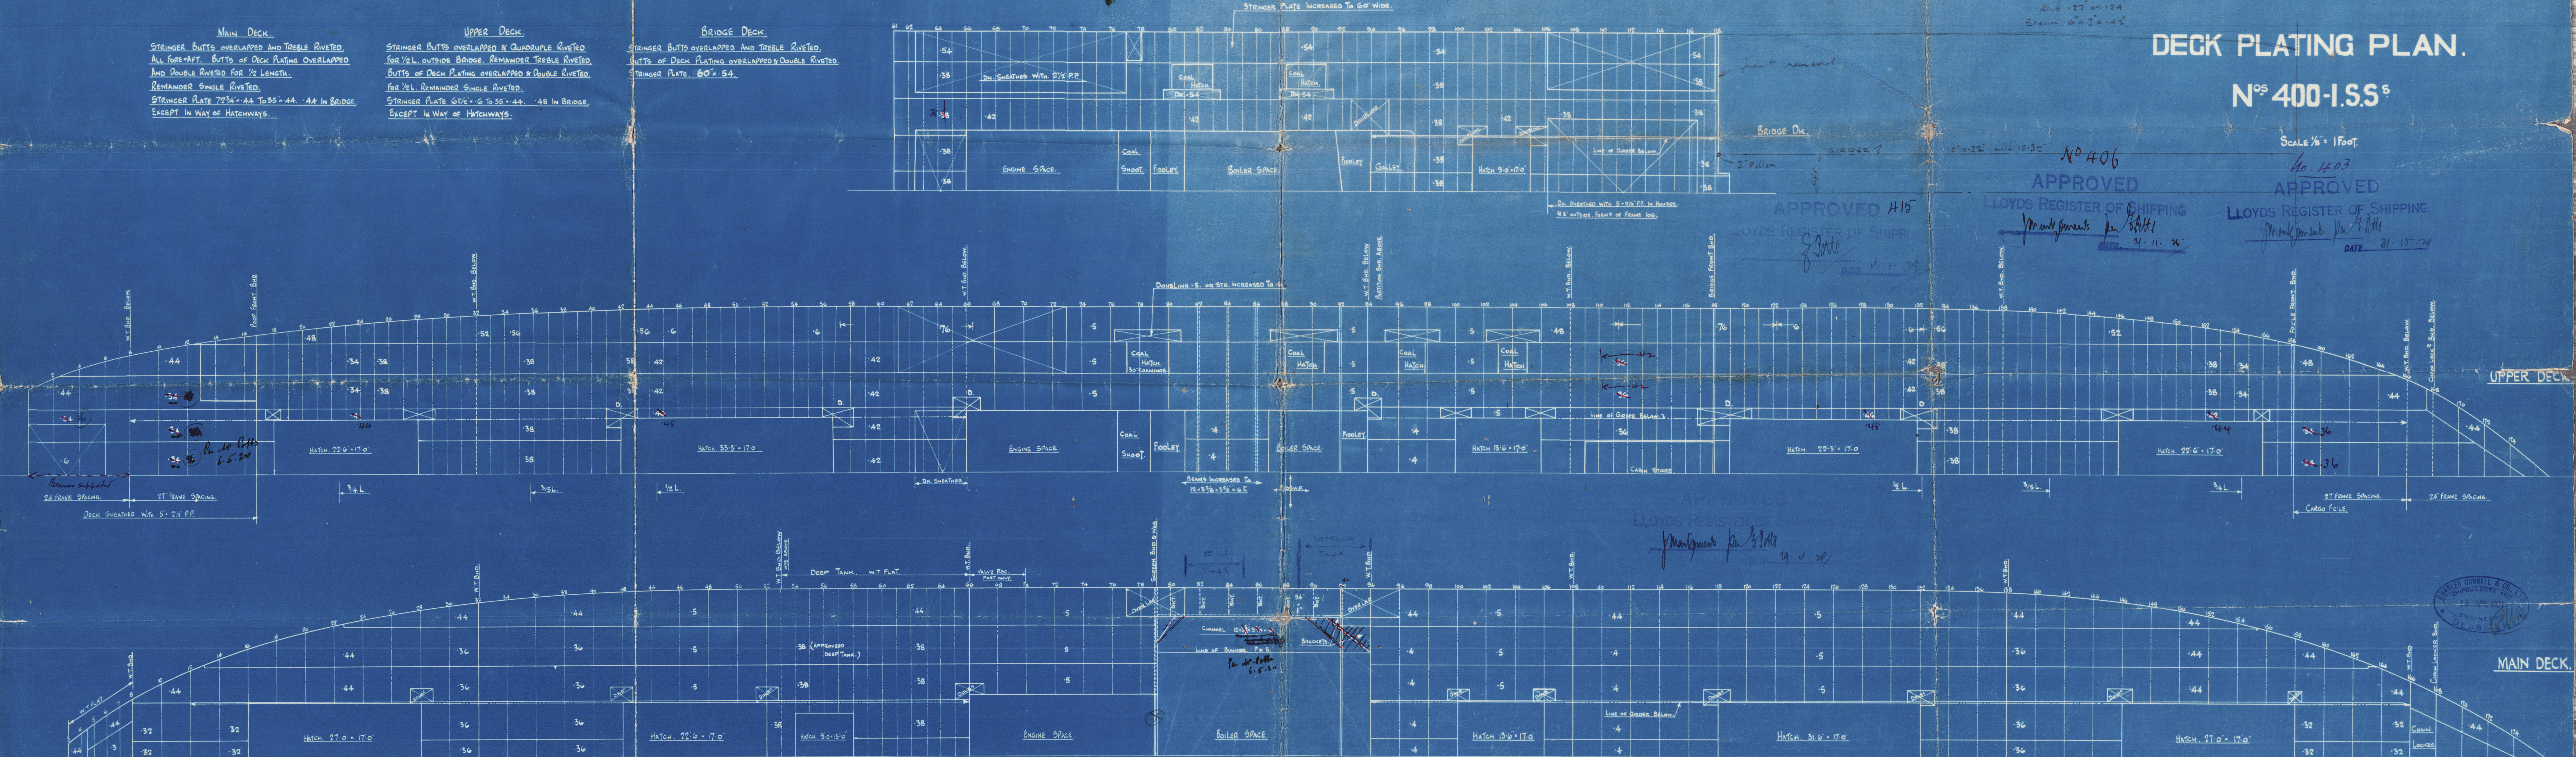

MAIN DECK.



N<sup>o</sup> 400 1.3  
Deck Plans

GLASGOW REPORT No

400

~~Historian~~

44348

Marlene  
ex



Historian

~~Historian~~  
Semirames I

401

GLASGOW REPORT No 44460

Wanderer

403 Wayfarer

GLASGOW REPORT No 44960

406

Counsellor

GLASGOW REPORT No 45940

415 " Comedian

GLASGOW REPORT No 49728

© 2021  
Lloyd's Register  
Foundation