

S.S. SEMIRAMIS DEEP TANK PLAN

PLAN OF HORIZONTAL GIRDERS, BOUNDARY BERS, SIDE FRAMES,
DECKS, TUNNEL & RECESS, CENTER LINE BHD'S, DOUBLE BOTTOM TANK TOP

MORE GIR. TO SHELL & BBS
STIFFENERS BRACKED

PL THICKS GE LENGTH
 TYPE 1 TYPE 2
 .30 (7.62) .26 (6.6) .20 (5.1)
 .40 (10.2) .30 (7.6) .24 (6.1)
 .50 (12.7) .34 (8.6) .28 (7.1)
 .60 (15.3) .38 (9.7) .32 (8.1)

STAGGERED
 CHAIN

5. RED COLOURING PARTS SHOW
THE NEWLY ARRANGED CONSTRUCTION
6. PARTS MARKED ⊗ ARE (TO BE) RENEWED
(IF NECESSARY.)

SS. SEMIRAMIS REVISED PLAN OF DEEP TANK

セミラミス号
乾水産株式會社

完成圖

燃料深槽

旧深水槽
又貨物艙

改裝構造圖

尺度 $\frac{1}{4}$ 吋 = 1 呎



SCALE 1/4" = 1'-0"

セミラミス号

乾水産株式會社

燃料
斗
深
油
槽

旧深水槽
ス貨物艙


改装
構造
圖

完成圖

尺度 1/4" = 1呎



Rpt No. Kob. 878.

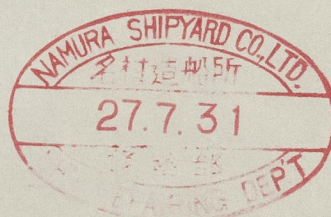

© 2021

Lloyd's Register
Foundation

005307-005310-0155