




21 SEP 1946

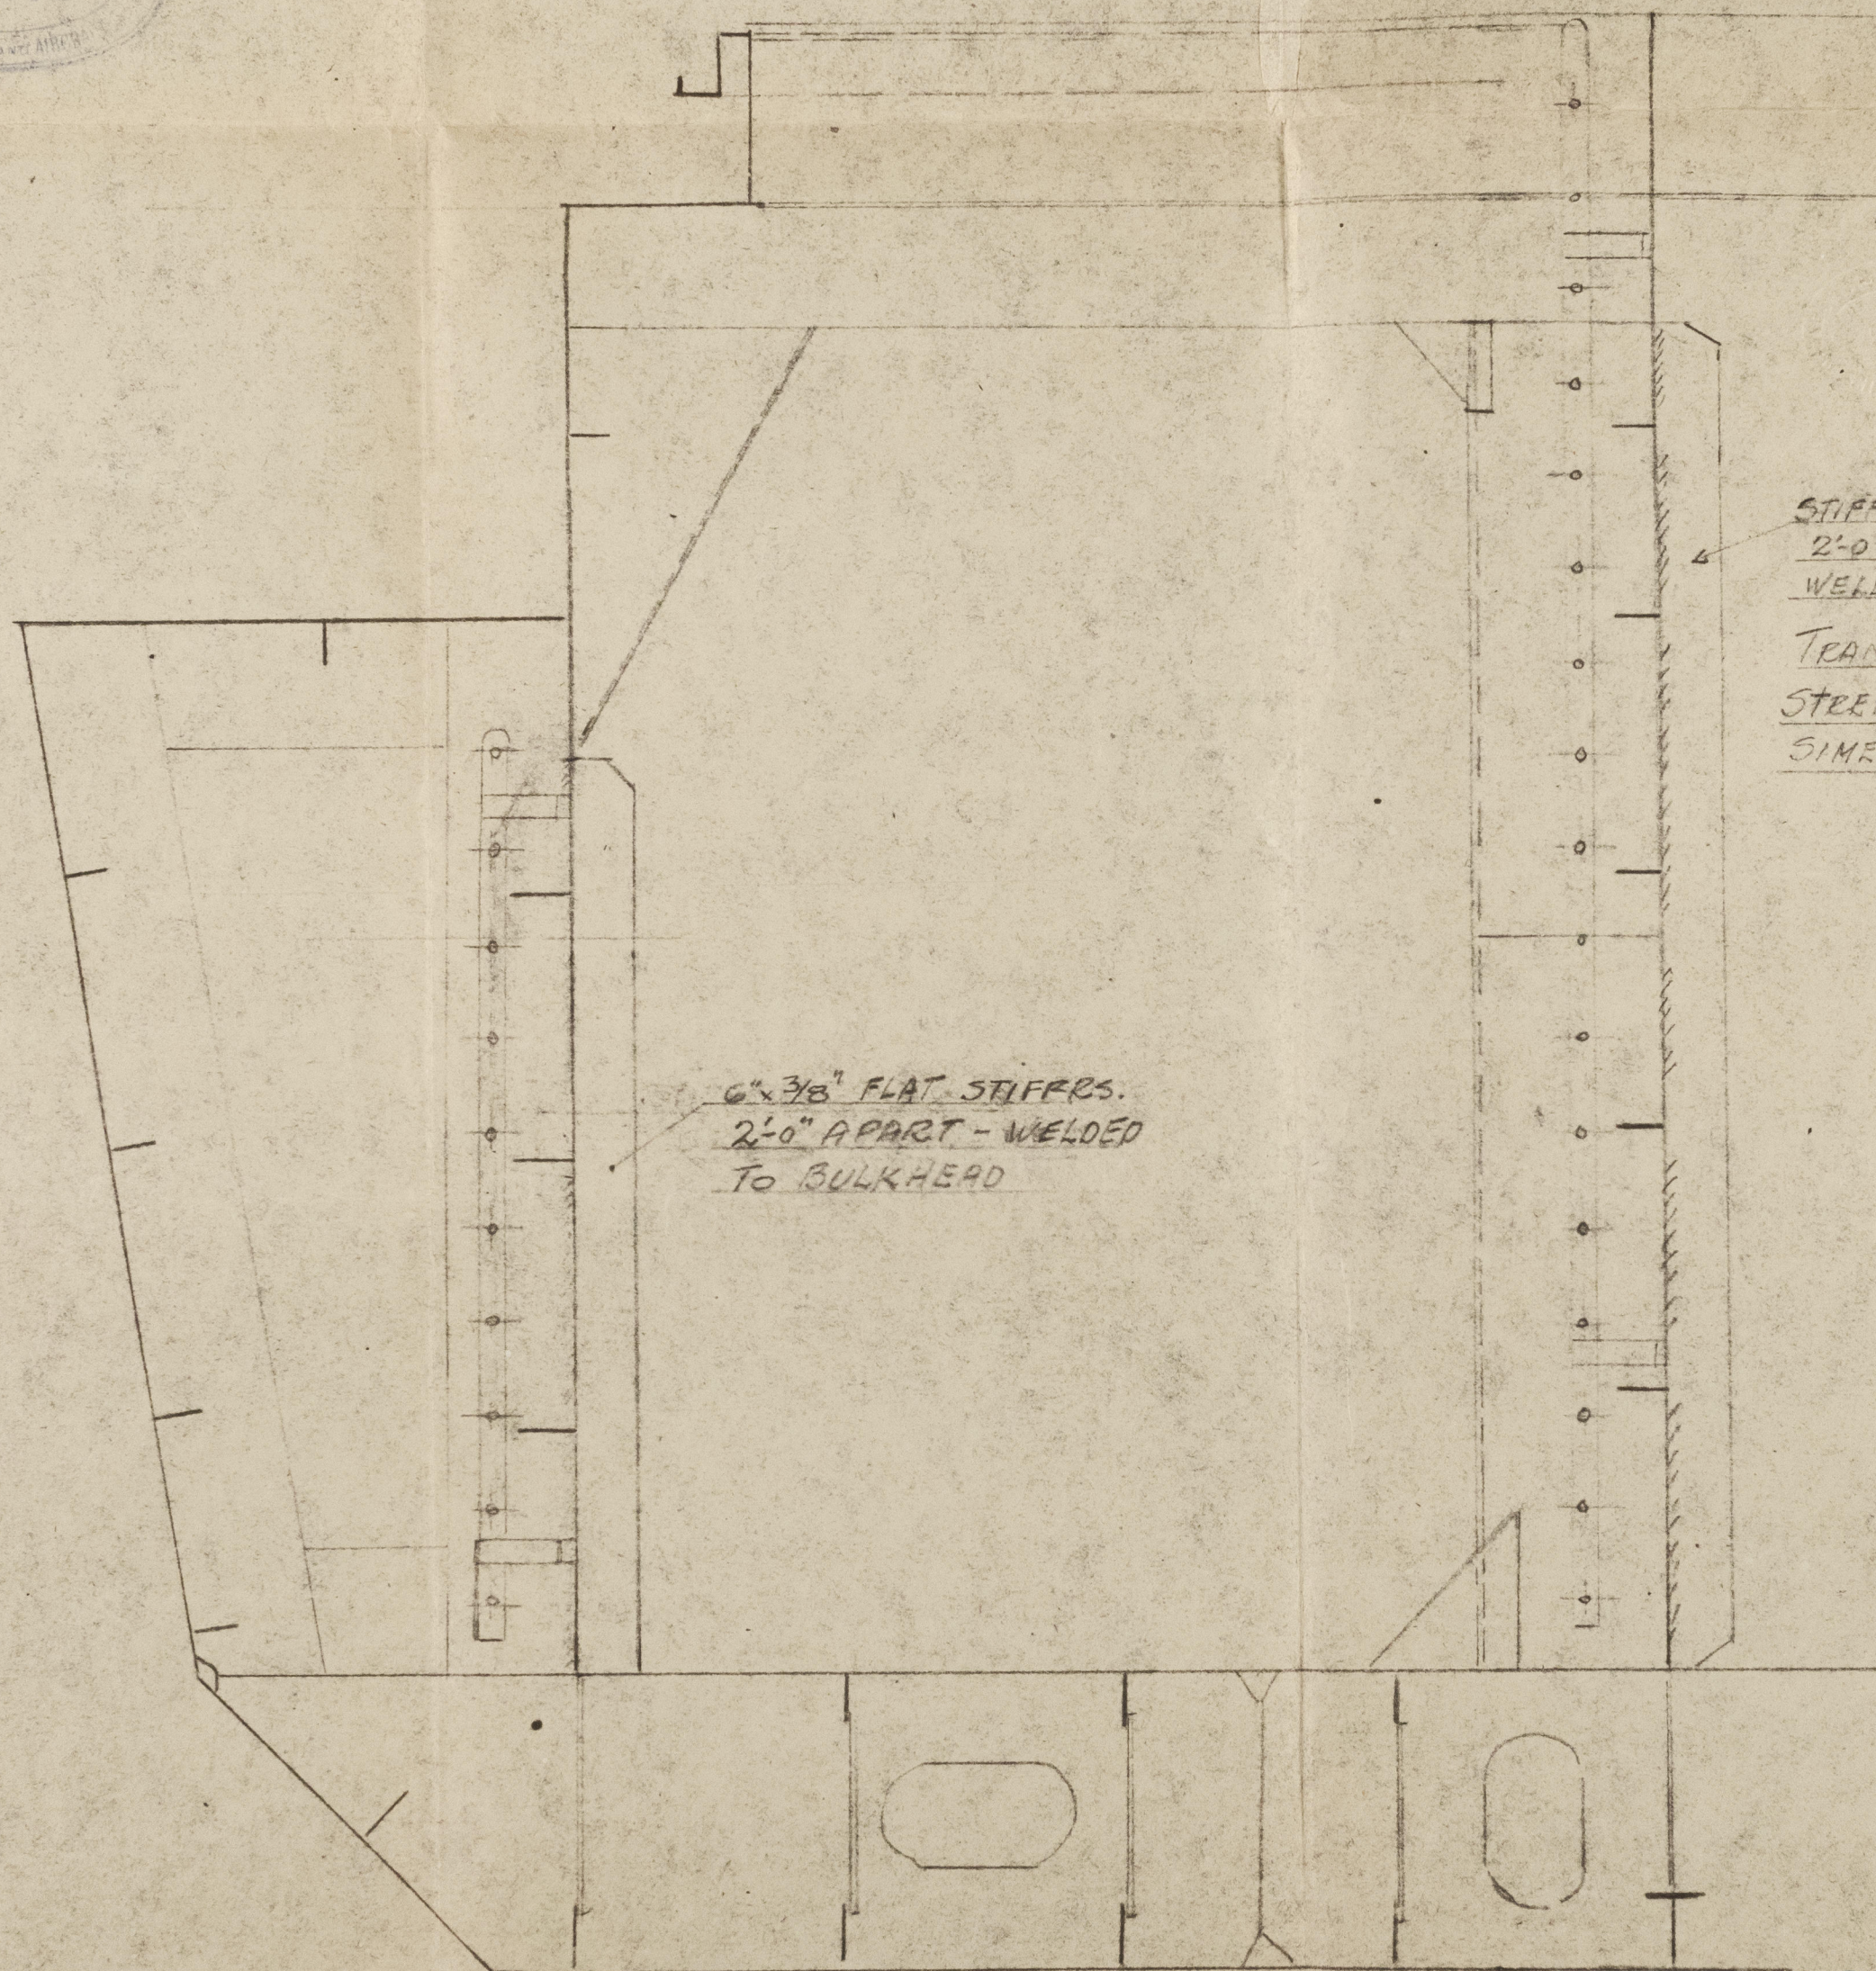

STIFFERS $6 \times \frac{3}{8}$ " FL.
2'-0" APART
WELDED TO BLKH.

TRANSVERSE BLKS
STRENGTHENED
SIMILARLY.

$6 \times \frac{3}{8}$ " FLAT STIFFERS.
2'-0" APART - WELDED
TO BULKHEAD

MIT'CHANT No 50" - PROPOSED ADDITIONAL STRENGTHENING
FOR CARRYING LIQUID OF SPEC. GRAVITY = 1.7



© 2021

18/9-46

Lloyd's Register
Foundation

005311-005317-0067

Proposed Additional Strengthening

Chart 50.

21 SEP 1946

Shaw



005311-005317-0067



© 2021

Lloyd's Register
Foundation