


© 2021
Lloyd's Register
Foundation

5/10/49.

STRUCTURAL ALTERATIONS
FWD. OF ENG. ROOM

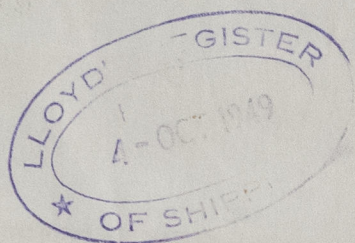

M.V. "JIM M."

Pl. No. Hull. 56094

Hull.
Surveyor
copy

005311-005317-0068

005311-005317-0068

Jim M



© 2021

Lloyd's Register
Foundation