


M. V. "JIM M"  
SECTION THRO' ENGINE SEATING

SCALE  $1\frac{1}{2}'' = 1 \text{ FOOT}$



Locally  
Lloyd's Register  
Foundation

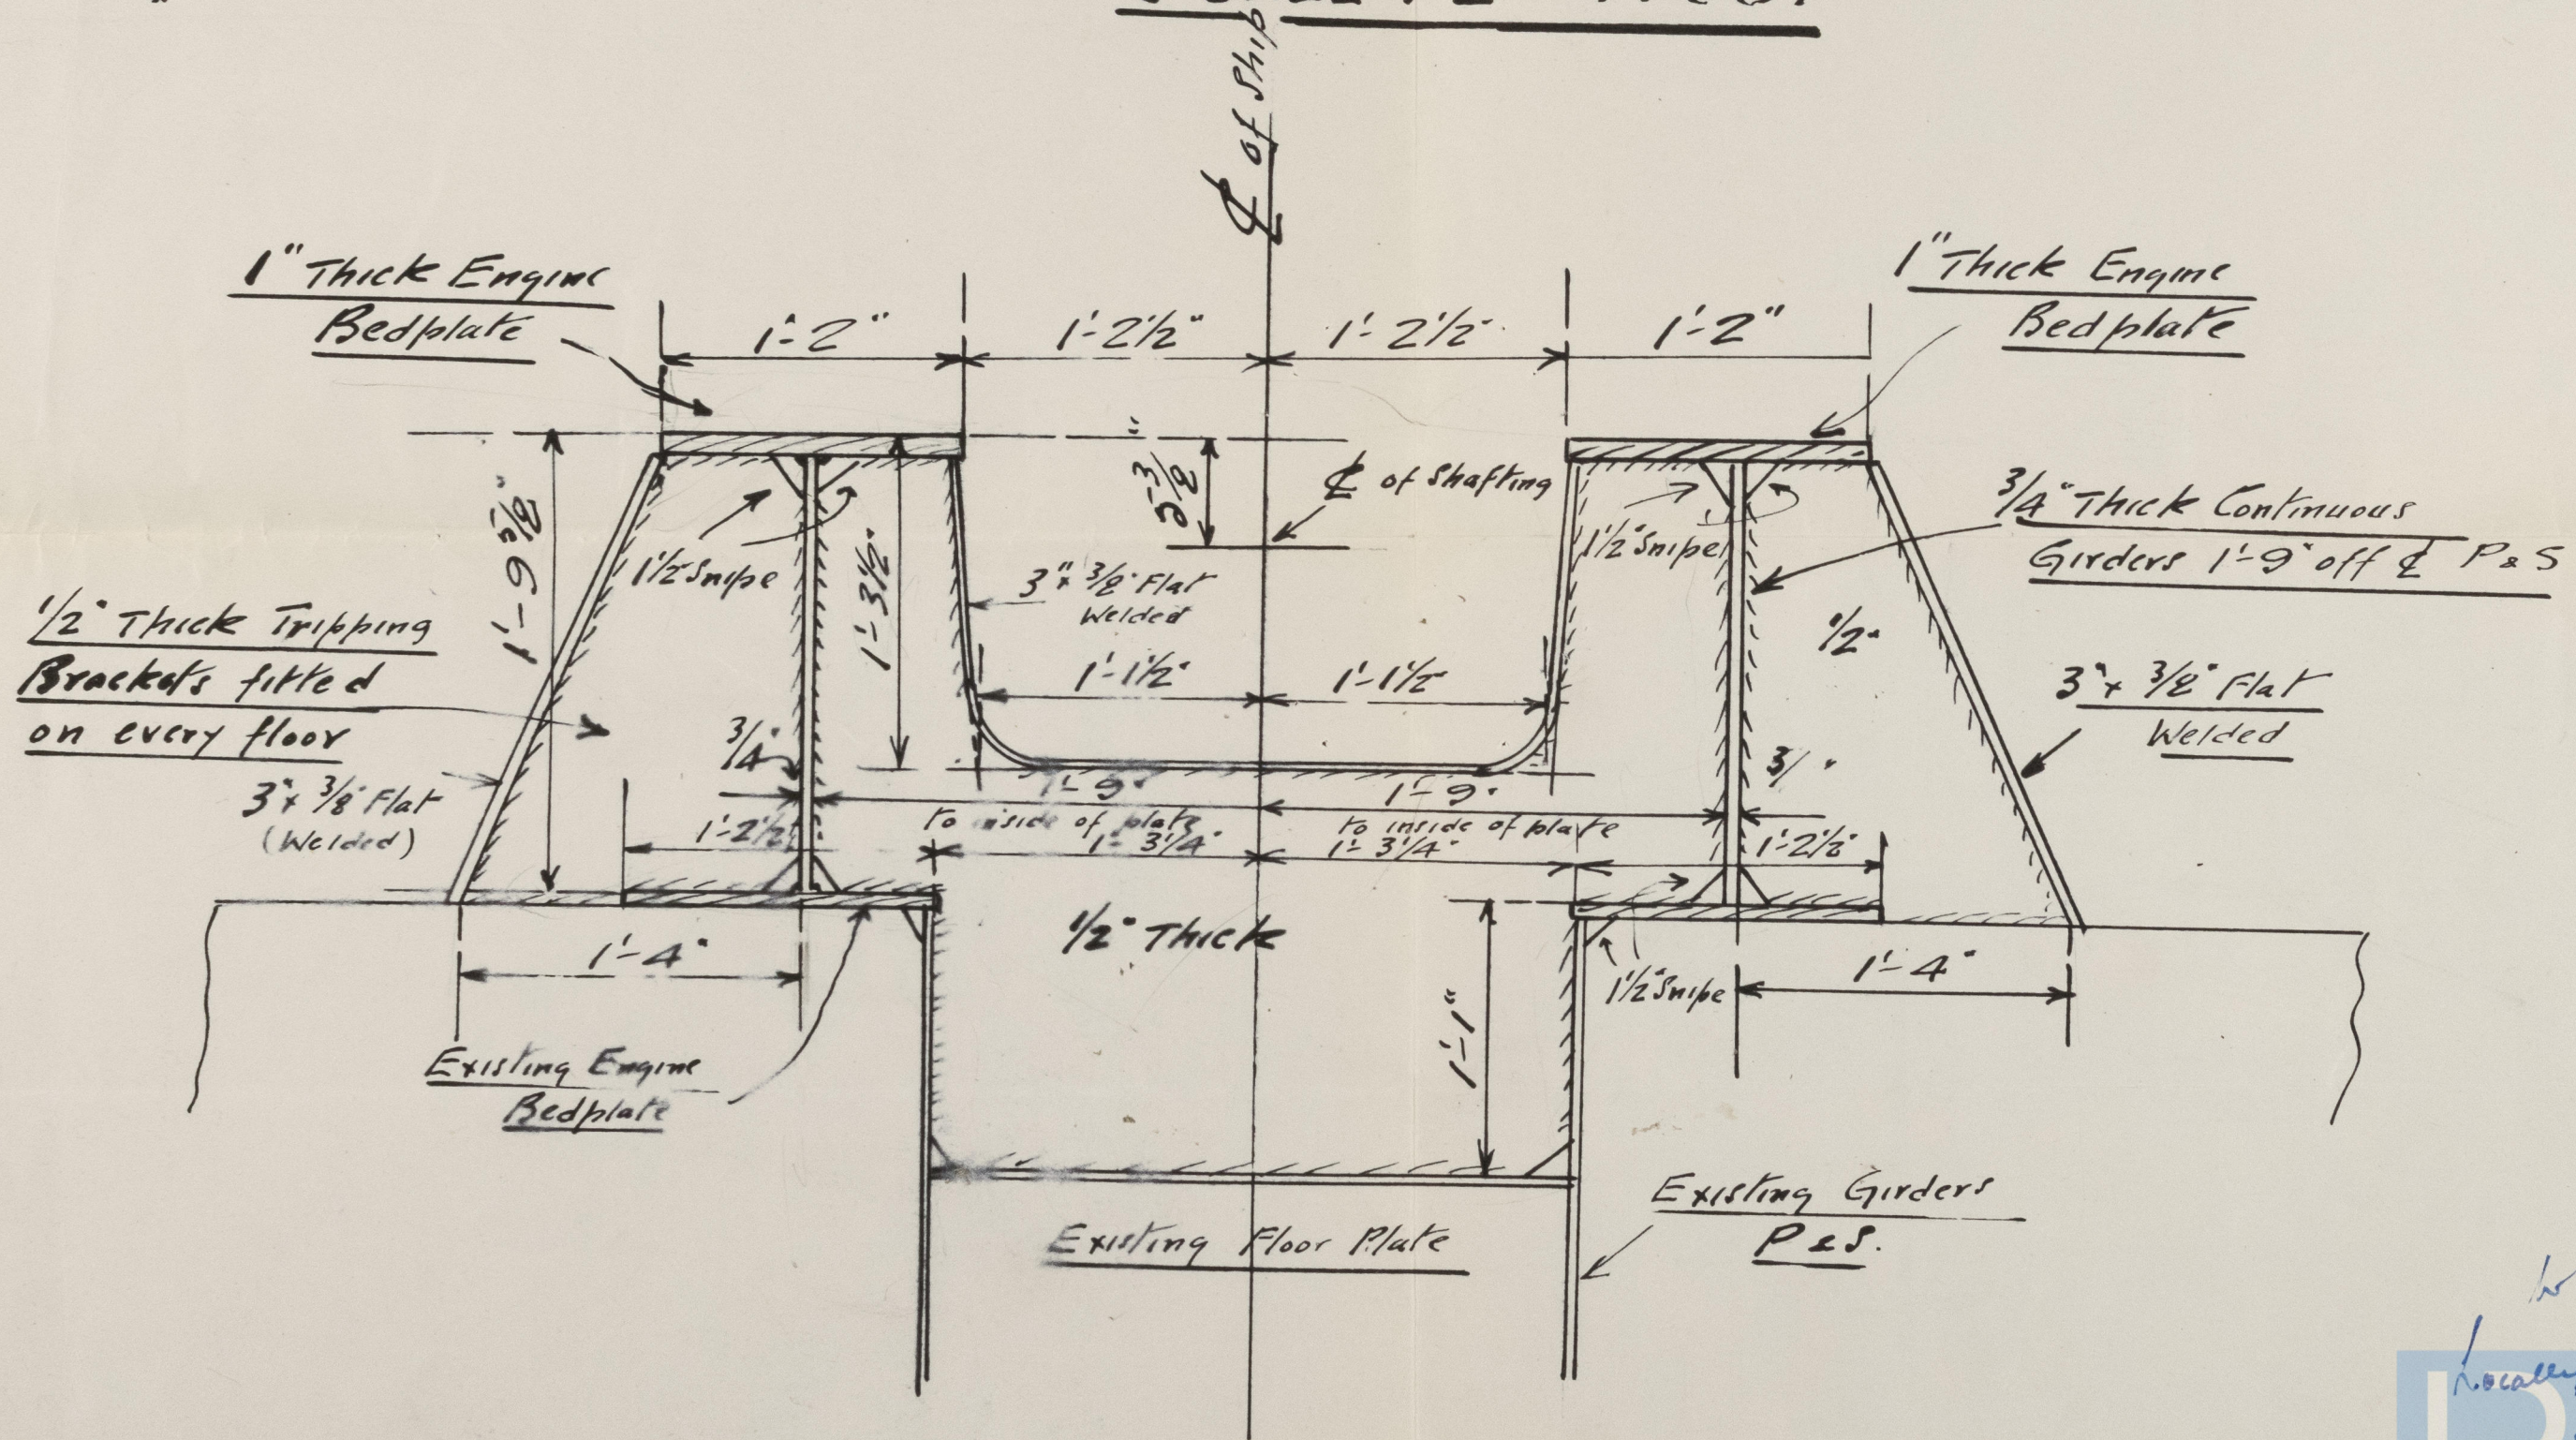

S/MS " JIM M "

TO ACCOMPANY.....Hul.....Rpt. No. 64692.

Dated.....6/2/59.

SUBJECT:- Alterations to Eng. Seating

Jim. m'

Mt Seating Plan.

Hull Rpt 8 No.



© 2021

Lloyd's Register  
Foundation

005311-005317-0069