


SECTION SHOWING BRACKETS  
IN TWO FORWARD BAYS

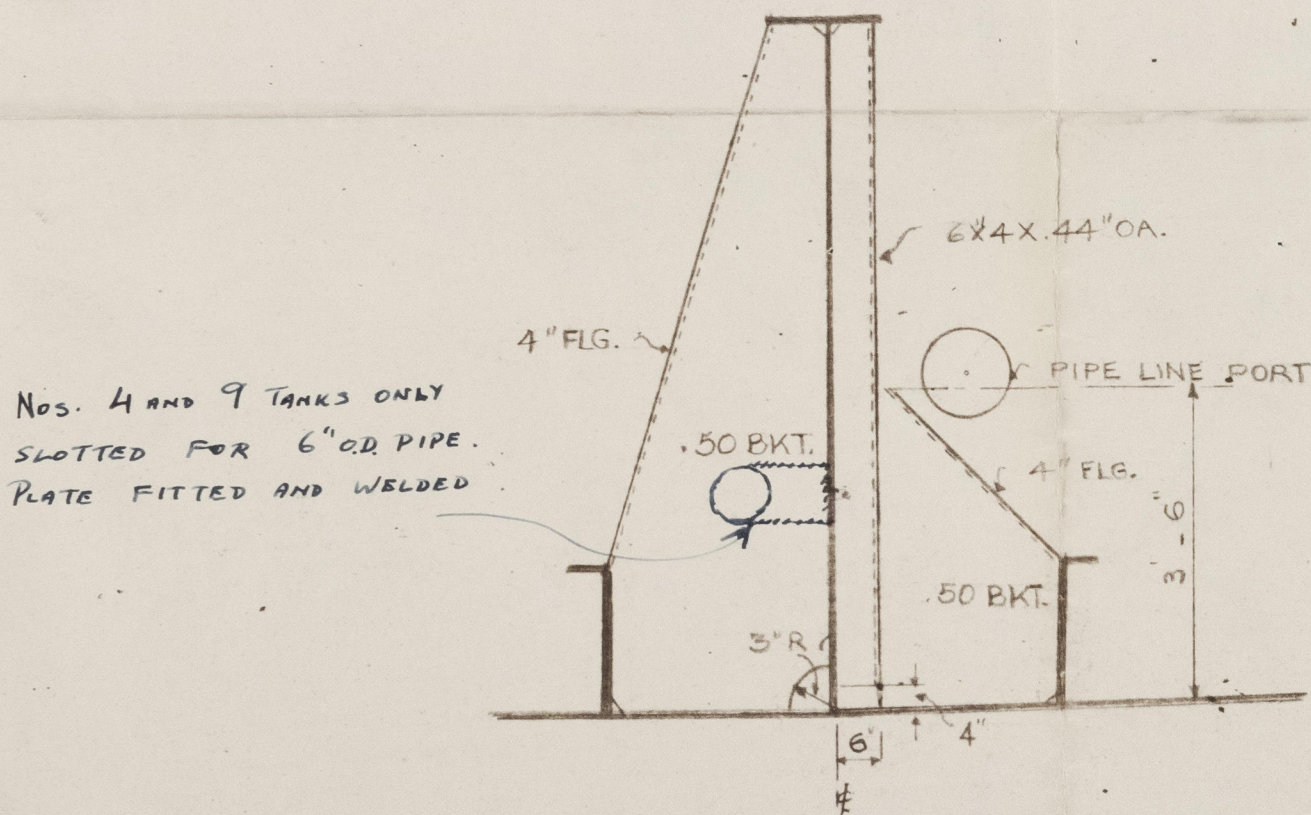

SECTION SHOWING BRACKETS  
IN AFTER BAY

Approved:  
Montreal  
ARW.  
19-6-53.

HALIFAX REPORT No. 6587.

S.S. IMP. WINNIPEG

IMPERIAL OIL SHIPPING  
COMPANY LIMITED

CHURCH ST.

TORONTO, ONT.

T-2-TANKERS  
NEW DOCKING BRACKETS  
ON CENTRE KEELSON

DRAWN BY E.M. TRACED BY M.D.R. CHECKED

DIVISION HULL

APPROVED

DATE

JUNE 16/53

DWG. No. 76

SCALE 1" = 1'-0"

NOTE:

BRACKETS TO BE FITTED APPROX. MIDWAY BETWEEN TRANSVERSES AND TRANSVERSE AND BULKHEAD IN NOS. 2-9 CENTRE TANKS. ~ REMOVE EXISTING STIFFENER AND TRIPPING BRACKET AT MID SPAN. ~ SHORTEN HEATING COILS IN STARBOARD AFTER BAY TO CLEAR BRACKET.