



S.S. IMPERIAL WINNIPEG.
 TO SHOW ALTERATIONS ONLY
 THIS FRACTURE APPLIES TO
 S.S. IMPERIAL FREDERICTON.

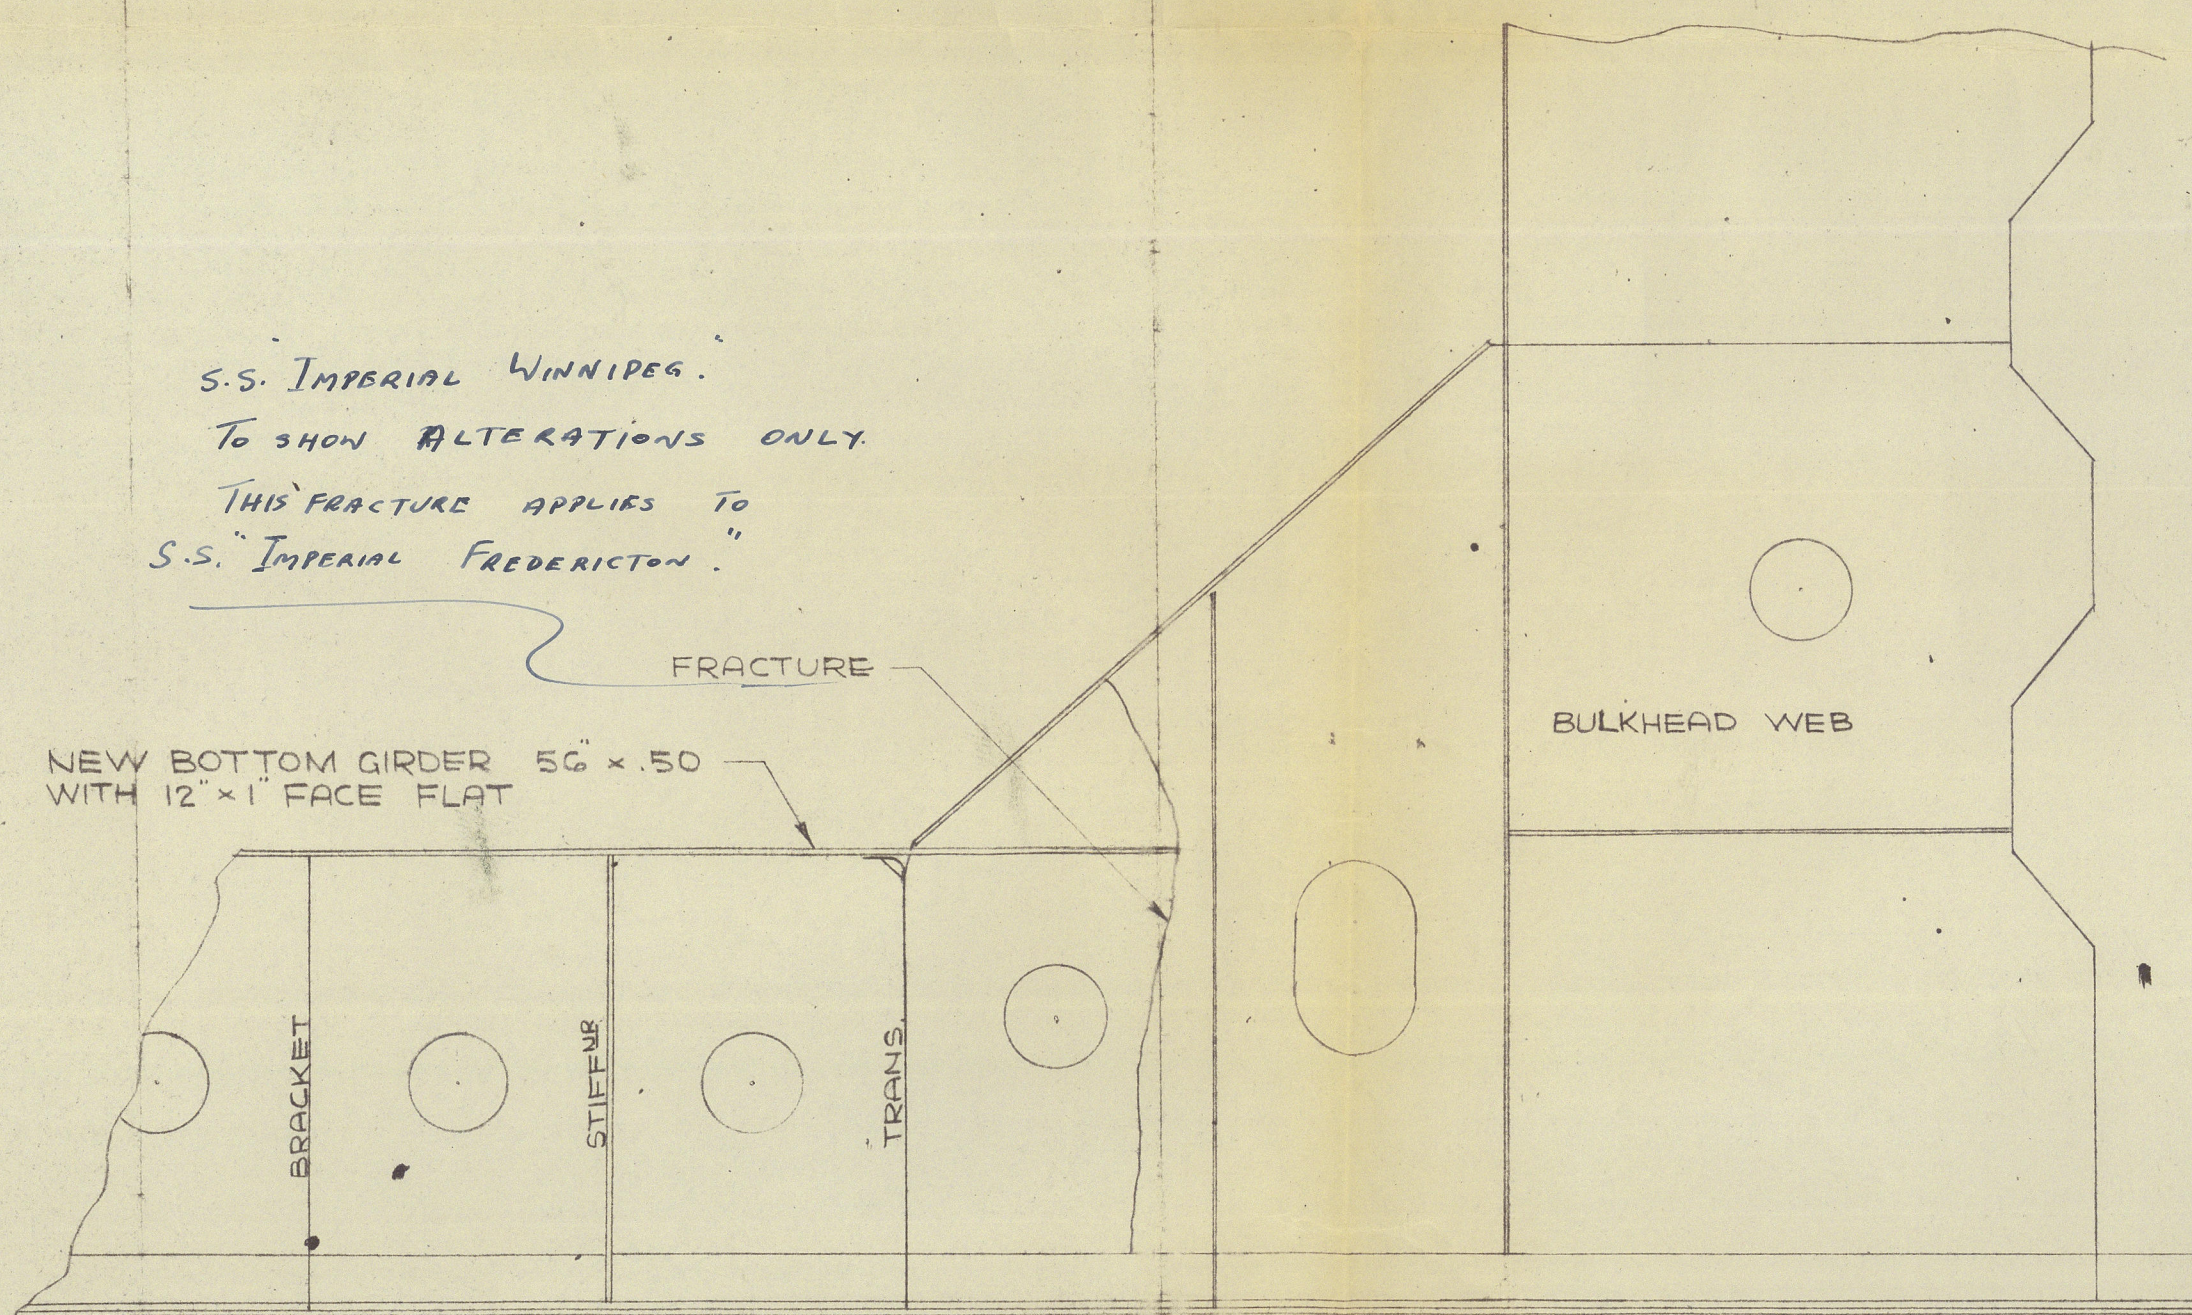

EXISTING STRUCTURE SHOWING FRACTURE
 THROUGH BOTTOM GIRDER 10'-0" FROM C

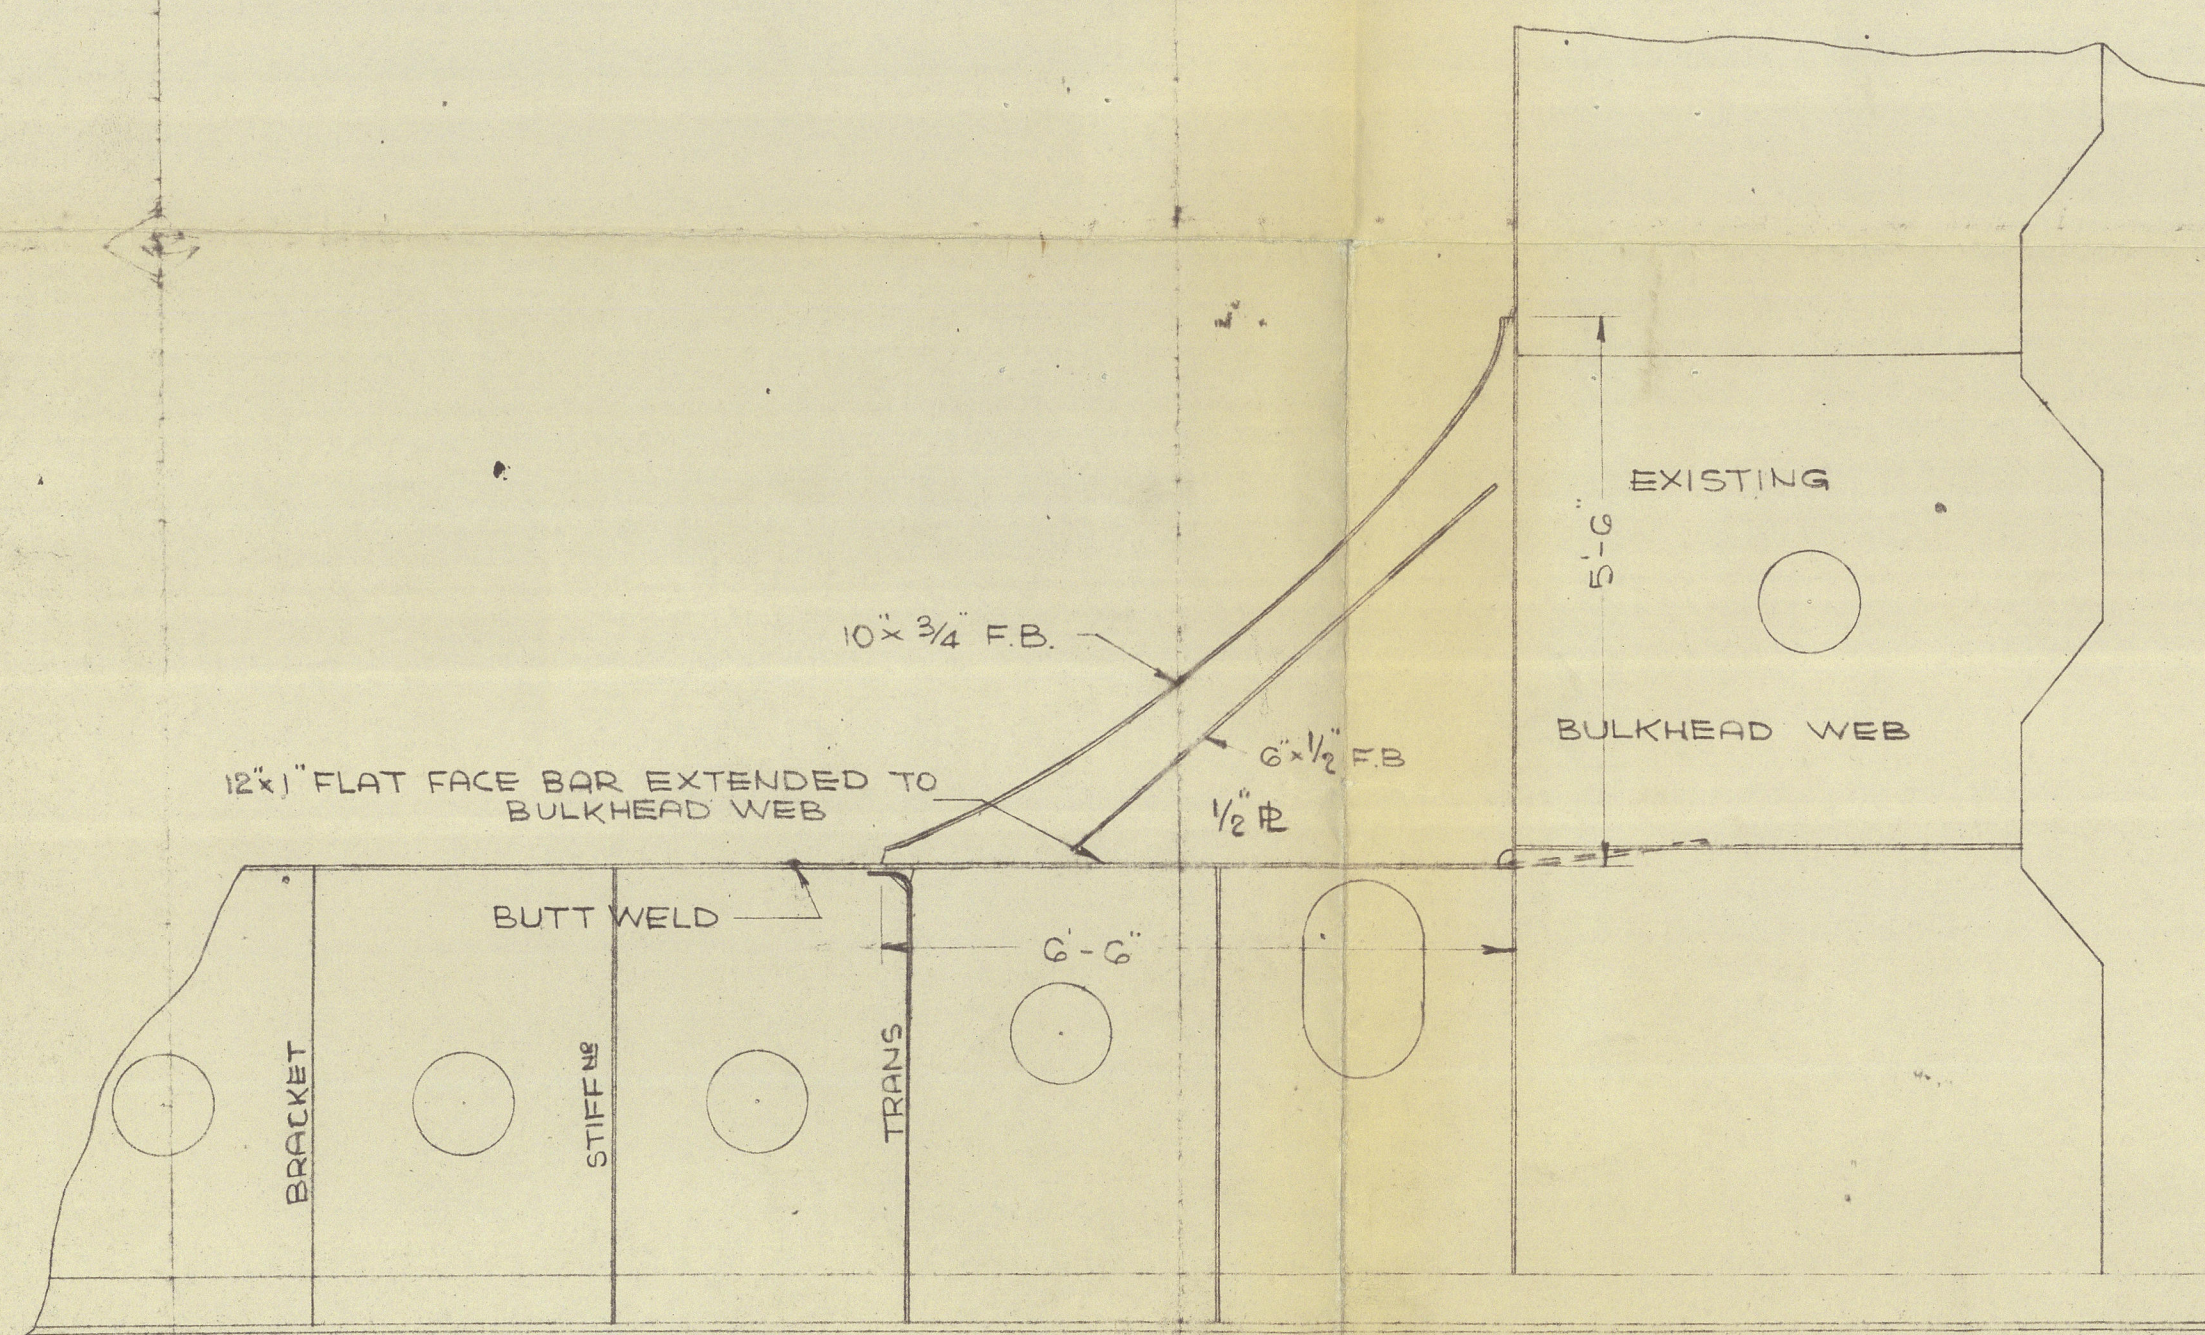

ELEVATION



PLAN

REPAIRS IN WAY OF FRACTURED BOTTOM GIRDER

HALIFAX REPORT No.
 6587.

S.S. IMPERIAL FREDERICTON
 WINNIPEG

REPAIRS & ALTERATIONS
 TO BOTTOM GIRDERS 10'-0" OFF P+S
 CARGO TANKS 2-7 INCLUSIVE

HALIFAX SHIPYARDS LIMITED
 MARINE SLIPS

DATE: JUNE 1, 1953

SCALE: 1/2" = 1'-0"

BY: J. H. B. (Signature)

7797-III-1

005311-005317-0234