

圖面來歴


当社ニ於テ調製ス
昭和27年10月28日

SECOND DECK PLAN (DEEP TANK TOP)

DETAIL

BEAMS 290 x 90 x 11.6 B.A
" 230 x 90 x 11 B.A 19RIV P=6d

SECTION AT Fr B
LOOKING AFT

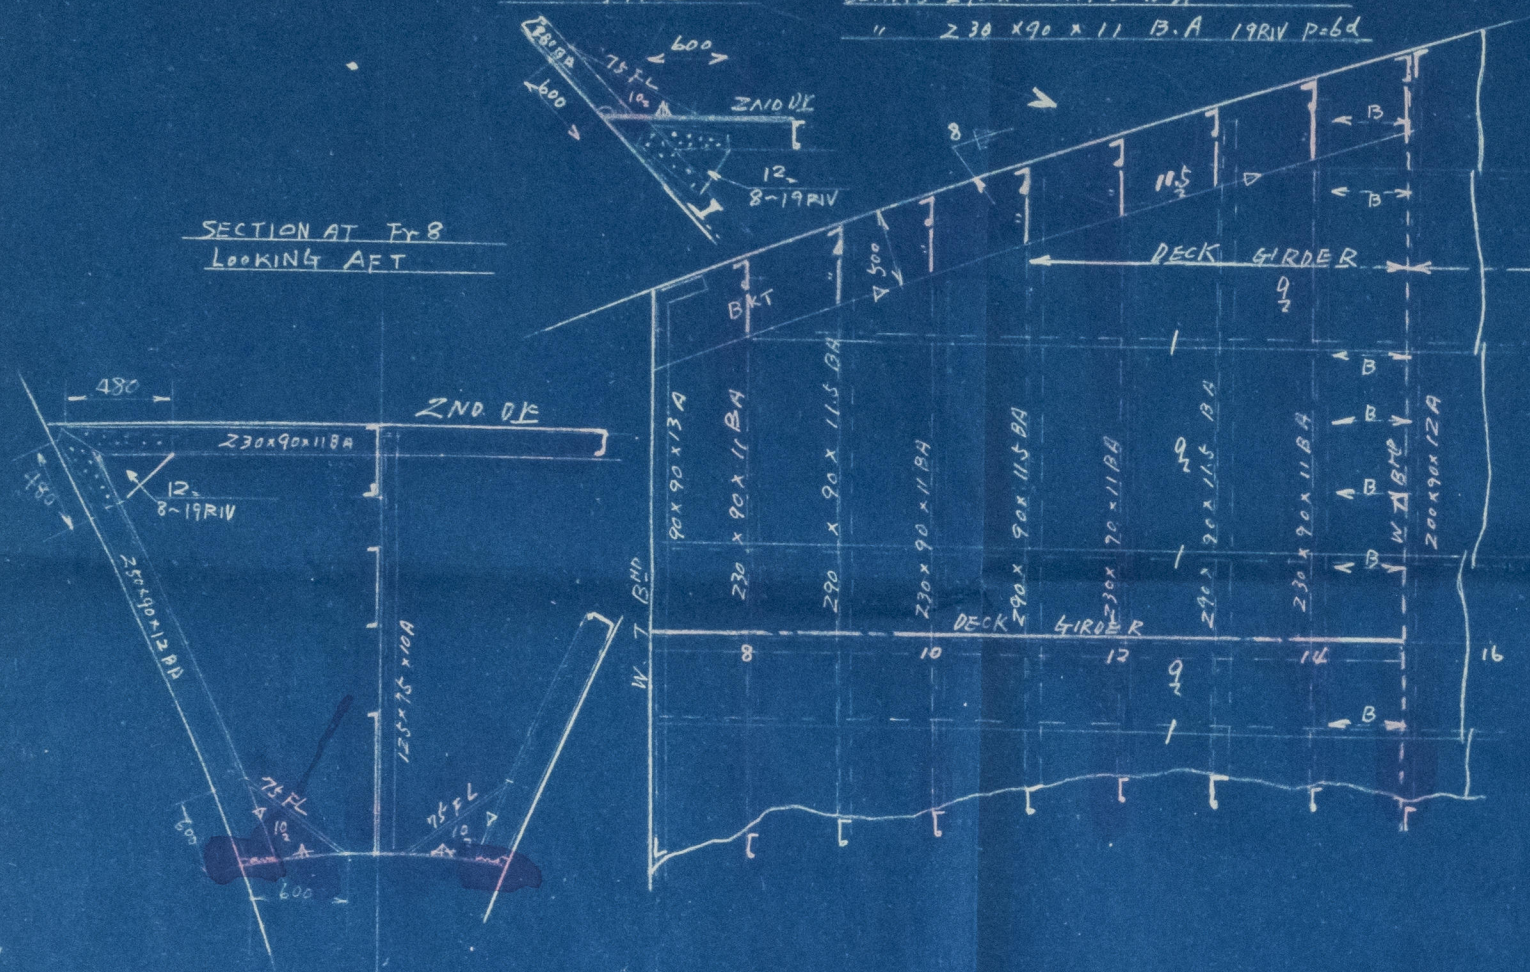

REMARKS :-

- 1 BOTH SIDE ARE SYMMETRY EXCEPT SPECIALLY NOTED
- 2 THE RED COLOURED PARTS SHOWS THE NEW CONSTRUCTION PARTS

RIVETING AND WELDING NOTES


AFT DEEP TANK

END CONNECTION AND SEAMS OF BULKHEAD PLATING	7d
STIFFENER TO BULKHEAD PLATING	6d
BULKHEAD FLANG OF BOUNDARY ANGLE	4 1/2 d
2ND DECK AND SIDE SHELL FLANG OF BULKHEAD PLATING	5 d
2ND DECK TO SHELL PLATING	5 d
BEAM TO 2ND DECK PLATING	6d
CENTER GIRDER TO 2ND DECK PLATING	4 1/2 d


FR NO 15 WATERTIGHT BULKHEAD
LOOKING AFTERWARD



A-A SECTION

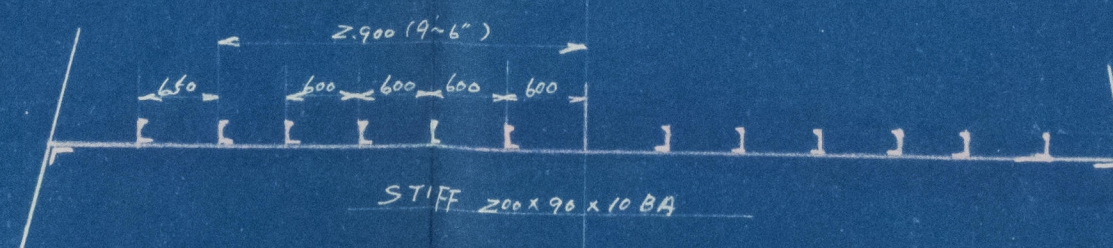


FRONT SECTION
LOOKING AFT

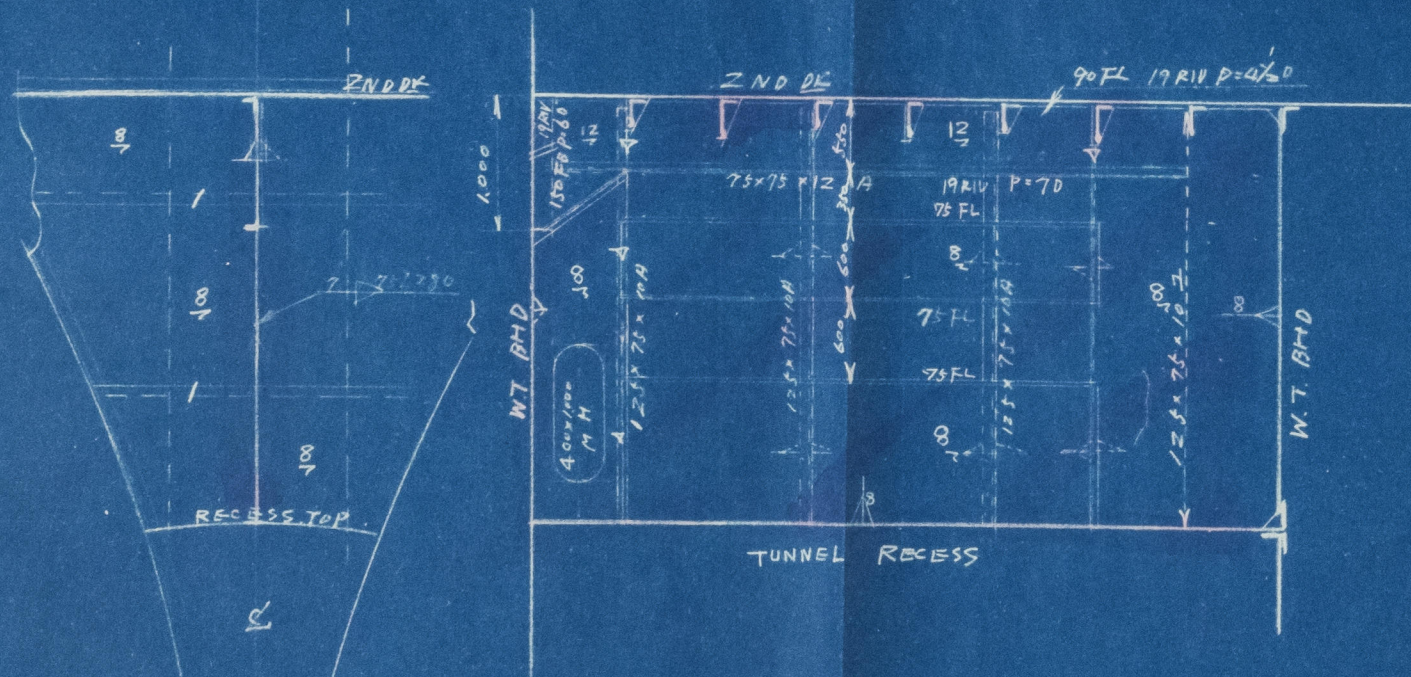

SWASH PLATE 200 x 10 B.A
(CENTRE LINE)

TUNNEL RECESS TOP PLAN

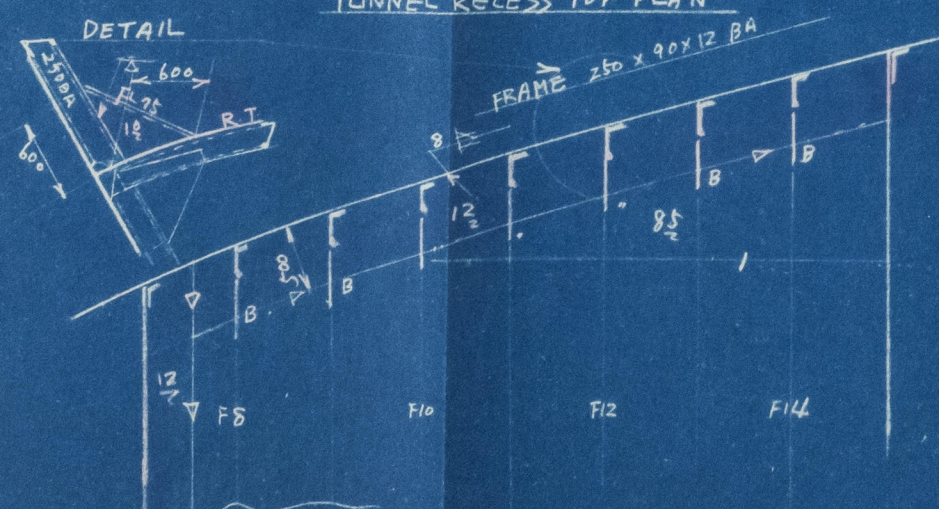

SHINWA MARU
CONSTRUCTION
OF
AFT DEEP TANK
(TRIMMING TANK)

SCALE 1/50
THE TAGUMA SHIPBUILDING
CO. LTD

DRAWING NO H-4
DATE
DRAWING OCT 28.52

新和丸
東和船舶株式会社

新設
船艙深水艙

完成圖

尺度 1/50

田熊造船株式會社
工務部設計課

部長	課長	擔任	圖	圖

完成日附 昭和27年10月28日

出圖 第 號

圖面番號 H-4

R

SHINWA MARU
CONSTRUCTION
OF
AFT DEEP TANK
(TRIMMING TANK)

SCALE $\times 50$
THE TAGUMA SHIPBUILDING
CO. LTD

DRAWING NO. H-4
DATE
DRAWING October 28.52

新和丸
東和船舶株式會社

新設
船艙深水艙

完成圖

尺度 $\times 50$

田熊造船株式會社
工務部設計課

部長	課長	擔任	圖	圖
	兼美		岡野	


完成日附 昭和27年10月28日

出圖 第 號

圖面番號 H-4

LLOYD

RECORDS DEPT.
LONDON

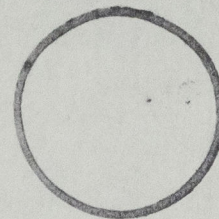

© 2020

TO ACCOMPANY Kobe REPORT No. 999
DATED 10.51 Lloyd's Register

Foundation