

ELEVATION PORT SIDE-LOOKING FROM E.

SECTION THRO'
LONGTL BHD.

SECTION AT TRANSVERSE.

DETAIL OF 12 INCH
CORRUGATIONS.

DETAIL OF 9 INCH
CORRUGATIONS.

Furness S. B. Co. Ltd.



Yard Nos. 445 ~~to~~ cancelled.

Longitudinal O.T. Bulkhead

"SAN SALVADOR" ★

MIDDLESBROUGH
REPORT No. 19279

RECORDS DEPT.
LONDON

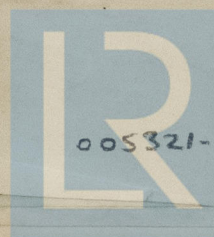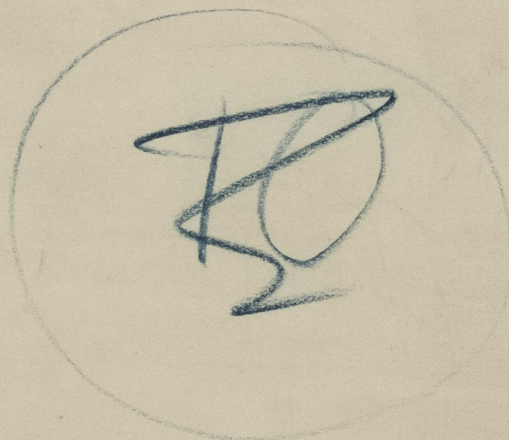

© 2020

005321-005324-0006

Lloyd's Register
Foundation