



No. 509-10.

Shy to Midship Section

Shewing deletion of Coal Bunker Bulkhead
& the addition of diagonal Channel

Stays & deck girders

Scale $\frac{1}{2}$ " = 1 foot.

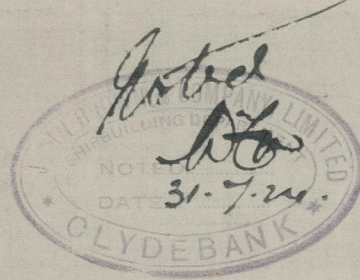
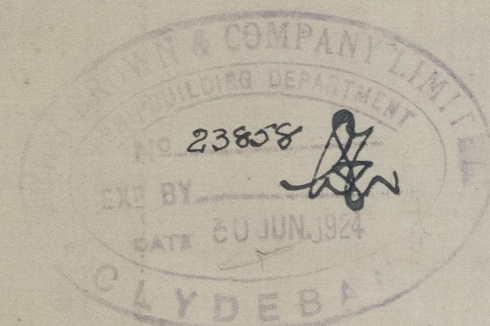


APPROVED
LLOYD'S REGISTER OF SHIPPING

Montgomery

DATE

29.4.24

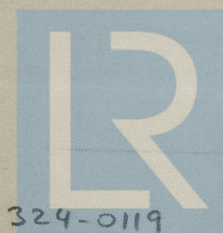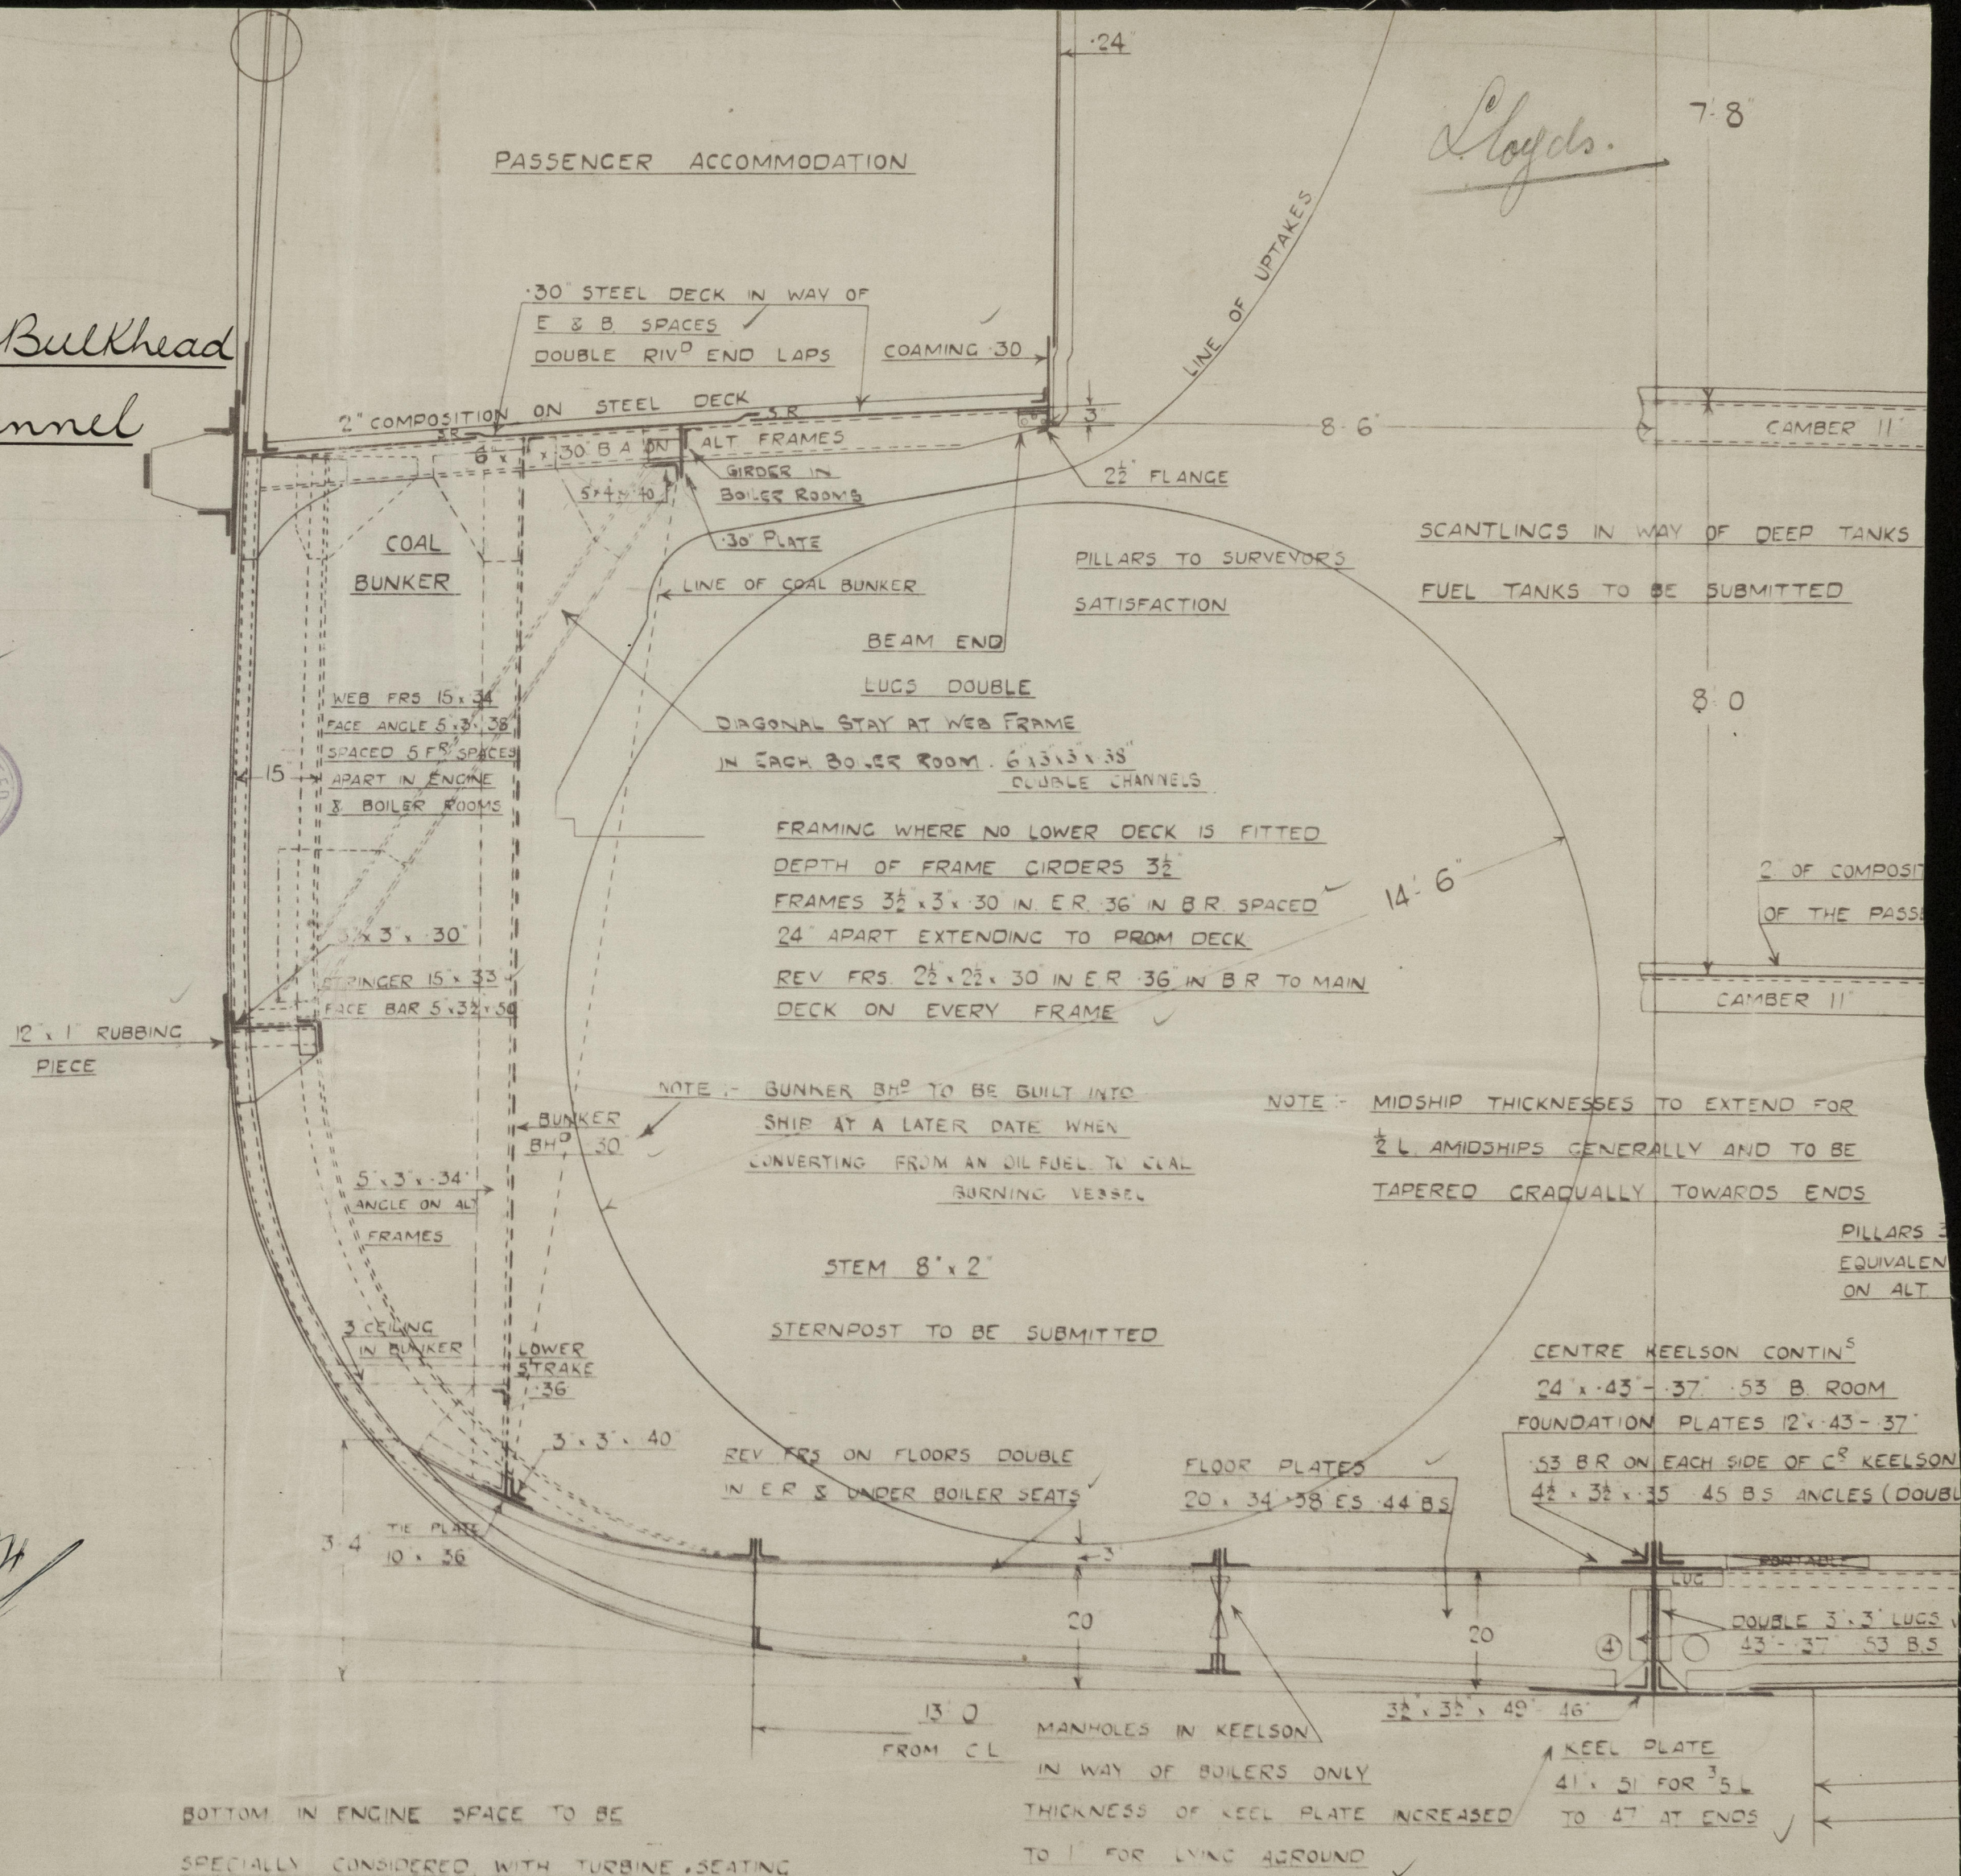

© 2020

Lloyd's Register
Foundation

005321-005324-0119

Fly to M.S.

St Julien

Mrs Rowntree

005321-005324-0119



© 2020

Lloyd's Register
Foundation