
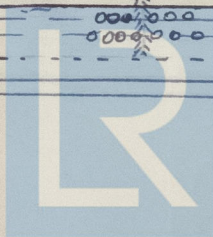


Please Attach to Rpt N° 30546

Steel Screw Tug "ST HILARY"

repairs carried out in tested material.

Both Boilers identically dealt with.

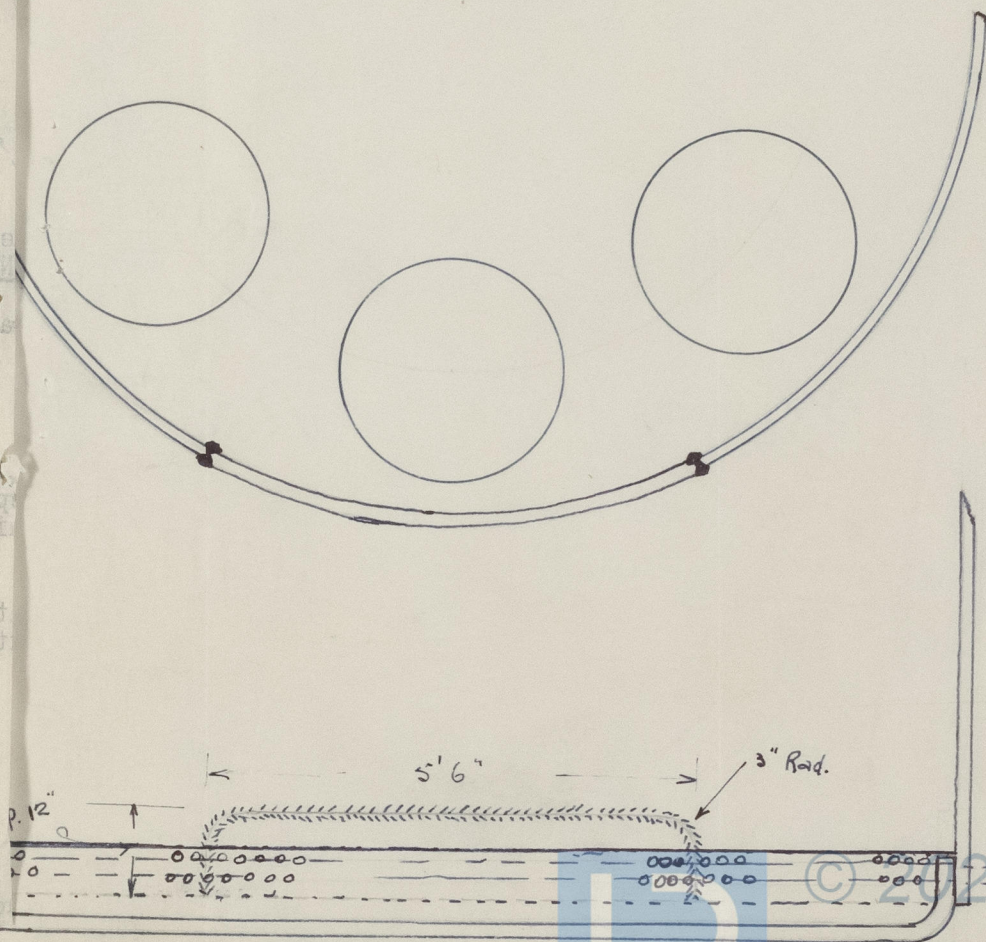

© 2020

Lloyd's Register
Foundation

005325 - 005336 - 00/b