

Nº 481.


T.S. CARGO STEAMER

DIMENSIONS 209'-0" B.P. x 34'-3" x 13'-0" MLD UPPER DECK 17'-0" R.R.D.K.




SCALE 1/8" = 1 FOOT.

TO CLASS 100 A1 + LLOYDS SPECIAL SURVEY.

- B = 1300 AT UPPER DECK
- B + D = 4728
- L x D = 2712
- L x (B + D) = 5873
- L x D = 1377 AT UPPER DECK
- L x D = 1046 AFT HOLD DOUBLE BOTTOM
- L x D = 1230 AT QUARTER DECK
- L x D = 1550 AT BOILER ROOM SINGLE BOTTOM
- L x D = 1446 AFT HOLD QUARTER DECK
- L x D = 85 TO BRIDGE DECK
- BRIDGE DECK COVERS 24% OF VESSEL LENGTH.

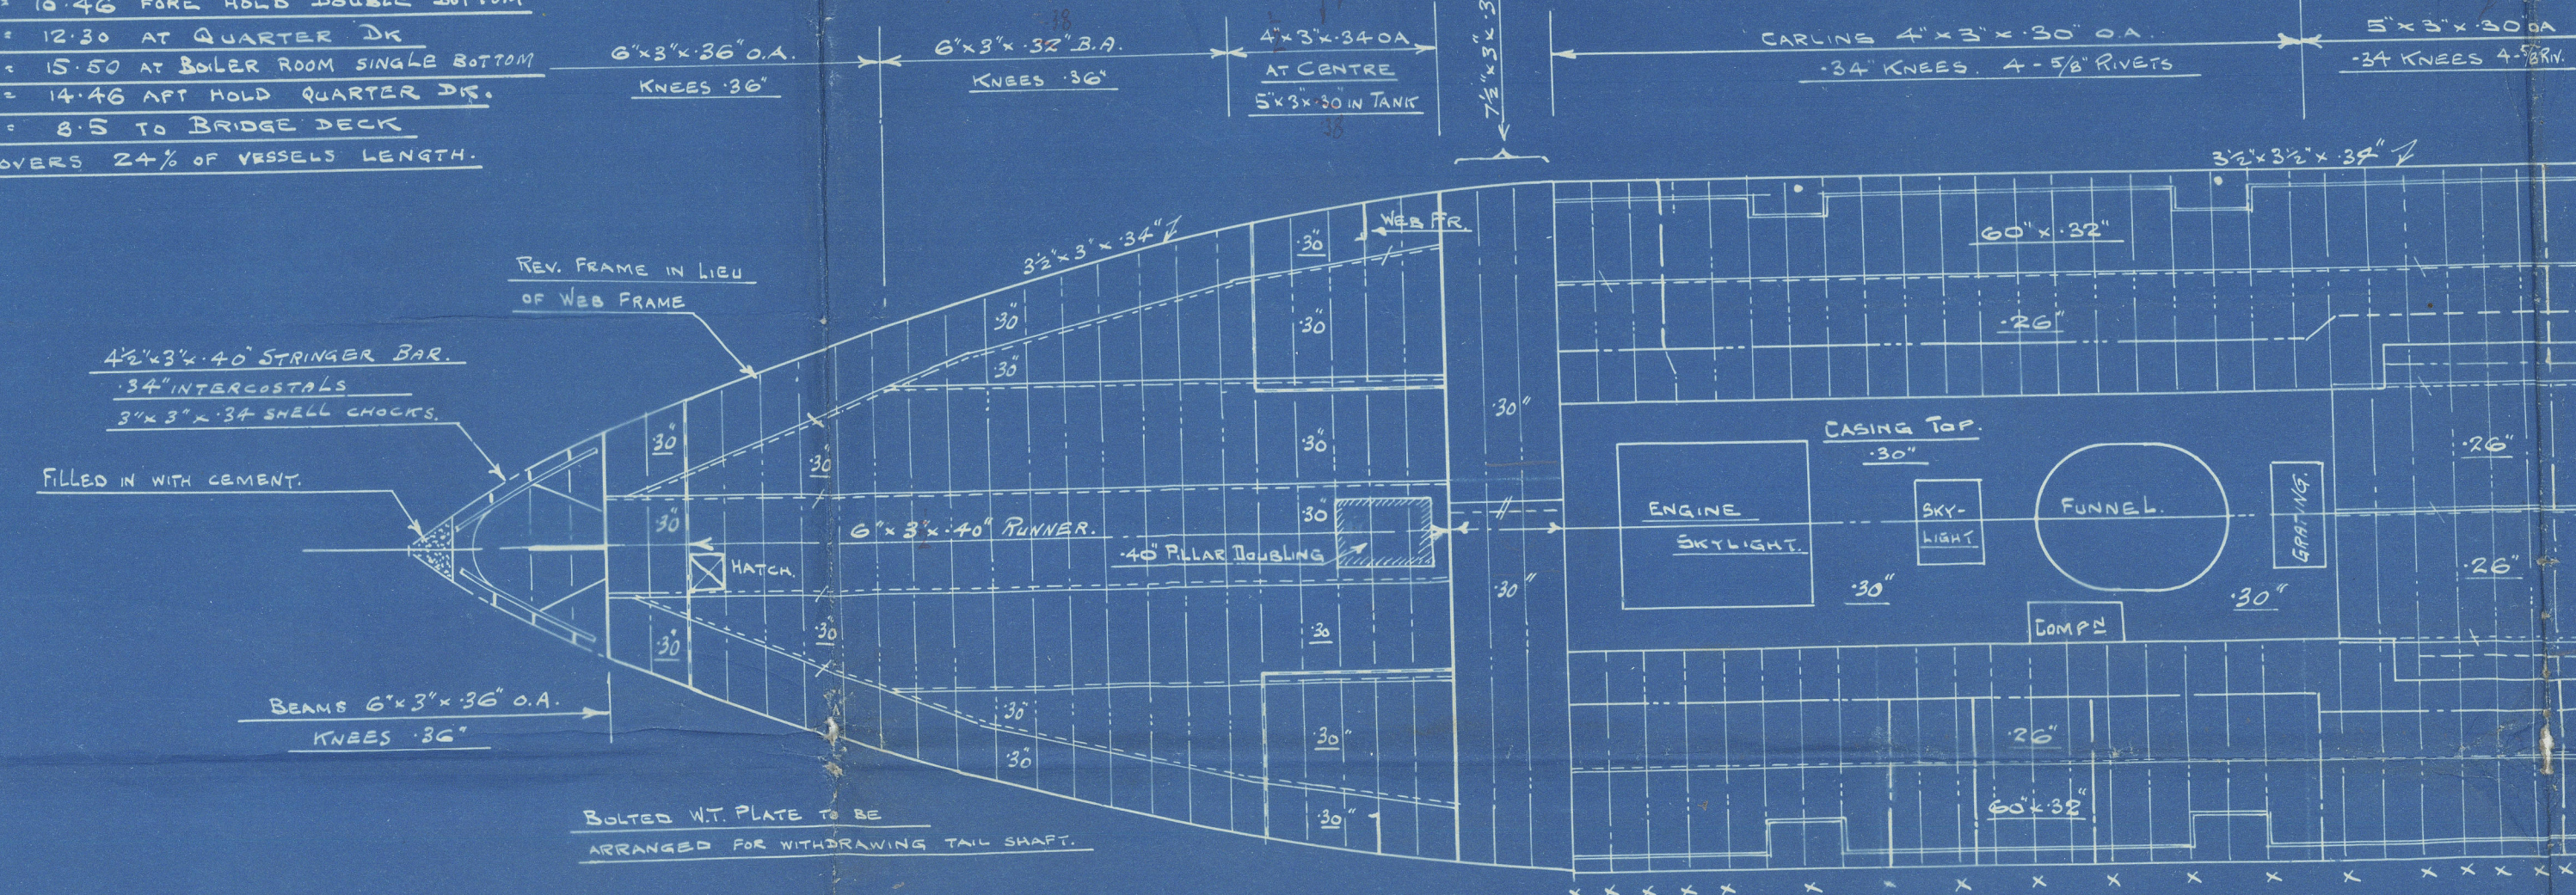


Reading at beam & around do not
include any steel increase

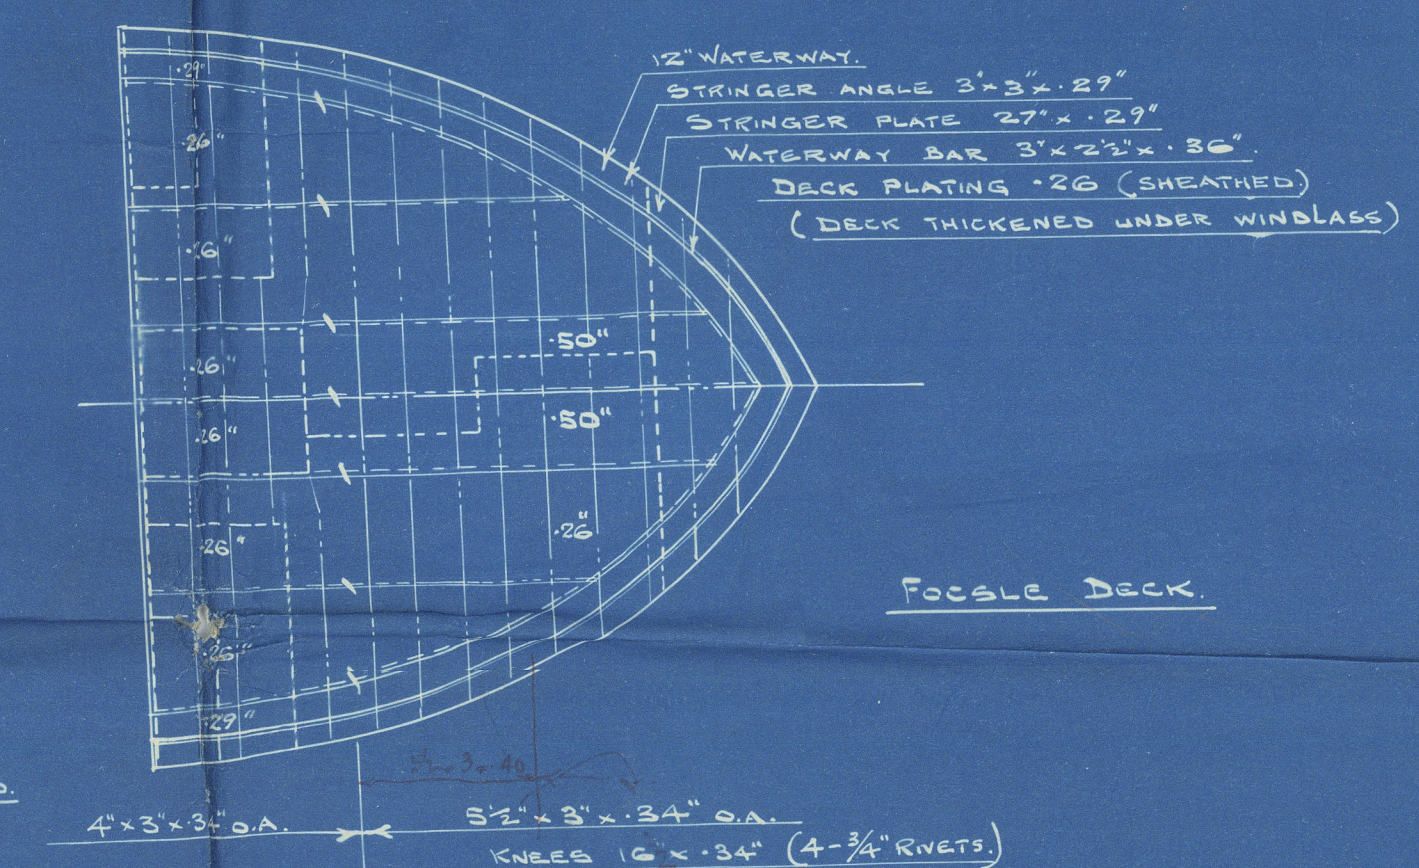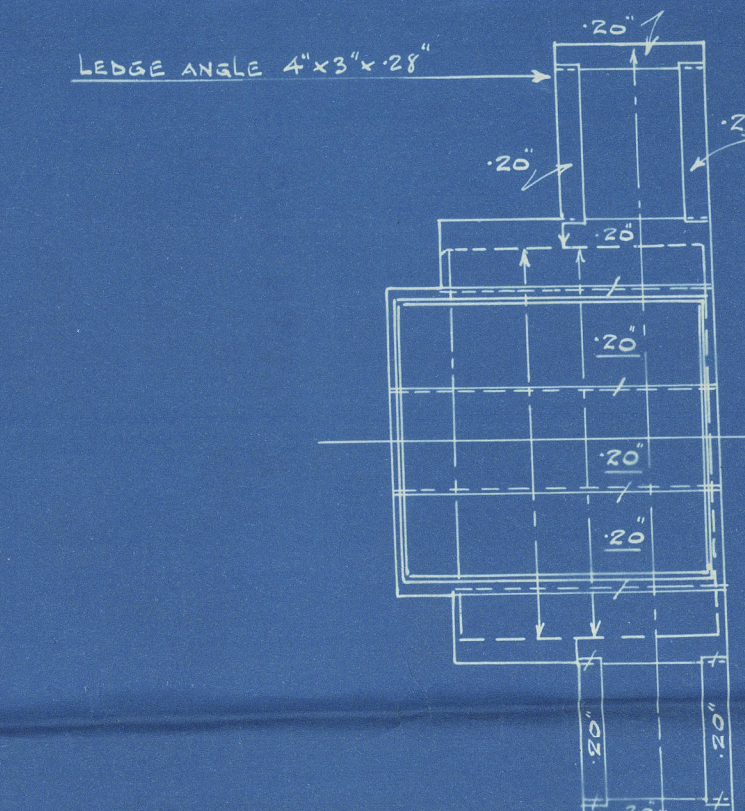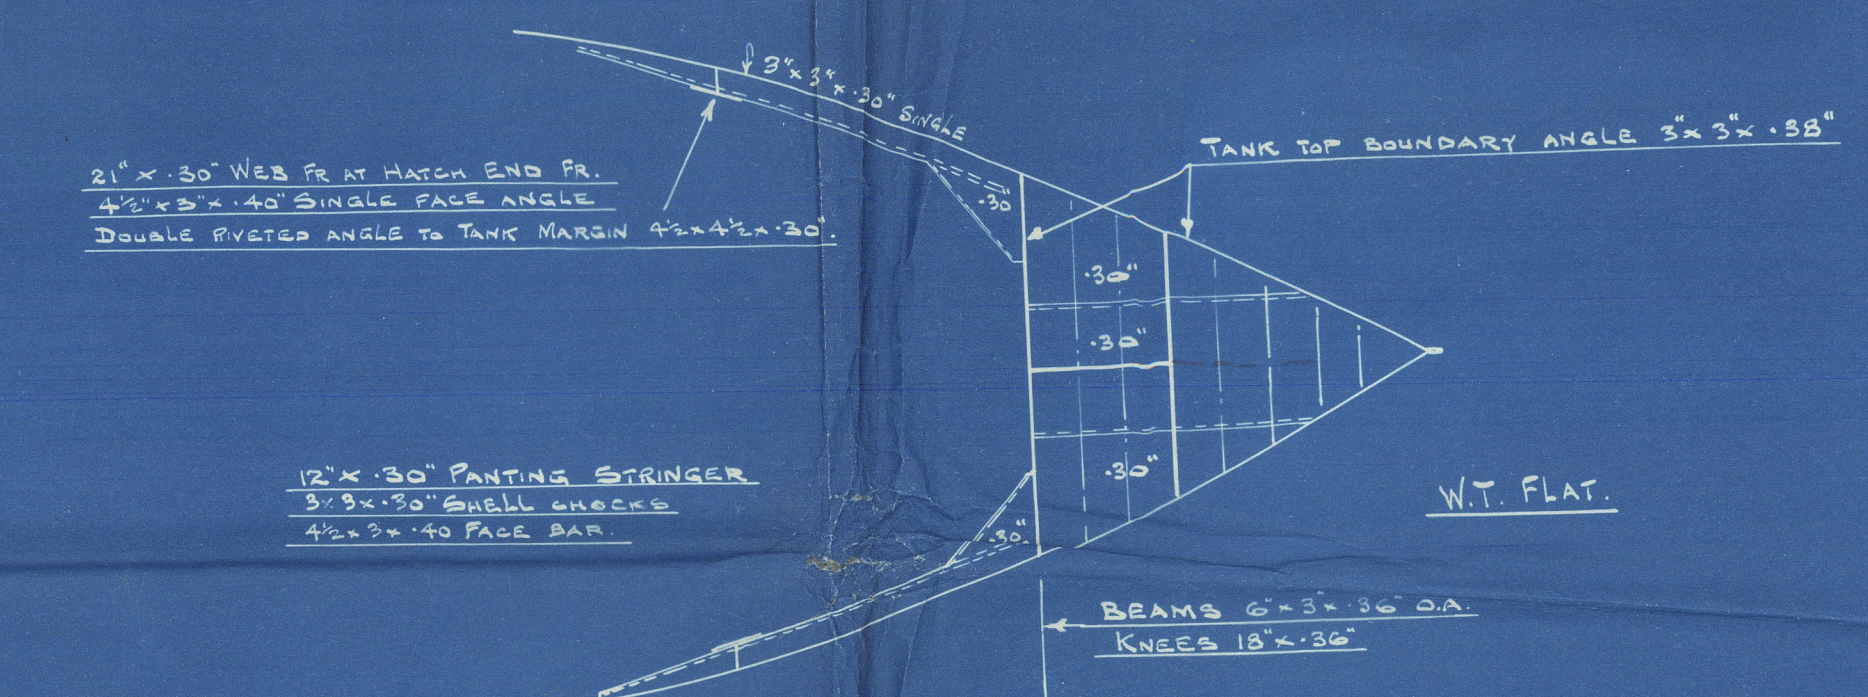


BRIDGE DECK.
LND WITH 5' x 3' P.P. WHERE EXPOSED.
1/2" TANGOID INSIDE ACCOMM.

NAVIGATING BRIDGE.
5' x 2' P.P. WHERE EXPOSED.
1/2" TANGOID INSIDE HOUSE.

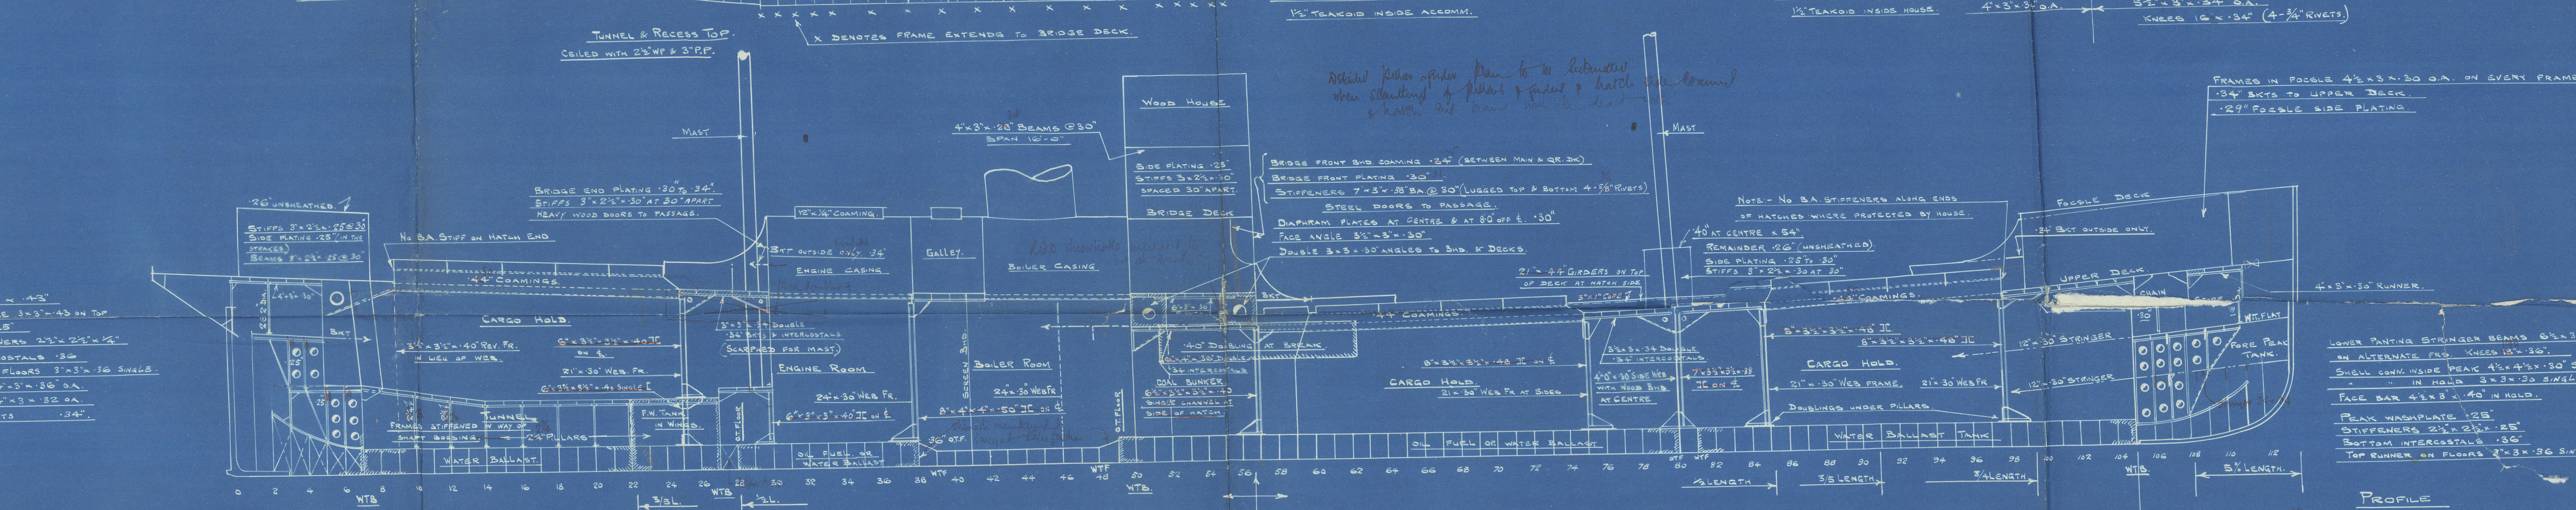


FRAMES IN FOCUS 4' x 3' x 30' O.A. ON EVERY FRAME
3/4" SKT TO UPPER DECK
1/2" FOCUS SIDE PLATING

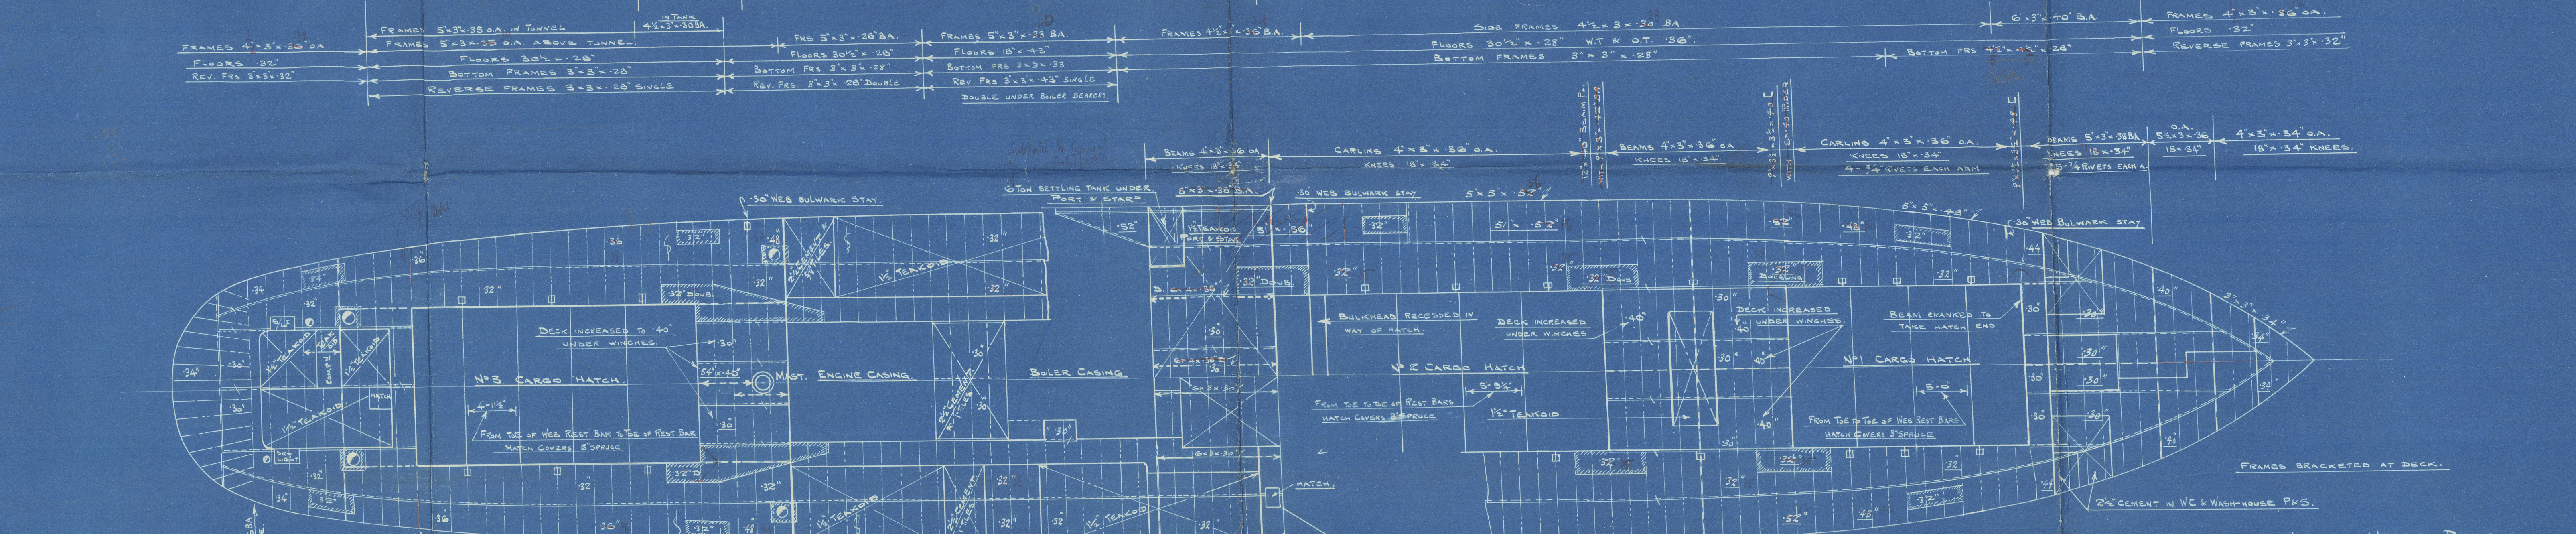

DECK LND WITH COMPOSITION, 1/2" THICK
EXCEPT IN WC & WASH-ROOMS.

UPPER DECK

QUARTER DECK

BEAMS 4' x 3' x 30' O.A. KNEES 18' x 34' KNEE

BEAMS 4' x 3' x 30' O.A. KNEES 18' x 34' KNEE

BEAMS 4' x 3' x 30' O.A. KNEES 18' x 34' KNEE

Bow, McLachlan & Co. &

No. 481.

Profile & decks.

Rata

GLASGOW REPORT No. 49329



© 2020

Lloyd's Register
Foundation

005337-005343-0034

005337-005343-0034

005337 - 005343 - 0034



© 2020

Lloyd's Register
Foundation