


24 OCT 1950

No 1203.

# STERNFRAME.

MODIFICATION AT LOWER PART  
OF APERTURE.

SCALE:  $\frac{1}{2}" = 1 \text{ FOOT}$ .

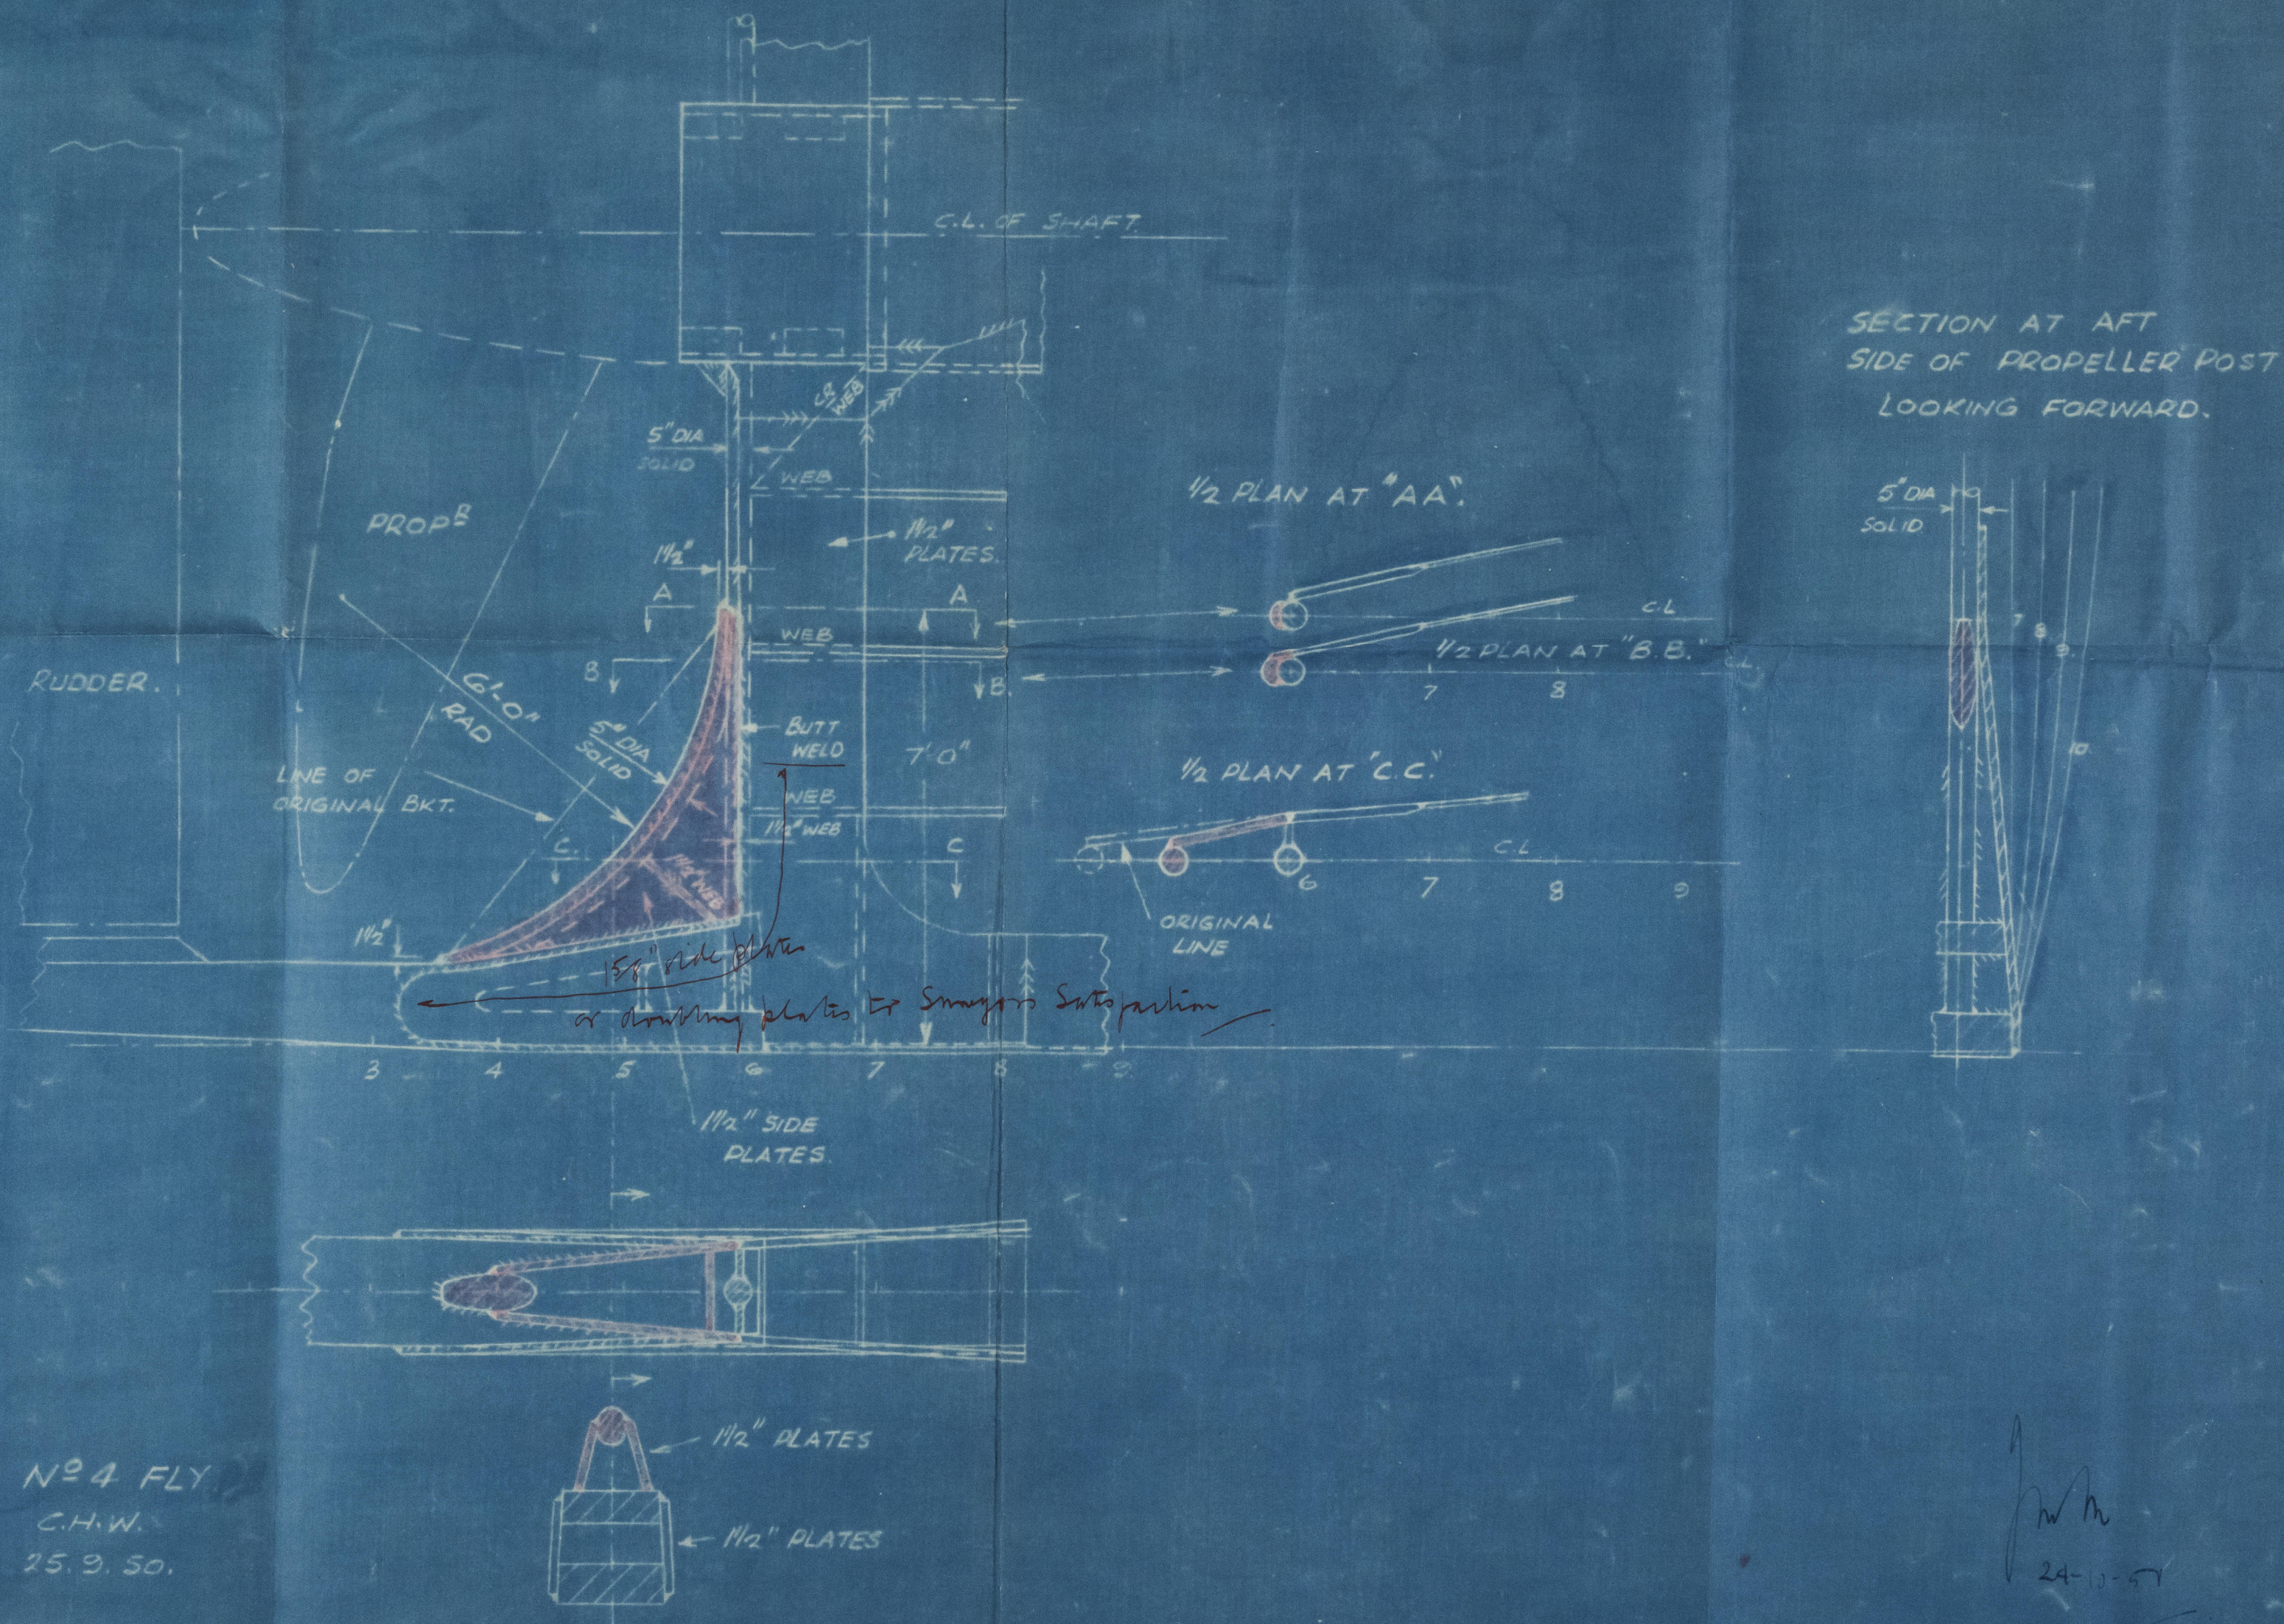



614

RECOR  
LC

PT.

Modification to (16)  
last part of Stemframe

British Crown

10 1208

Recd 11/2/51



© 2020

Lloyd's Register  
Foundation

005337-005343-0088