

SCALE:- $\frac{1}{2}" = 1$ FOOT.


TO CLASS B.S.*

FORGINGS.

STEM :- $9\frac{1}{8} \times 2\frac{3}{4}$ ✓

RUDDER POST :- $7\frac{3}{4} \times 8\frac{1}{8}$ ✓

PROPELLER " :- $9\frac{1}{8} \times 8\frac{1}{8}$ ✓

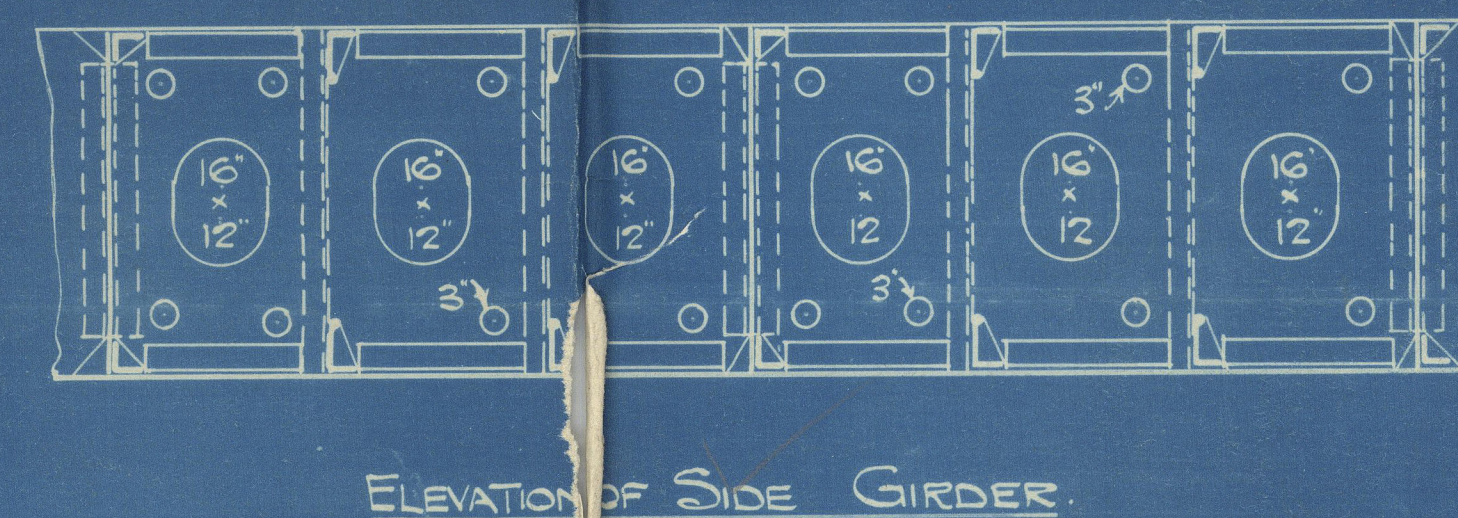

1
Midship Section.

Dr W Henderson & Co.


837^m.

J. L. 309 11/27.

19 - 11 - 27.

"Beltic Monarch"

How - But Don

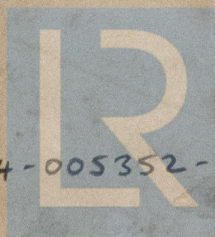

© 2020

005344-005352-0210

Lloyd's Register
Foundation