

Nos. 1431-2.

RHODESIA CASTLE

## FRAMING PROFILE. (AS FITTED)


SCALE :-  $\frac{1}{16}" = 1 \text{ FOOT.}$

DIMENSIONS :- 54'-0" B.P. x 74'-0" x 35'-6" MLD. TO "A" DECK.

DRAFT (ALL SEASONS) MLD. 28'-1"

CLASS 100 A.I.

ALL SECTIONS N.B.S.

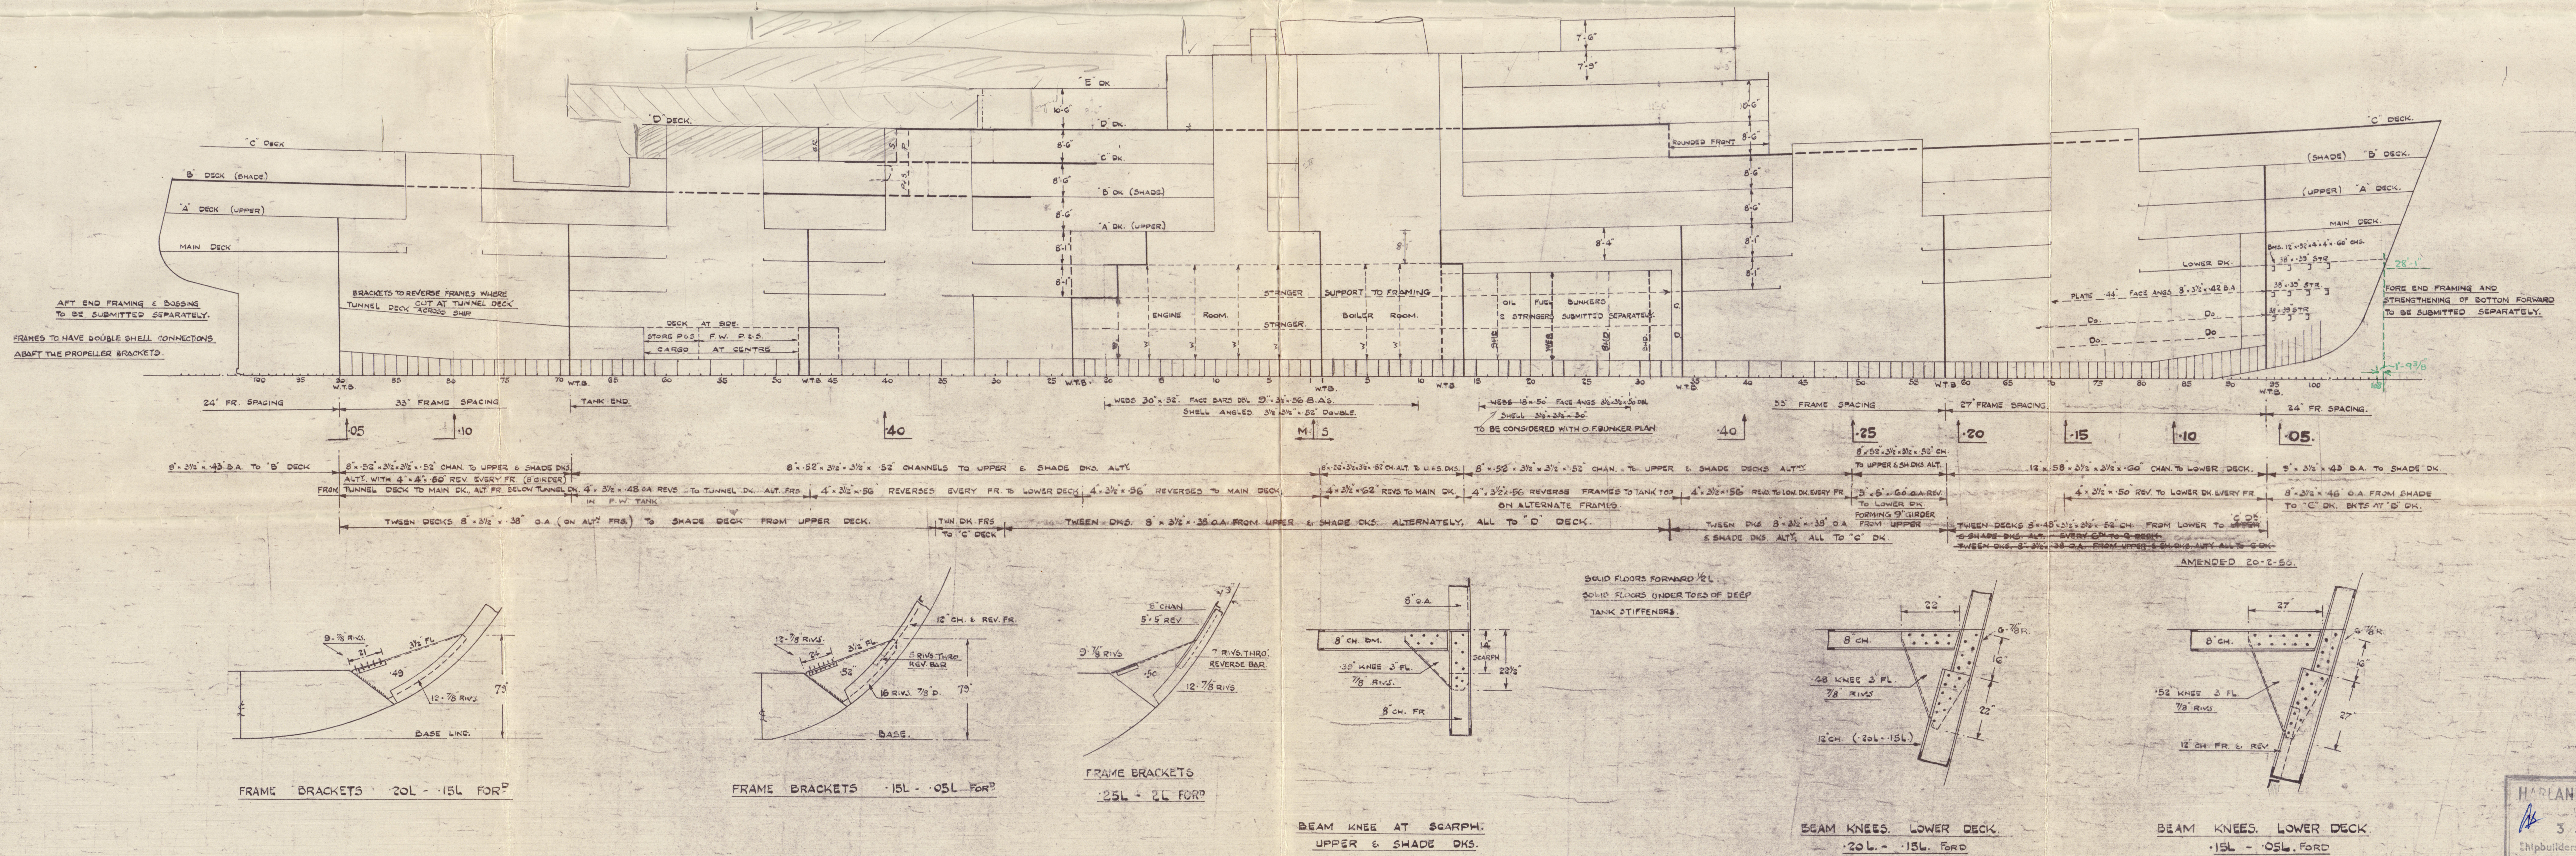

FRAMING PROFILE





"AS FITTED"

2A

HARLAND & WOLFF LTD.  
BELFAST

No. 1431 "RHODESIA CASTLE" ★

TITLE FRAMING PROFILE  
(AS FITTED PLAN)

DATE APPROVED VERIFIED 4:9:51.

Belfast Rpt. No. 15283

"Rhodesia Castle"

RECORDS DEPT.,  
LONDON

2



© 2020

Lloyd's Register  
Foundation

005353-005357-0052