

39694

30 JUN 1953

Lloyd's Register of Shipping.

Mdb. Rpt. No. 1224.


Ship's Name "LUMEN"

Official No. 183783.

Memorandum of alterations reported since ship was surveyed for assignment of Load Lines in

Alterations.

W.T. Hatch fitted on forecastle deck 3'-7" x 3'-7" with a 24" x .44" coaming fitted with a hinged W.T. steel cover with 8 toggles.
Apertures for Butterworth tank cleaning cut in upper deck as shown below, fitted with jointed brass cover plate secured by 10, 7/8" studs.

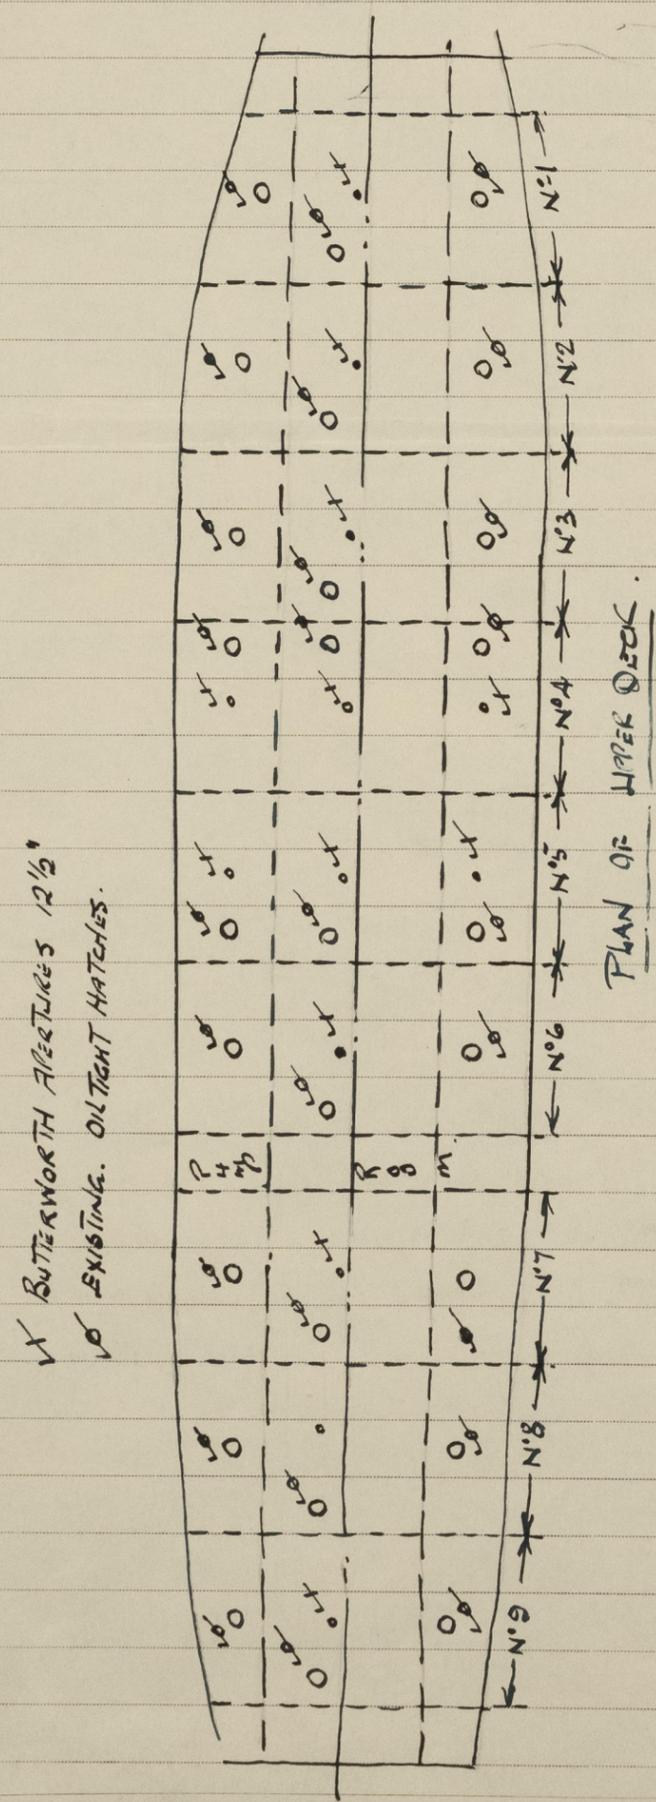

Robert L.

