


LLOYD'S NUMERALS : $L \times D = 13812$; $L * (B + D) = 38675$; $L/D = 12.78$.

BRIDGE - DECK.
LONGITUD. BEAMS: 130 x 75 x 8" m/c
BRIDGE DECK - & SIDE LONGIT.
BRACKETED TO ENDS.

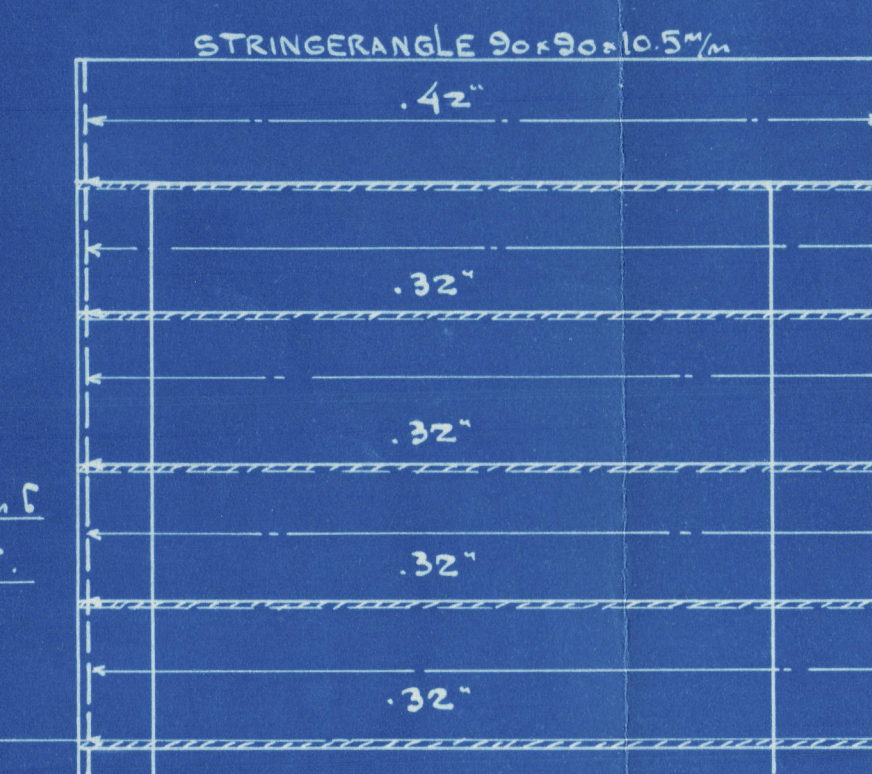

AKTIEBELSKADET
BURMEISTER & WAIN
MASKIN- & SKIDBYGGER

BYGGING NR. 594. 7/8 GARONN
TEGNING NR. 204.
TERNET AF 14
VALKERT AF
EFTERTAG AF
DATO 2-3-31.
MÅLA 1/8 ~ 1-0


PROFILE.

PROFILE & DECKS (AS BUILT)

M. TANKER GARONNE

YARD N^o 594.

MESSRS BURMEISTER & WAIN.

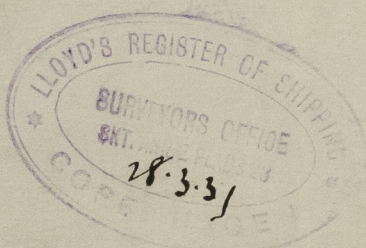

COPENHAGEN REPORT N^o 8063



© 2020

Lloyd's Register
Foundation

005353-005357-0133