



$600.5 \times 78.5 \times 45$ b-210h

F.S. Old Rules

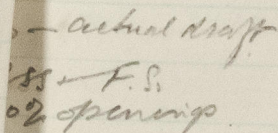

Natural Ship
18' casing

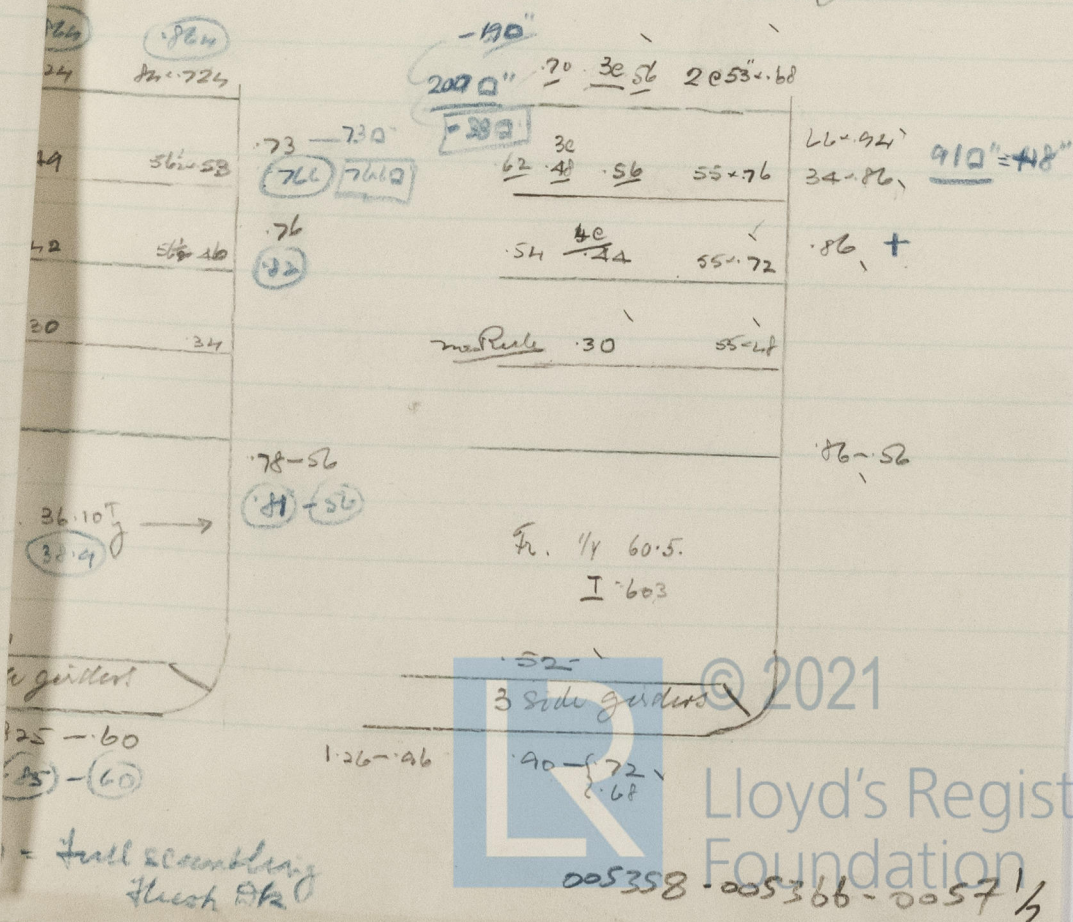

= Full scrambling
Hush OK

© 2021

Lloyd's Register
Foundation

005358-005366-0057 1/2

Quinn, med.

A with 85% E = 35-14
A flush deck = 32-6
P (37'-odup) = 29-10
between C & A = 31-5

13.86
12.33
1.53

1.427
1.53
92.69
711.5
1423
2.17719

2-8
32
6
19.2

1-7
29-10
31-5



© 2021

Lloyd's Register
Foundation

005358-005366-0057 2/2

$$\begin{array}{r} 71 \\ .68 \\ \hline 1.39 \end{array}$$

$$\begin{array}{r} 23.000 \\ 22.000 \\ \hline 1.000 \end{array}$$

$$\begin{array}{r} 21.05 \\ 10.64 \\ \hline 10.41 \end{array}$$


$$\begin{array}{r} 43 \\ .85 \\ \hline 215 \\ 344 \\ \hline 36.55 \\ 12 \\ \hline 110 \\ 45 \\ \hline 660 \end{array}$$

$$\begin{array}{r} 67.10 \\ 66.71 \\ \hline .39 \\ \hline \end{array}$$

$$\begin{array}{r} 67.48 \\ 67.10 \\ \hline .38 \end{array}$$

$$\begin{array}{r} 36' - 6\frac{1}{2}" \\ 2\frac{1}{2}" \\ \hline 36' - 9" \\ 33' - 0" \\ \hline 3' - 9" \end{array}$$

36.55.

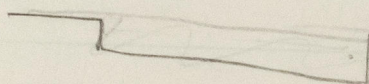

$$\begin{array}{r} 36 \\ 9 \\ \hline 45 \\ 67.86 \end{array}$$

$$\begin{array}{r} 67.48 \\ .38 \\ \hline 67.86 \end{array}$$

$$\begin{array}{r} 23700 \\ 3054 \\ \hline 26754 \end{array}$$

$$\begin{array}{r} 77.41 \\ 77.28 \\ \hline 1.13 \\ .052 \\ \hline 77.28 \\ 77.332 \\ \hline 77.33 \end{array}$$

$$\begin{array}{r} 3' - 7\frac{1}{2}" \\ 1\frac{3}{4}" \\ \hline 3' - 5\frac{3}{4}" \\ 3\frac{1}{4}" \\ \hline 2\frac{1}{2}" \end{array}$$



© 2021 Lloyd's Register Foundation