

DIMENSIONS:- 600'-0" BP ON L.W.L. x 73'-6" x 45'-0" MLD. TO 'D' DECK



DECK PLANS. SHEET 1.

SCALE $\frac{1}{8} = 1$ FOOT.


CLASS:- LLOYDS 100.A.1. SHELTER DK. WITH FREEBOARD. SPECIAL SURVEY.



BOAT DECK.

BOAT DECK BEAMS $6 \times 3 \times 34$ 3 AB WHERE 22-0 SPAN
6 $\times 3 \times 40$ ANGLED ELBOWHERE
KNEES 15×40

CORR. ROOF BEAMS $5 \times 2 \times 34$ 3 AB
KNEES 12×40

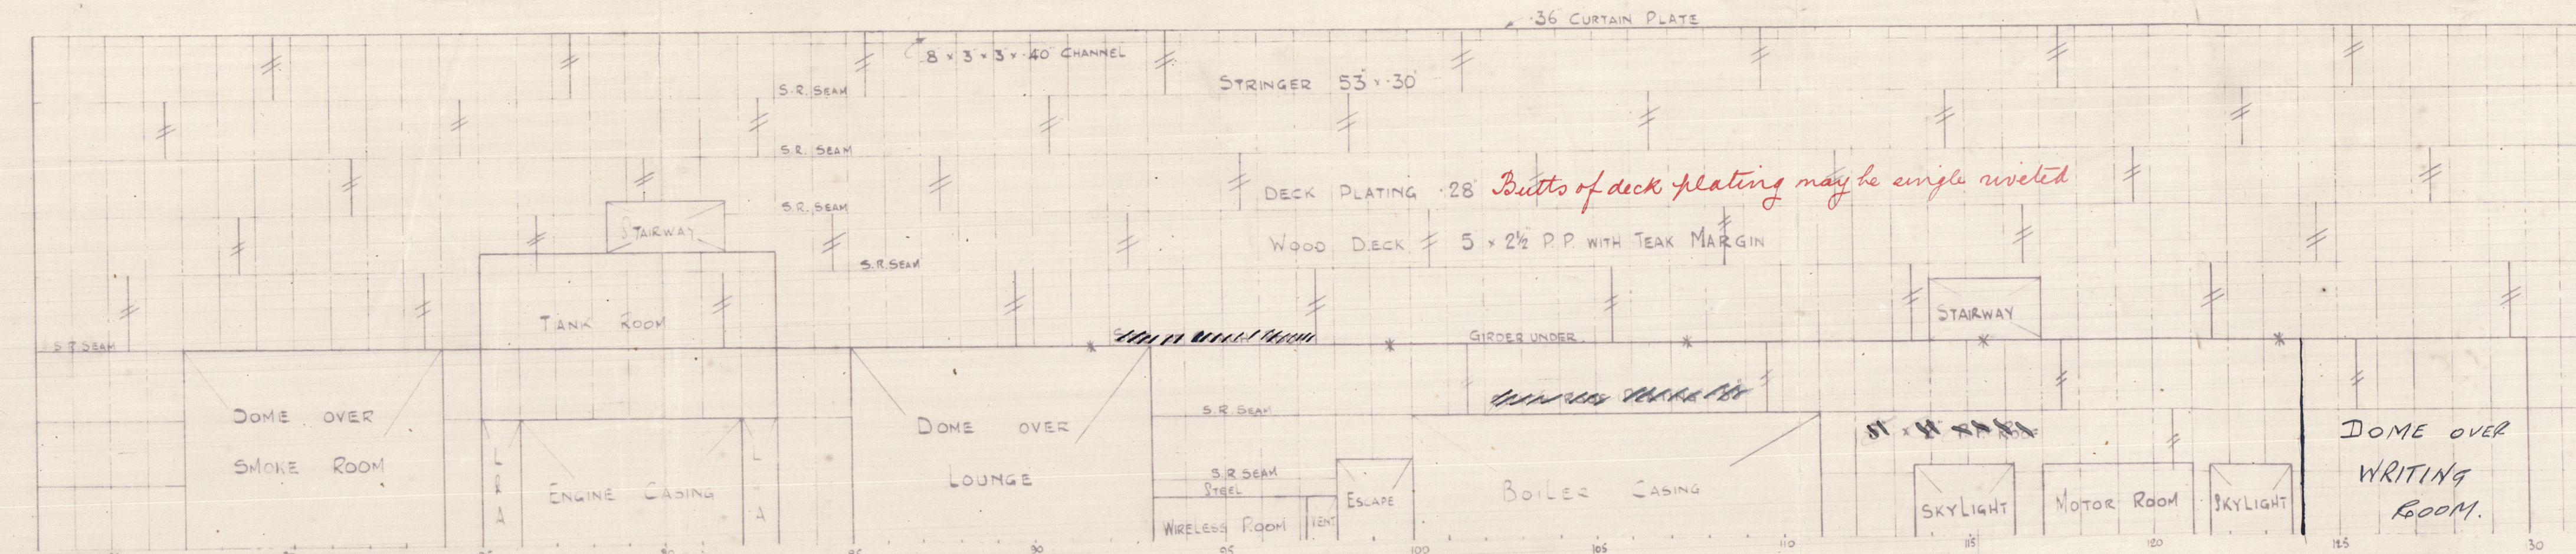

BOAT DECK:

A DECK

"A" DECK.

'B' DECK.

B DECK BEAMS: 9' 3" x 12" x 40 CHANNELS ON EVERY FRAME IN WAY OF BRIDGE SIDE PLATING
KNEES 32, 50 HATCH END BEAMS SIMILAR
7' 3" x 12" x 40 B.L.s ON EVERY FRAME CLEAR OF BRIDGE SIDE PLATING
KNEES 15, 40 HATCH END BEAMS SIMILAR

"B" DECK

C DECK

C DECK BEAMS 9' x 3 1/2' x 3/4' x 40' CHANNELS ON EVERY FRAM. HATCH END BEAMS SIMILAR
KNEES 32' x 50'

C DECK.

Ct.
13-12-18

Vickers L?


No 493 ~~498~~

Deck Plans (Boat. A.B.C.)

L. S. S. Seythia
Bow. 1892

Vickers for No 526.
T.S.S. CARINTHIA

Bow 1st Entry Report
 No 2147

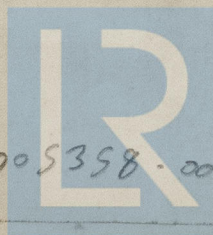

© 2021

Lloyd's Register
 Foundation

005358-005366-0102