

S. S. N^o 373.
STERN POST & RUDDER.

SCALE $\frac{1}{2}$ INCH = 1 FOOT.

STERN POST & RUDDER TO BE "FORGED SCRAP
STEEL", ALL TO LLOYD'S TESTS.

LONGITUDINAL NUMBER 13516

TOTAL AREA OF RUDDER F. A = 78' 2 5/8 FT.

CENTRE OF GRAVITY ABAFT C.R. LINE OF PINTLES D. = 2' 8 1/2 FT ✓

A x D = 223

SPEED OF SHIP = 11 1/2 KNOTS ✓

DIA^s OF RUDDER HEAD 7' 1/4 ✓

RIVETS IN STERN POST 1 DIA^s SPACED 5' APART OR TO CR HOLES 1 1/2 DIA^s

RIVETS ABOVE GUNTER 3/4 DIA^s " 3/4 " " " " 1 3/16 "


CENTRE LINE OF SHAFT

✓ 7'-10" ABOVE BASE AT FRAME 1

✓ 5'-7" ABOVE BASE AT FRAME 51

✓ DOOP OF SHAFT 2818 PER FOOT

SECTION OF BOSS

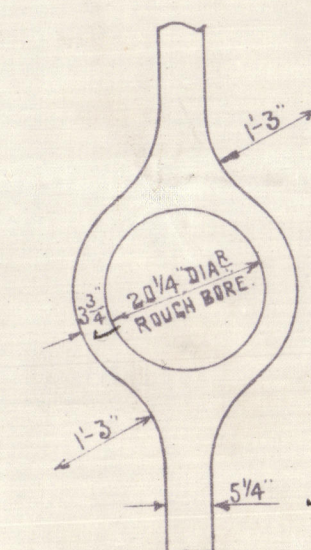

SECTIONS OF HEEL WILL BE SUPPLIED BY LOFT

Ailsa Cos.


No. 373.

Rudder & Sternframe.

S.S. 'DRAKE'

GLASGOW REPORT NO.

41735.

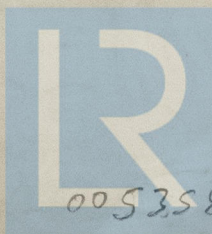

© 2021

Lloyd's Register
Foundation

005358-005366-0121