


S.S. DRAKE

NEW HATCH ABAFT FOREMAST


SCALE  $\frac{1}{2}" = 1 \text{ FOOT}$

9/8/34

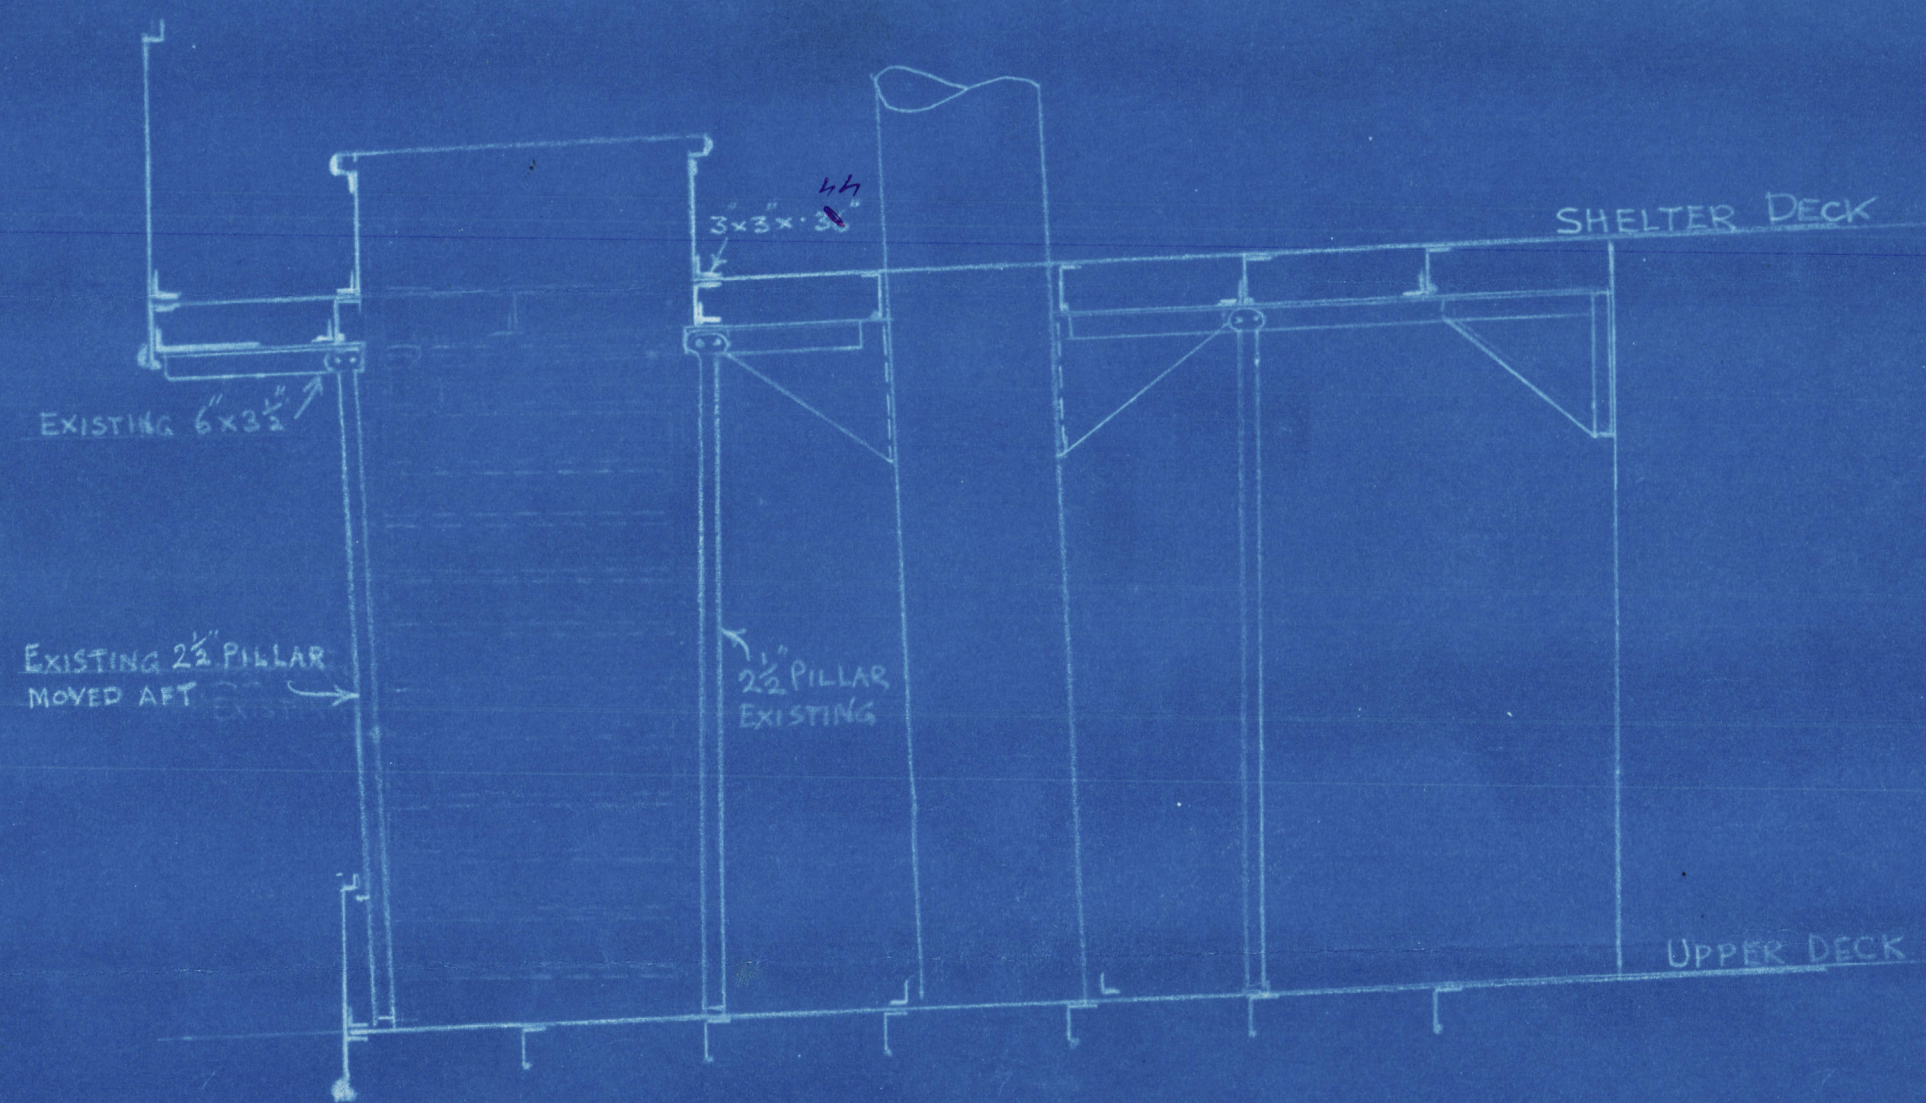


ELEVATION


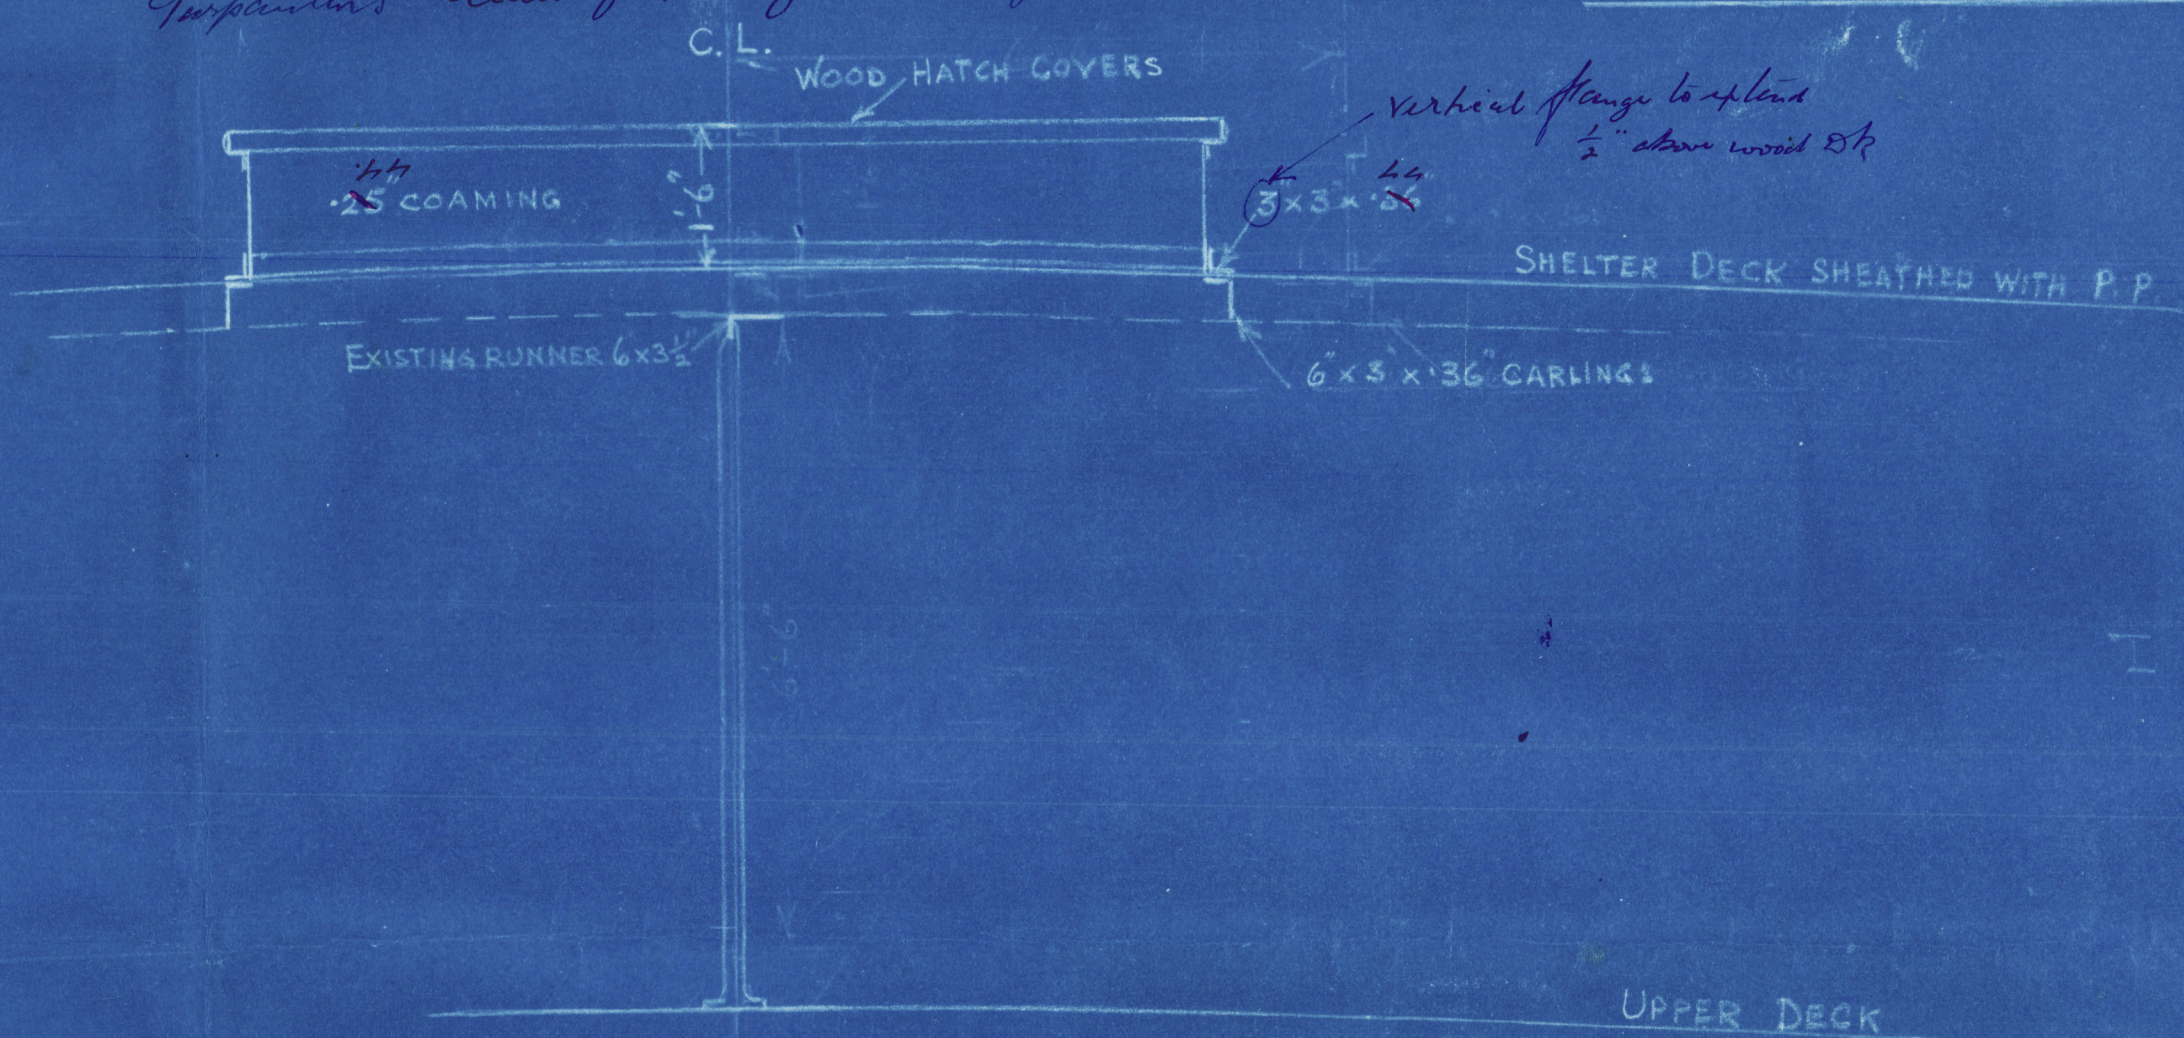

SECTION LOOKING FORWARD

No. 2  
HATCH

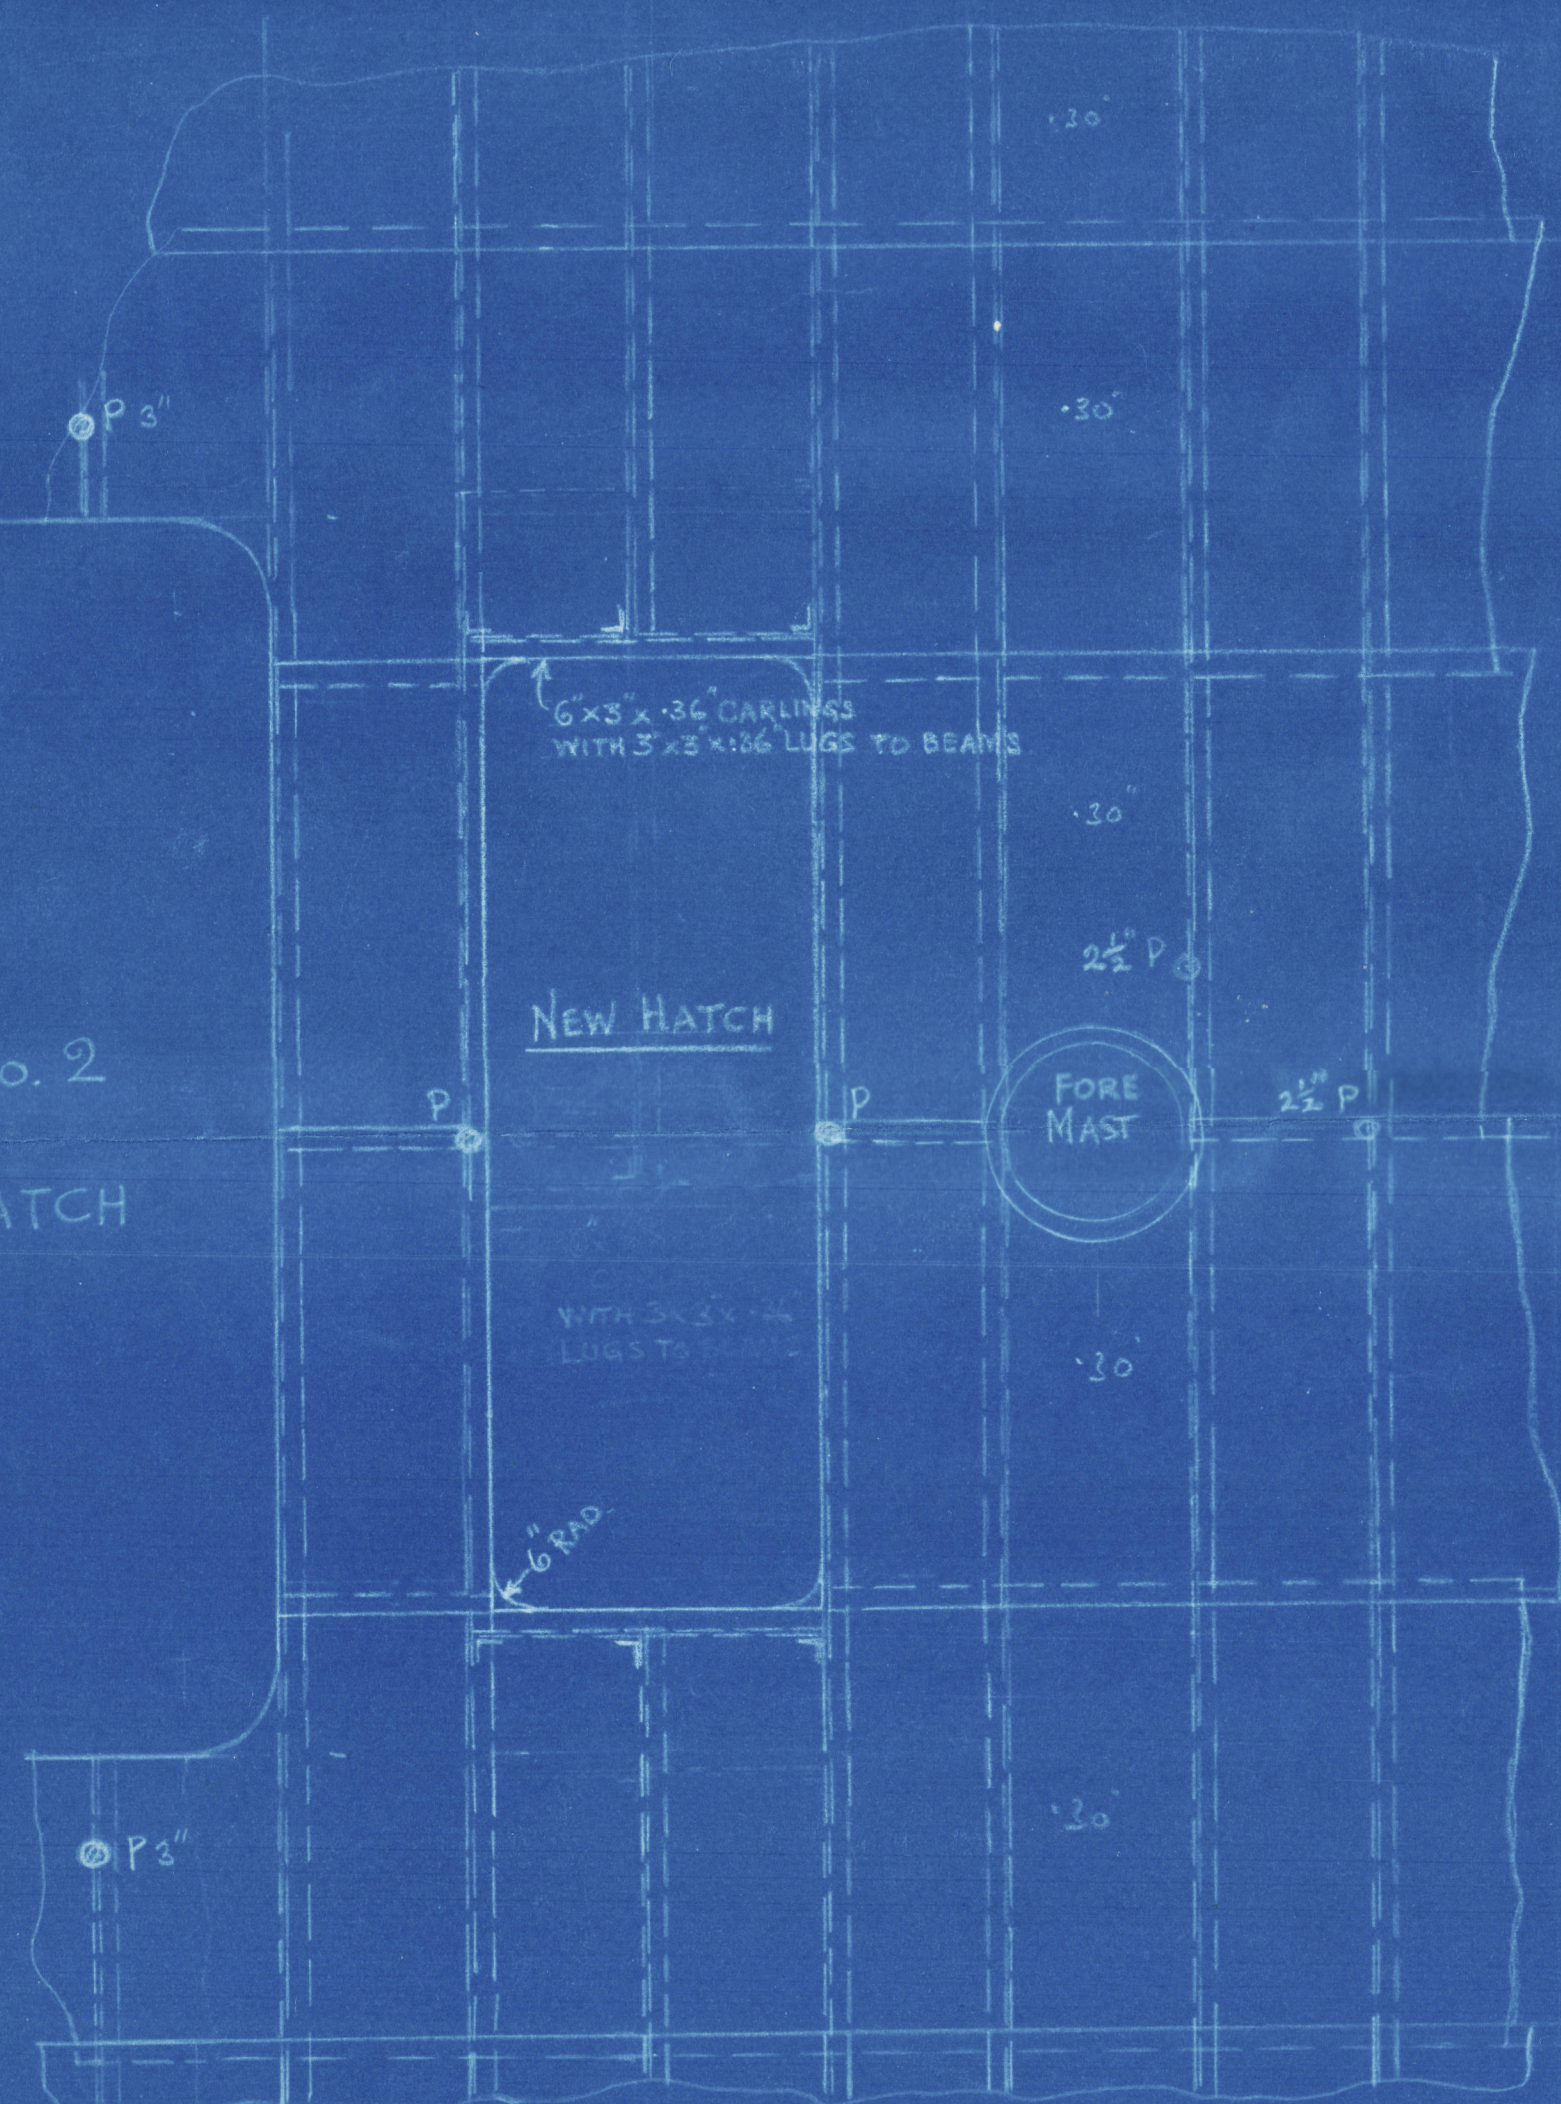

PLAN - SHELTER DECK

9.8.34

R. & H. GREEN AND SILLEY WEIR, LTD.	
GENERAL OFFICES: 10 A.D., LONDON, E.	
STAFF DRAWING OFFICE	
DRAWING NUMBER 16478	STORAGE D.41
DRAWN BY C. J. G.	DATE 7/8/34
CHECKED BY R.	

005358-005366-0122



DRANE

ALTERATIONS

HATCH IN WAY OF FOREMART

8/5 "Drake"

London Report No. 100640



© 2021

Lloyd's Register  
Foundation

005358-005366-0122