

# MIDSHIP SECTION.

## STEEL SCREW TRAWLER.

No. 1117.

DIMNS: 150'-0" B.P. x 25'-6" MLD. x 14'-6" MLD.

SCALE 1/2" = 1 FOOT.

TO CLASS  $\nabla$  100 A.I. STEAM TRAWLER.

### EQUIPMENT.

1 <sup>ST</sup> BOWER ANCHOR	8 3/4 CWTs	STOCKLESS.
2 <sup>ND</sup> "	8 1/4 "	"
KEDGE	3 1/2 "	EX. STOCK.
120 FATHOMS	1 3/16	STUD LINK CABLE.
60 "	6 "	HAWSER.
60 "	5 1/2 "	WARD.


### NUMERALS.

L x D. ----- 2175.  
L x (B + D) ----- 6000.

### RIVETING.

ALL LANDING EDGES TO BE DOUBLE RIVETED EXCEPT TOP EDGE OF SHEERS/RAKE, WHICH SHALL BE SINGLE RIVETED.  
BUTTS OF GARBOARD & SHEERS/RAKE STRAPPED & TREBLE RIVETED FOR 1/2 LENGTH.  
BUTTS OF E.A.F. STRAKES OVERLAPPED & TREBLE RIVETED FOR 1/2 LENGTH.  
REMAINDER TO BE OVERLAPPED & DOUBLE RIVETED FORE & AFT.

PLAN No. 1142.  
FOR ENGINEERING  
Messrs. Lloyd's Register of Shipping  
Shell  
DATE 17-10-23

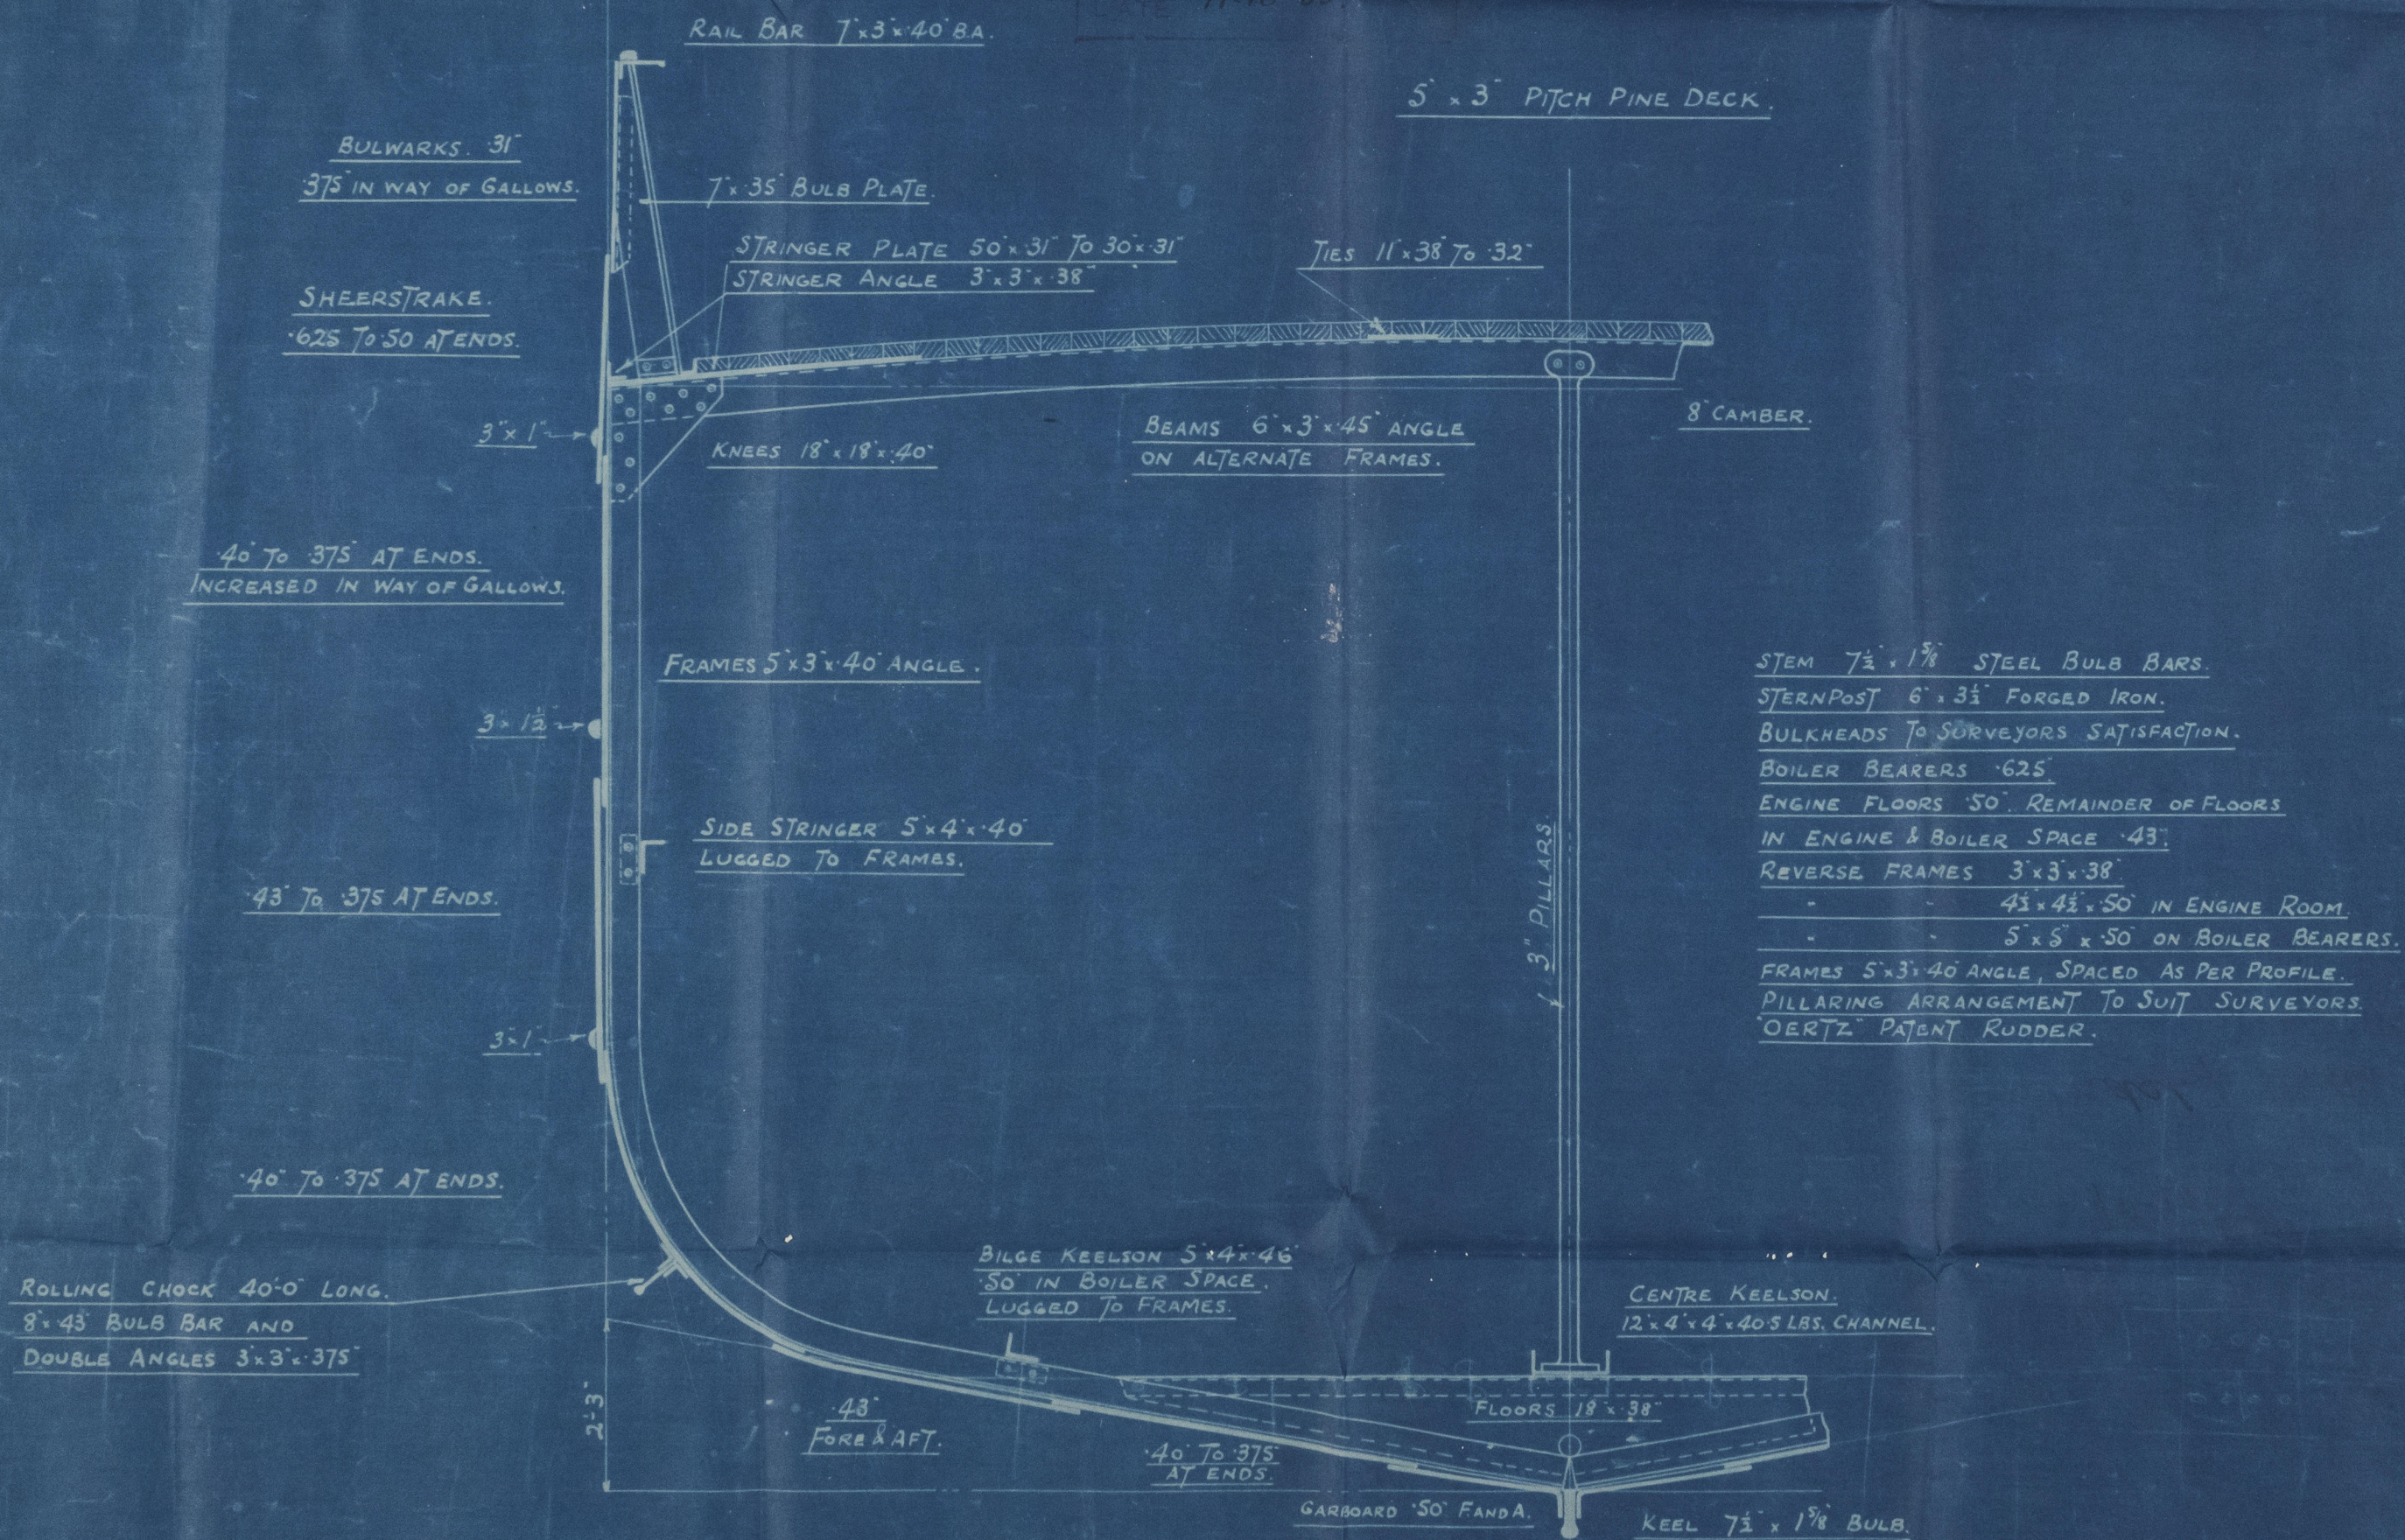



No 1117  
Profile & Deck  
Plan (as built)  
Cochrane & Sons Ltd.

S.S.

Lord Plender

HULL REPORT No.

44160

RETAIN



© 2020

Lloyd's Register  
Foundation

005367-005376-0129