


Sea Speed assumed 17 knots.

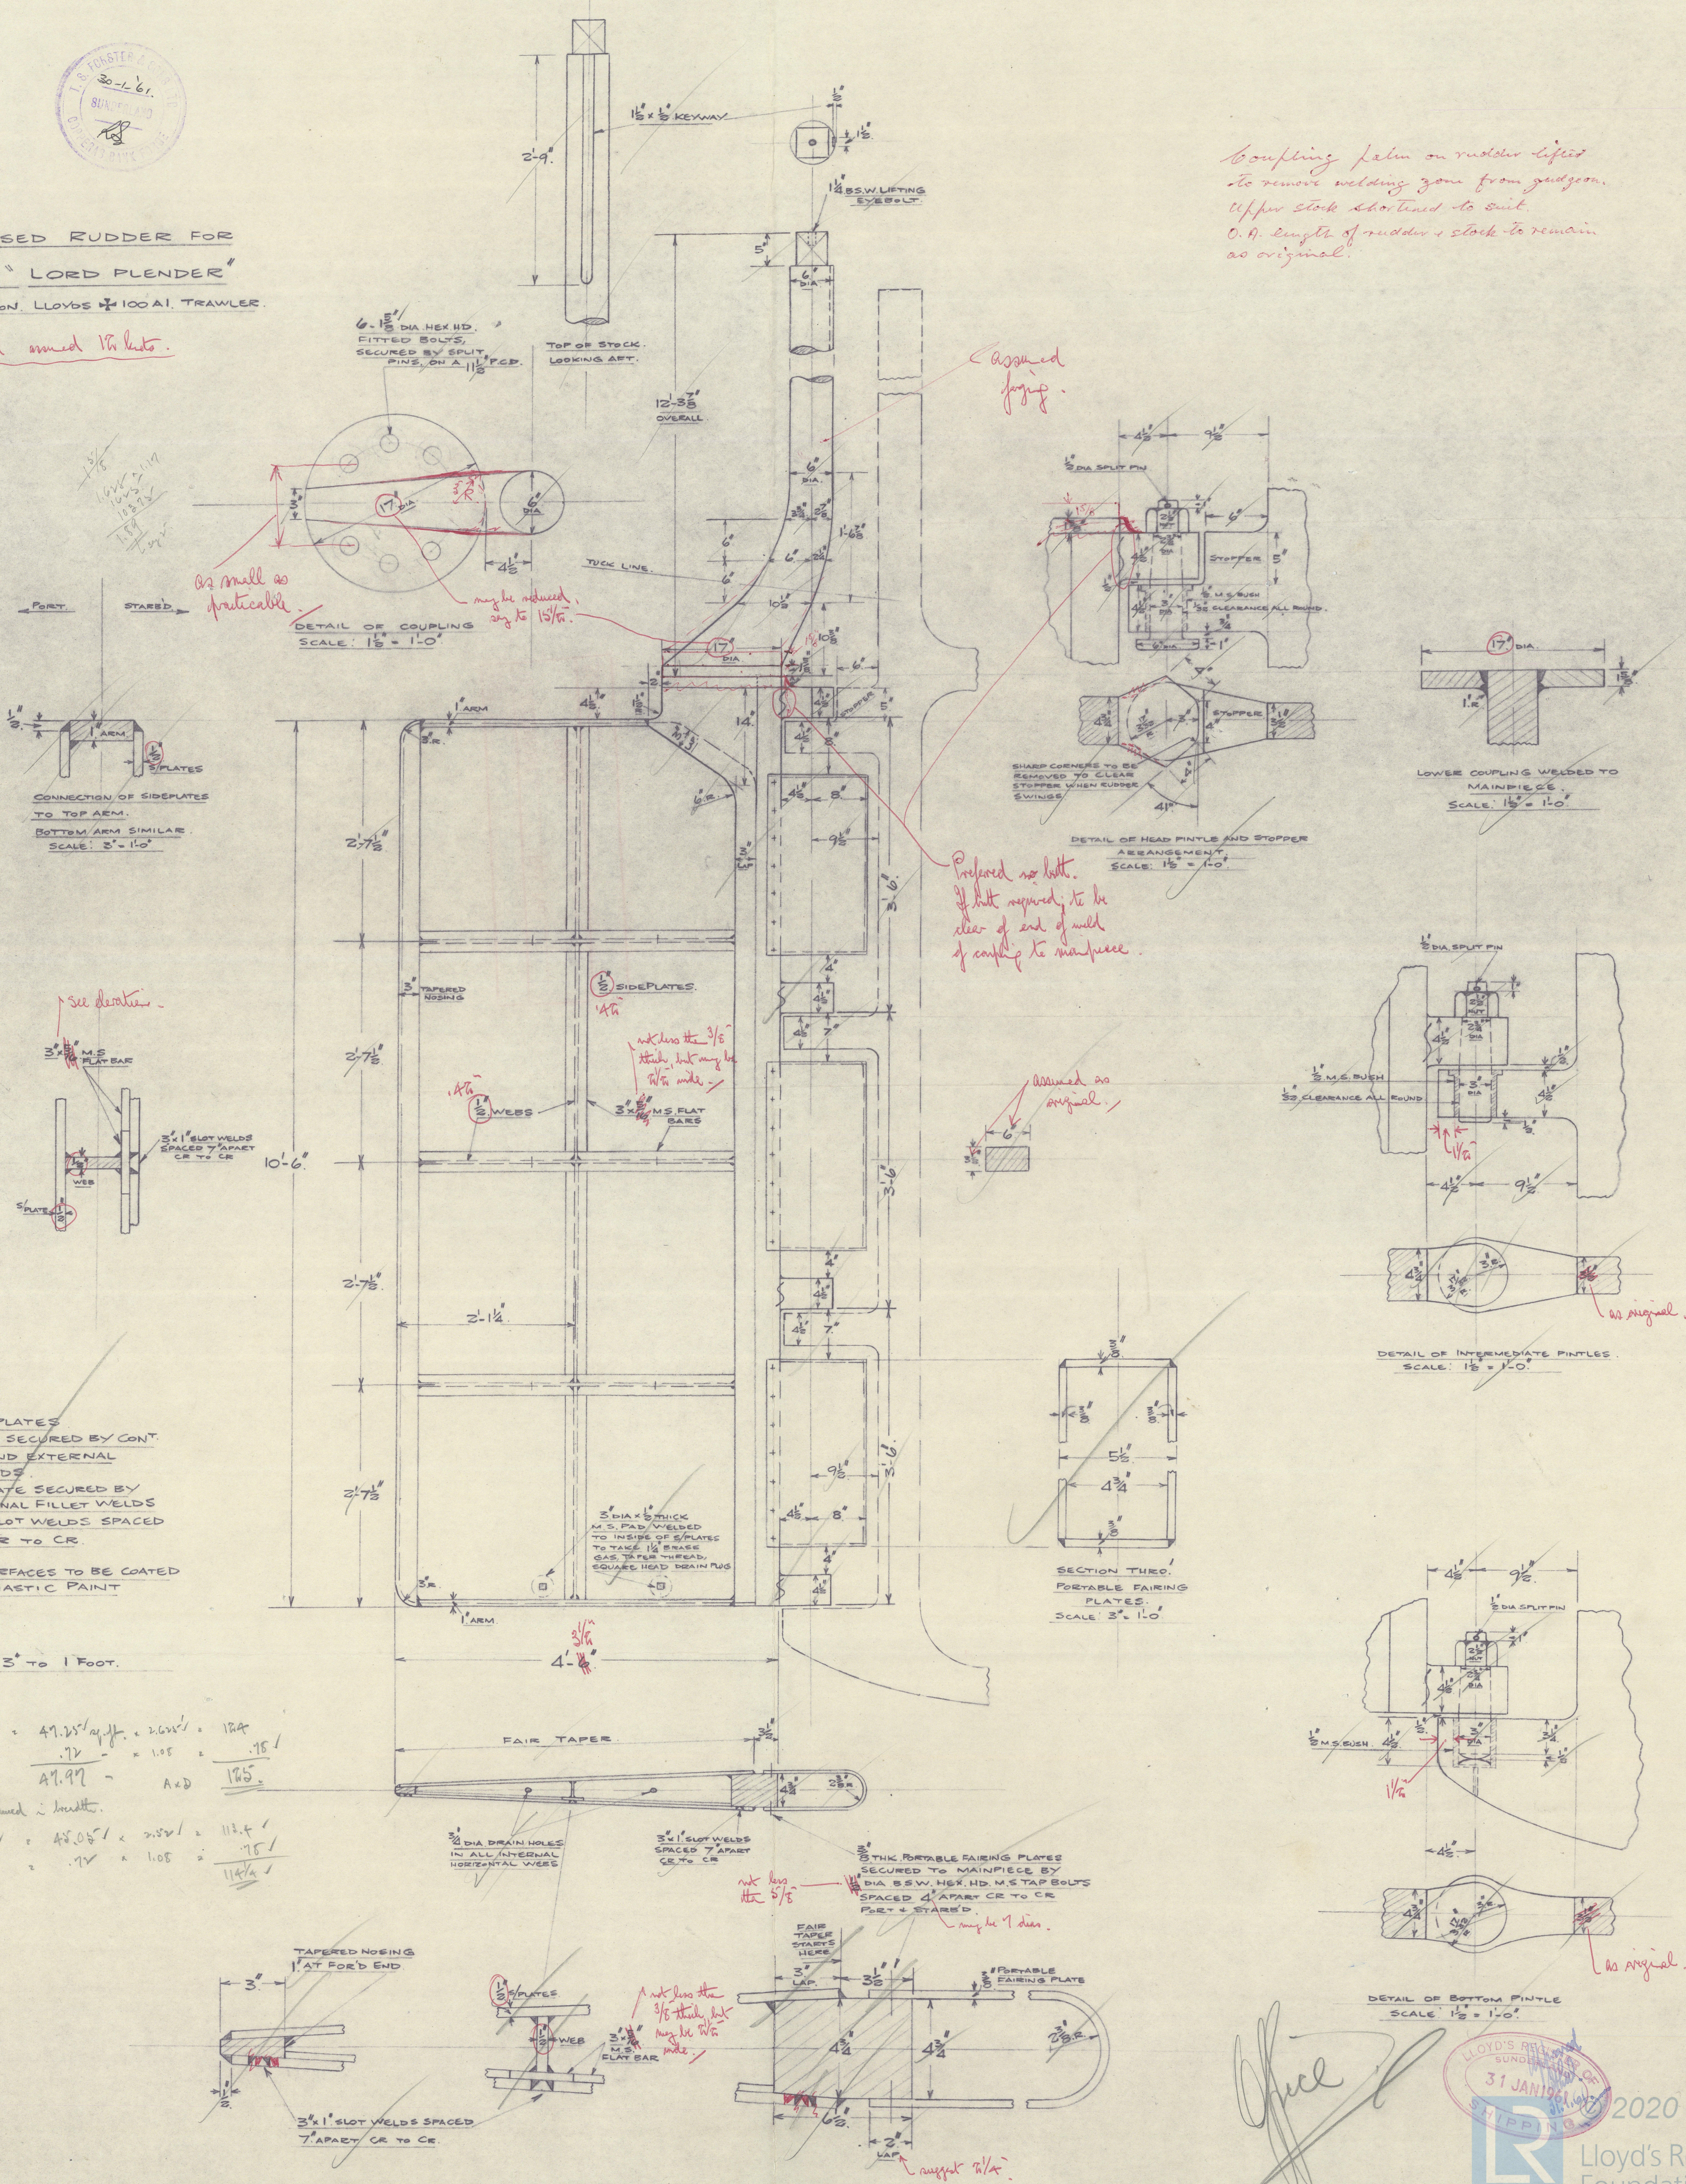

Coupling Palm on rudder lifts  
to remove welding zone from gudgeon.  
Upper stock shortened to suit.  
O. A. length of rudder & stock to remain  
as original.

- Preferred no butt.  
If butt required; to be  
clear of end of weld  
of coupling to main piece.

Assumed as original.

as original

Las original

2020

Lloyd's Register  
Foundation

005367-005376-0151

S/T. "LORD PLENDER".

Proposed Rudder.

SS/~~MS~~ "LORD PLENDER"

TO ACCOMPANY LIV. Rpt. No. 156350  
(FTWOOD)

Dated 29/3/61.

SUBJECT:- Rudder plan (app. Sld).



© 2020

Lloyd's Register  
Foundation

005367-005376-0151