


20 MAR 1949

-T.S.S. AUTOCARRIER- -MAIN - DECK - PLAN- -SCALE 1/4" = 1 FOOT.-

-DIMENSIONS:- 220'0" x 35'6" x 15'0" TO MAIN DECK.-


 


DRG: N° A 345

'AUTO CARRIER'★

Main deck plan.

RECORDS DEPT..
LONDON

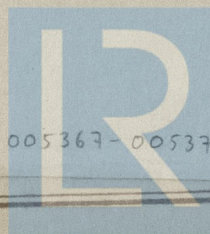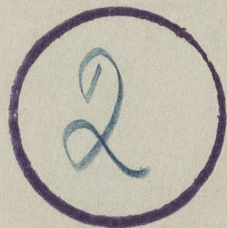

© 2020

005367-005376-0152

Lloyd's Register
Foundation

17.3
 17.3
 17.0
 17.0
 16.6
 7.0
 8.5

 160.7

10.5
 10.0
 9.3
 8.7
 8.0
 7.0

 13.0

3-500

3000
 750

 3750
 1500



© 2020

Lloyd's Register
Foundation

$$\begin{array}{r}
 .45 \\
 .27 \\
 \hline
 .18
 \end{array}
 \begin{array}{r}
 20 \\
 056 \\
 \hline
 .112
 \end{array}$$

$$\begin{array}{r}
 127 \\
 11 \\
 \hline
 116
 \end{array}$$

$$\begin{array}{r}
 .12 \\
 .024 \\
 \hline
 .048 \\
 .46 \\
 \hline
 .508
 \end{array}$$



© 2020

Lloyd's Register
Foundation