


DETAIL OF BUTT WELDING.

ROUTING:
 IN DECK LONGS: 1 7/8" R.V. SPACED 6" DIAM.
 IN SEAMS ABOVE 18 1/4": 1" R.V. SPACED 4" DIAM.
 IN SEAMS ABOVE 18 1/4" AND NOT EXCEEDING
 18 7/8": 3/8" R.V. SPACED 4" DIAM.
 IN SEAMS NOT EXCEEDING 18 1/4": 3/8" R.V. SPACED 4" DIAM.
 IN DECK TRANSVERSES: 3/8" R.V. SPACED 5" DIAM.

DIMENSIONS OF:
 O.T. HATCHES 1370 x 1070 mm
 PUMPOOM OPENINGS 1380 x 1337 mm
 G.T. CARGO HATCH 2460 x 2080 mm

 

LLoyds
 NEDERLANDSCHE SCHEEPSBOUWMAATSCHAPPIJ
 AMSTERDAM.
 WERFNUMMER. 272 TANKER
 273
 SCHAAAL 1/100, 1/1
 GEPOZET EN BESTELD 2 1/2 38 1/2
 GEALOUWERD
 GEZIEN
 GEZIEN CHEF VAN TEKENK. NO. A 12

LONDON COPY.

GEN. BOX NO.

591

~~5521~~

13

NEDERLANDSCHE SCHEEPSTB. MY.

Nos. 272-3

(15,000 TONS TANKERS FOR
ANGLO-SAXON PETR. CO.)


~~PROCESSED BY~~

UPPER DECK.

TIBIA

RETAIN

005377-005386-0026

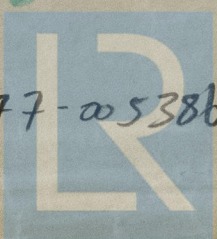

© 2021

Lloyd's Register
Foundation