


S.S. "HALLADALE"

REG. DIM. 130.0' x 23.2' x 9.5'

PROPOSED SAND HOLD

SCALE $\frac{1}{4}" = 1 \text{ FOOT}$

130 - 23 - 10 1/2'

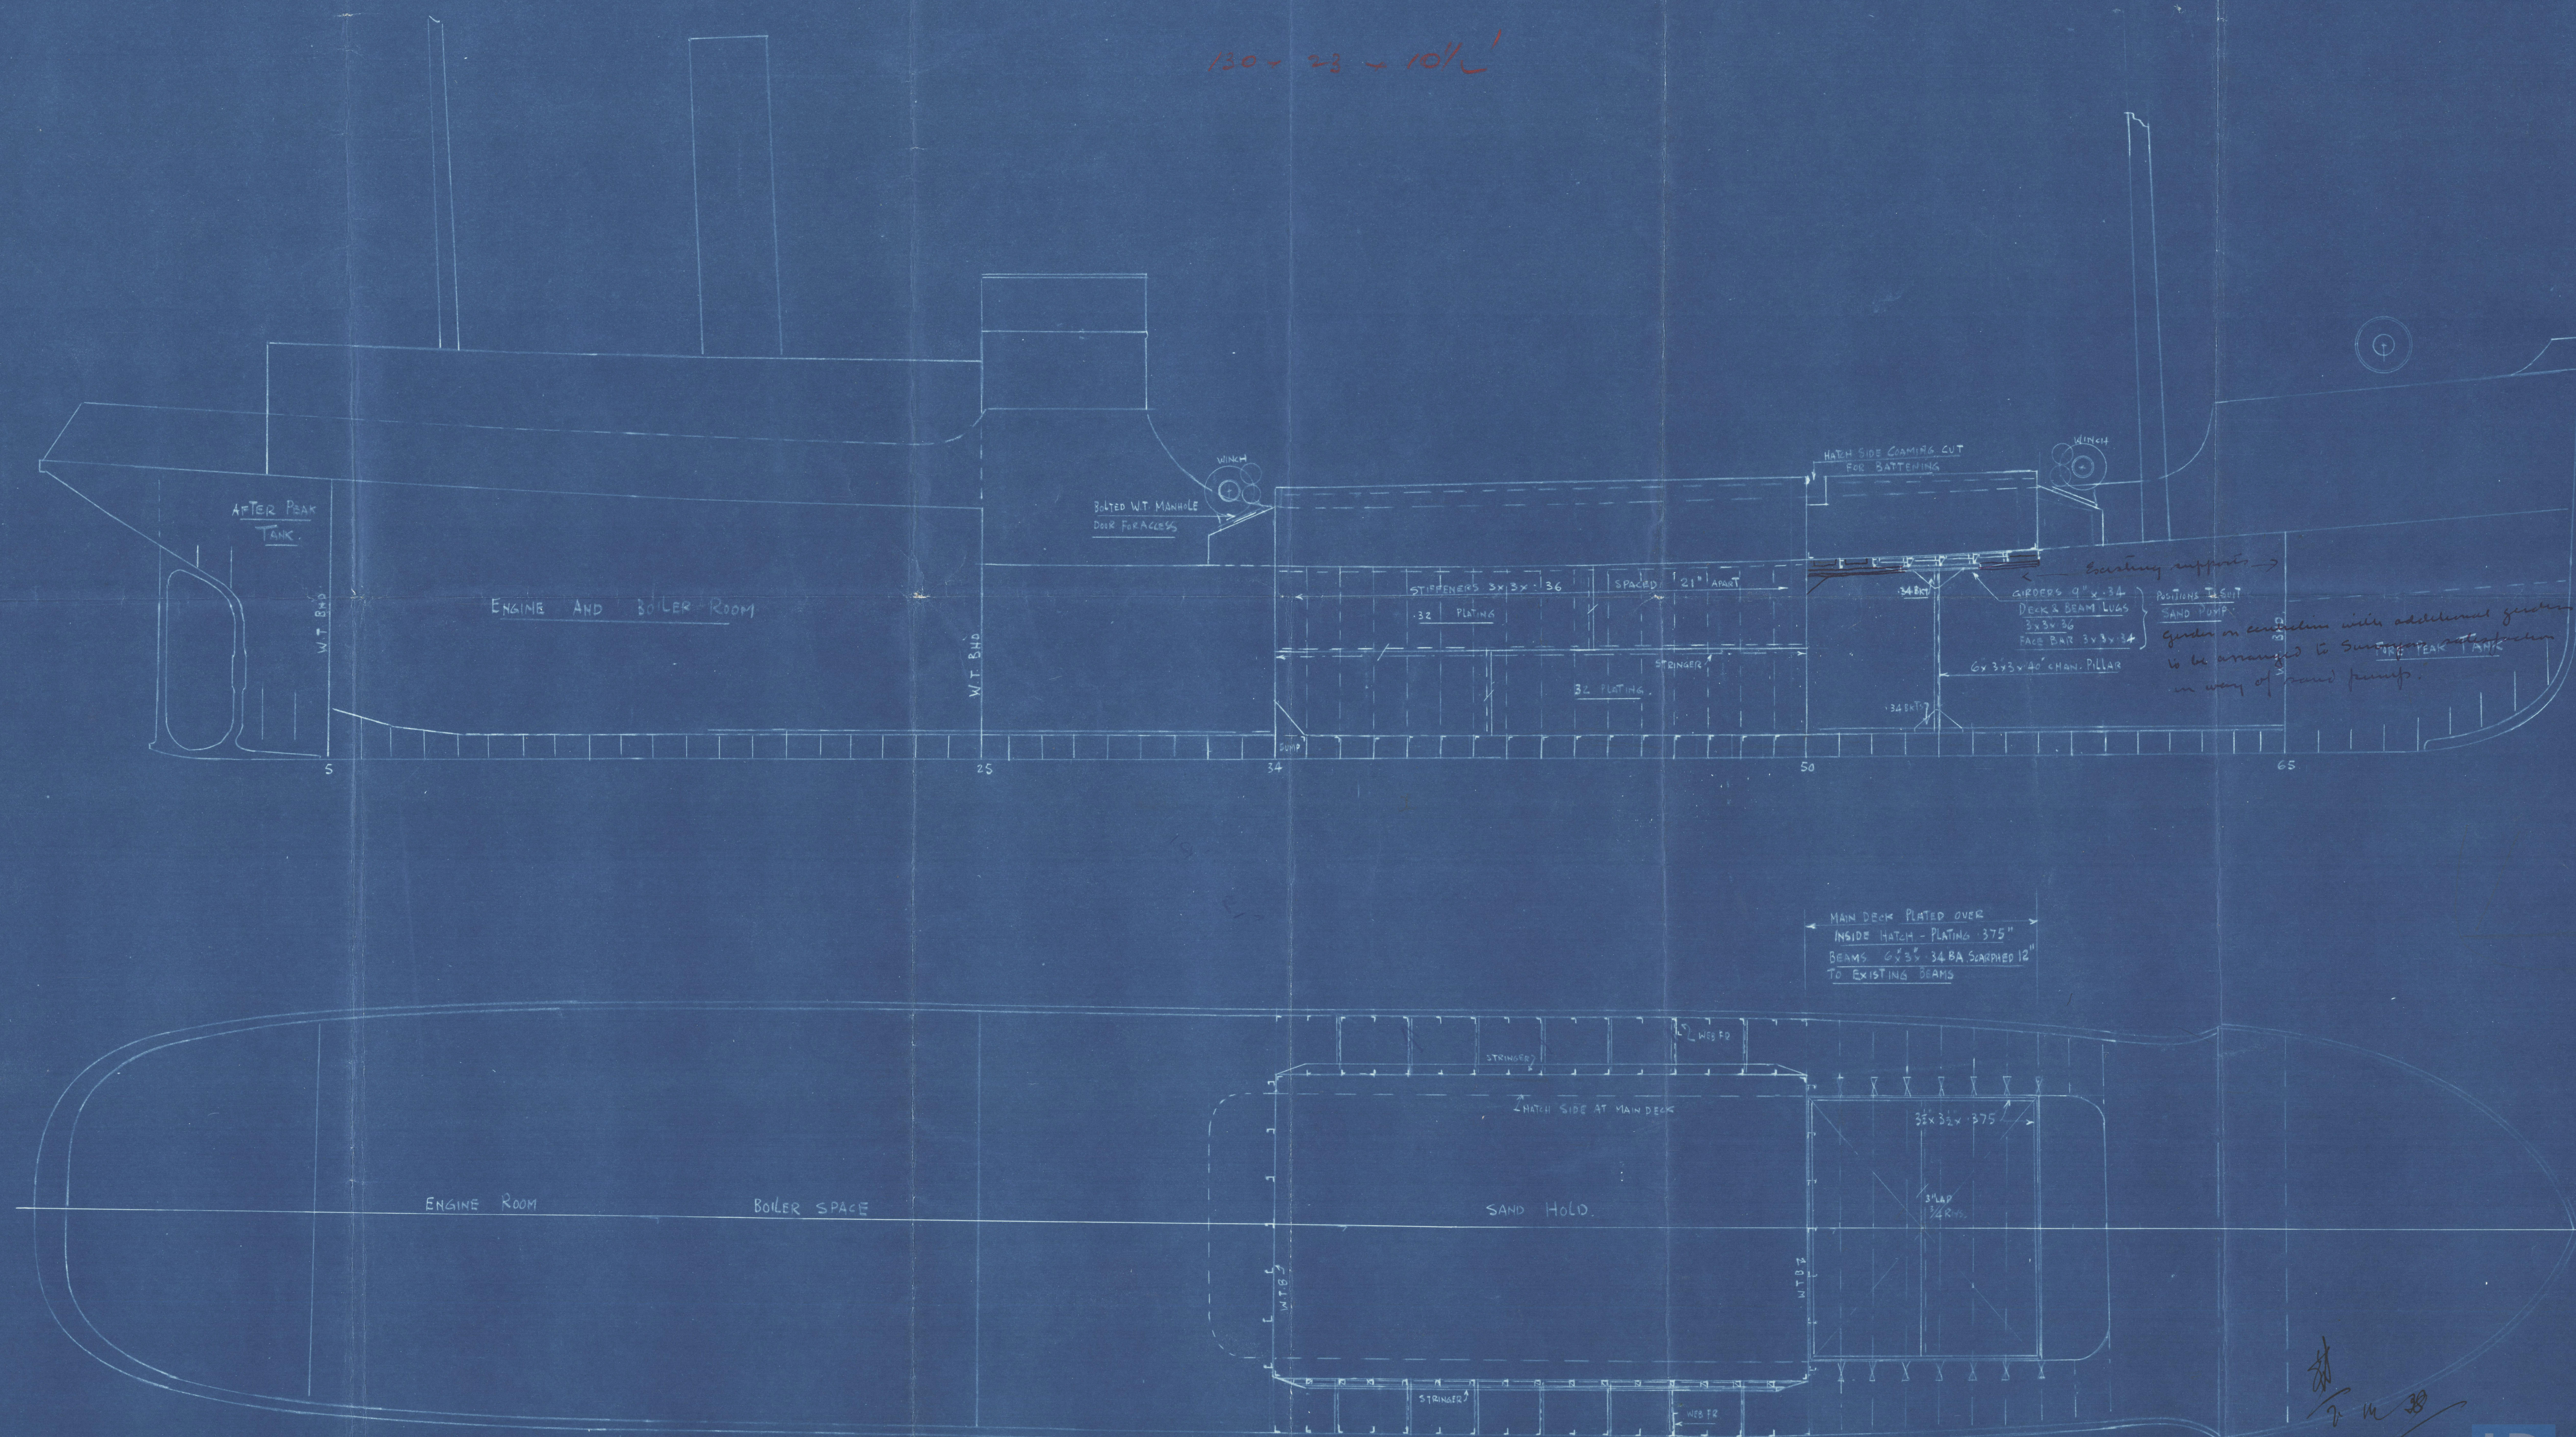

27 DEC 38



Lloyd's Register



RETAIN

005377 - 005386 - 0155

© 2021

Lloyd's Register
Foundation