


S.S. No. 630  
340'0" x 47'0" x 32'7" TO SHELTER DK.  
PROFILE AND STEEL DECKS.  
SCALE 1/8" = 1 FT.

WILLIAM BEARDMORE & CO., LTD.  
DESIGNING DEPT.  
NUMBER 5365  
DATE 23-6-23  
EXAMINED BY  
NAVAL CONSTRUCTION WORKS,  
DALMEIR, N.B.

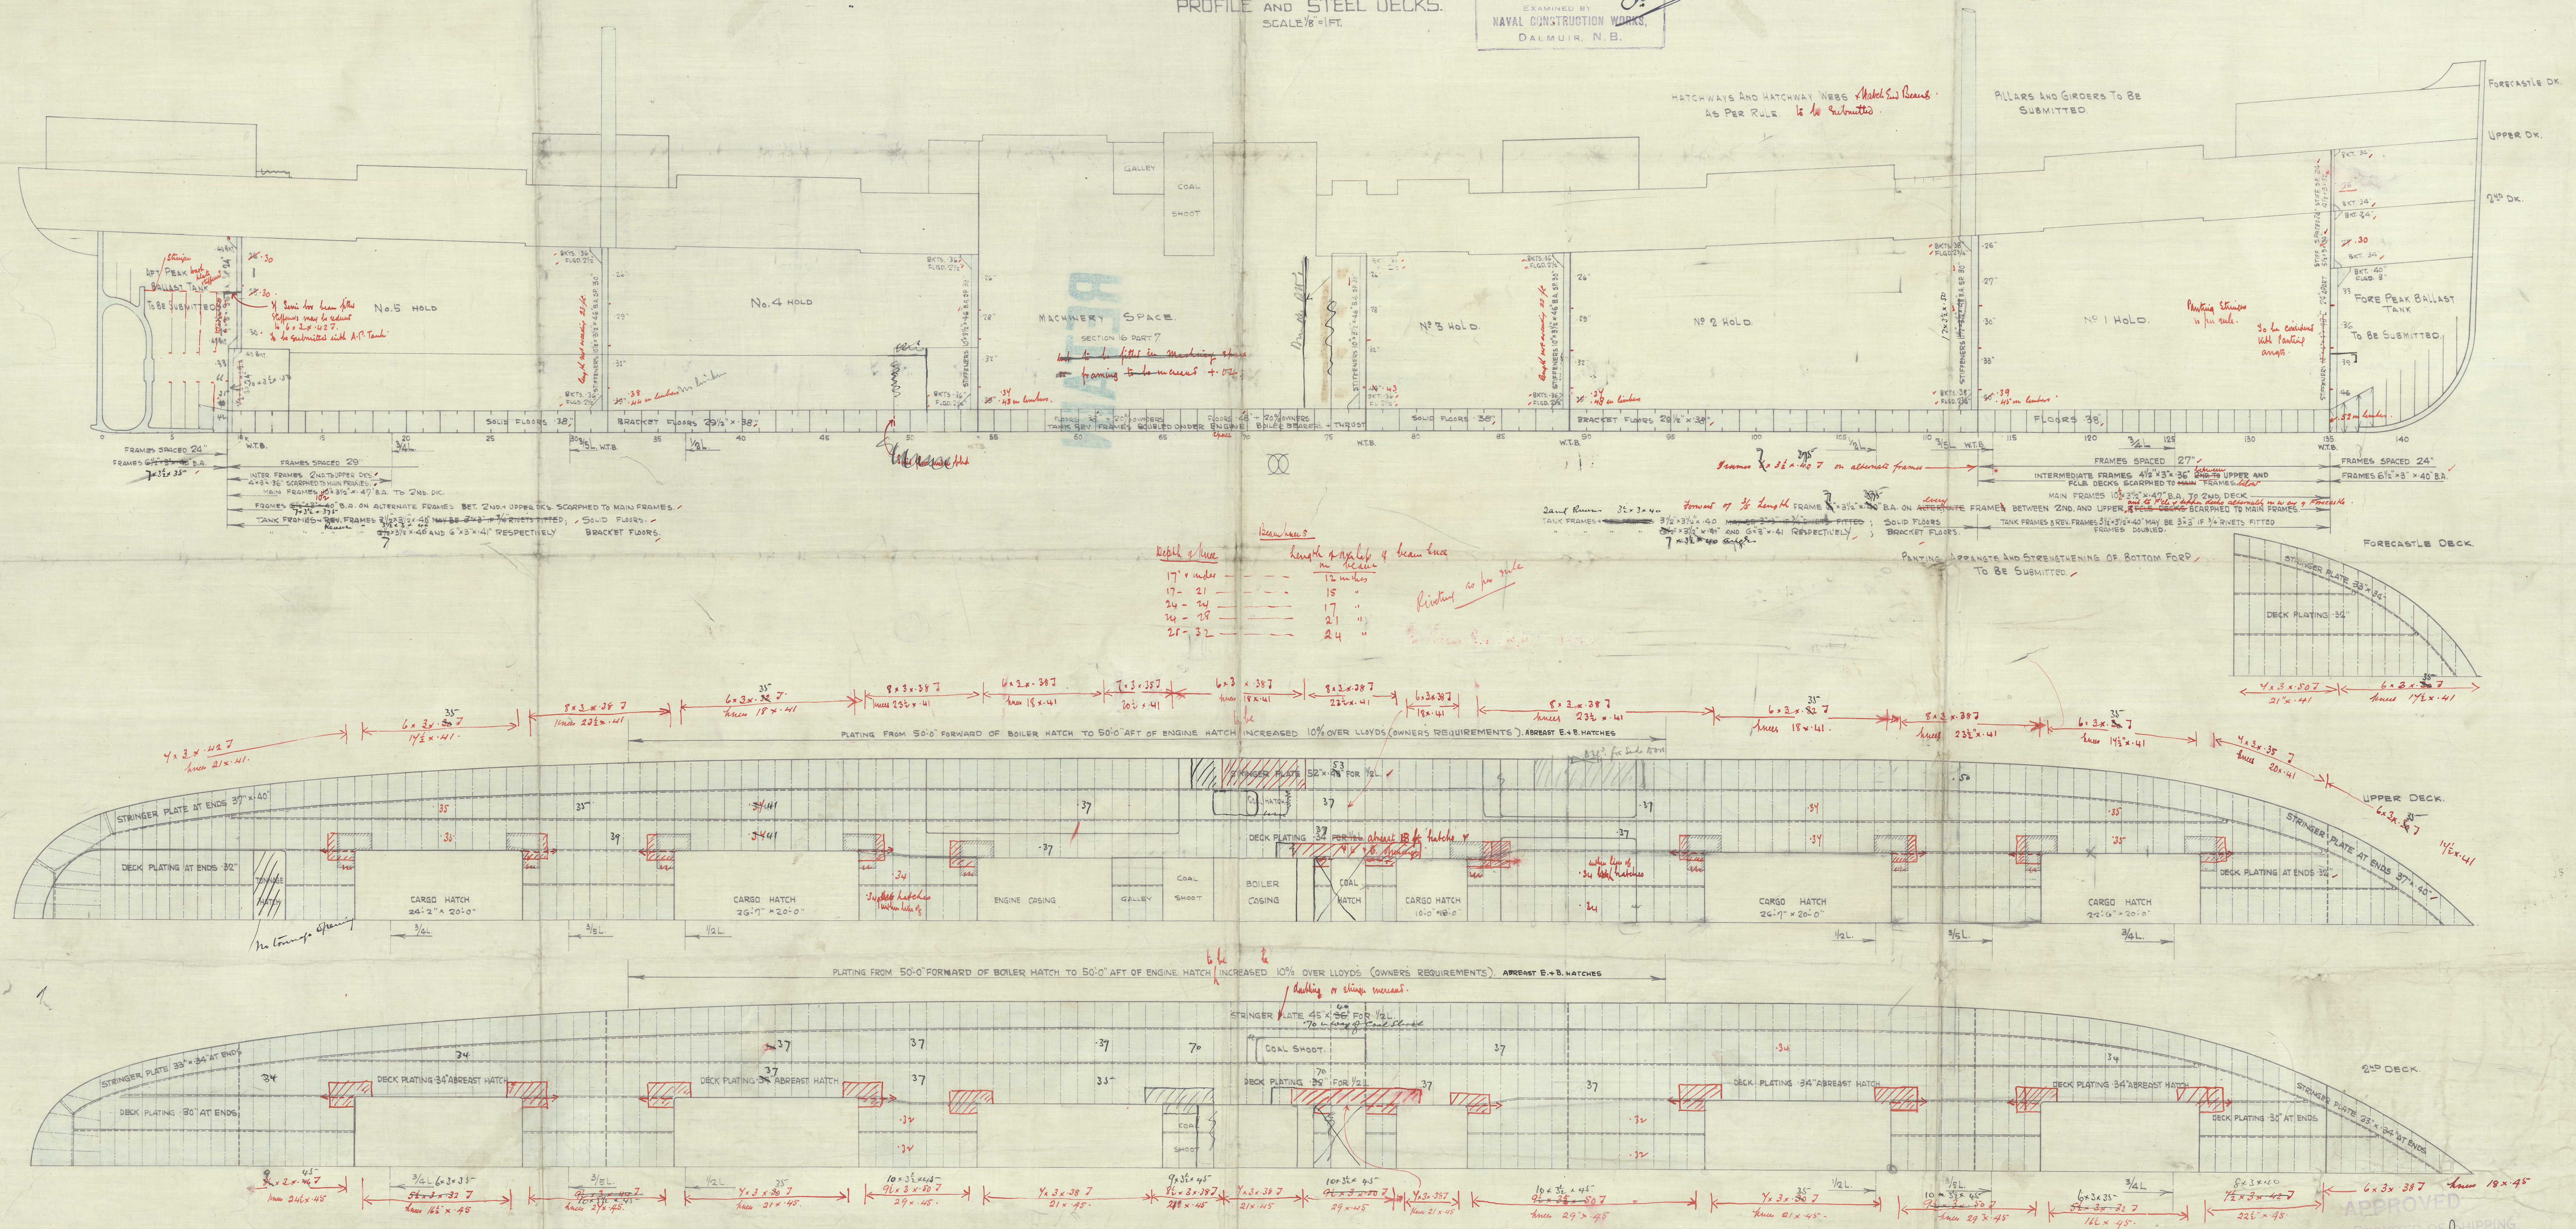



<sup>2</sup> <sup>4</sup> <sup>4</sup>  
Lys Arcoona

Wm Beadmore Esq. & Co  
No. 630

No 630

Glasgow Rpt no 43.641

Askaba

# RETAIN

© 2020

Lloyd's Register  
Foundation