

Hull

# Lloyd's Register of Shipping.

(Report on Vessel No. 30,337 Port Hull)

John Brennan

No.

## SHIP FORGINGS OR CASTINGS.

The words FORGINGS or CASTINGS, IRON or STEEL, should be struck out as may be required.

I have to report that the undermentioned Iron or Steel Forgings or Castings, manufactured by Messrs J. S. Forster & Sons Ltd of Sunderland for the Vessel No. 374, being built by Cook, Welton & Gemmell Ltd of Beverley have been inspected by me as set forth below and found to be, so far as can be seen, Sound

Mark on Forgings or Castings

Lloyd's


No. 441

D. W. Williamson

Sunderland 19-3-17

	STERN FRAME.	RUDDER FRAME.	STEM.
Material*	Scrap Iron	Scrap Iron	/
How made	Forged	Forged	
Dimensions	6" x 3"	4 1/2" x 4 1/2" x 3" x 2 3/4"	
Progress on Inspection	Finished	Forged & Finished	
Date when Inspected	5-1-17	8-1-17 to 19-3-17	
<b>CASTINGS.</b>			
Tests on Standard Test Pieces.			
Tensile Test—			
Tons per square inch			
Extension per cent.			
Cold Bending Test—			
Angle before fracture			
Drop Test—			
Height from ground			
Hammering Test—			
If made according to Rules and found satisfactory			

SKETCHES OF FRAMES SHOWING POSITION AND DESCRIPTION OF WELDS OF FORGINGS.

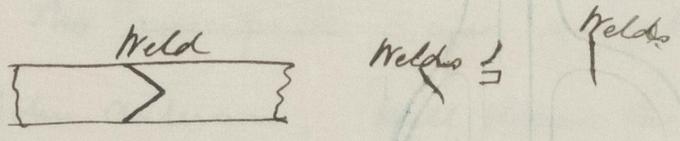

Fee (if any chargeable) £  
To be paid at



© 2020

Lloyd's Register Foundation

005387-005396-0302