M.V. "PALUDINA".

MIDSHIP SECTION. (AS FITTED)

SCALE:- 1/2 = 1 FOOT.

DIMENSIONS:- 425'-0 B.P. × 54'-3 B.M. × 31'-10½ D.M. TO UPPER DECK.

TO CLASS LLOYDS 100 A1 & "CARRYING PETROLEUM IN BULK"
SPECIAL ROTATION LONGITUDINAL FRAMING ON BOTTOM & AT DECK "ELECTRICALLY WELDED"
ALL REFERENCE LINES & SHADED DIMENSIONS STATED.

LLOYDS NUMERALS	(AS SHOWN FROM FF 44 TO FF 181)
L = 425'-0", B = 54'-3", D = 31'-8.75" = 9.5 = 30.92	
L × (B + D) = 425 (54.25 + 30.92)	= 36197
L × D = 425 × 30.92	= 13.141
L/D = 425/31.87	= 13.33

EQUIPMENT NUMERAL

L × (B + D) = 425 (54.25 + 30.92)	=	36197
Poop (8'0" × 8'-7½) + (4'-0 × 8'-5")	=	538
Bridge (11'-4.2 × 7.5 × 7.5" (6.5 × 7.5 × 5")	=	341 (207 + Plump Rm = 341)
Forecastle 4'-8.7" × 7.5 × 7.5	=	225
Bridge Deckhouse 31.92 × 8 × 6	=	208
Upper Bridge " 41.92 × 8 × 6	=	192
Nav. " " 43.46 × 8 × 5	=	174
Cranes 49.75 × 2.5 × 5	=	55
Poop Deckhouse 75.08 × 8 × 5	=	300
	TOTAL	38240
	GRADE	40400

EQUIPMENT (of)

1 Bower anchor	5F 0Ins each	(stockless)
1 Spare anchor	5F 0Ins	(HP. spare)
270 fms. 2¾" stud chain		Shackle
30 " " "	Spare chain	Tog
103 " 1¾" "	Towline	5in
1 " 80 fms. 7½" "	H.S.W.R.	7½"
1 " " "	"	5½"

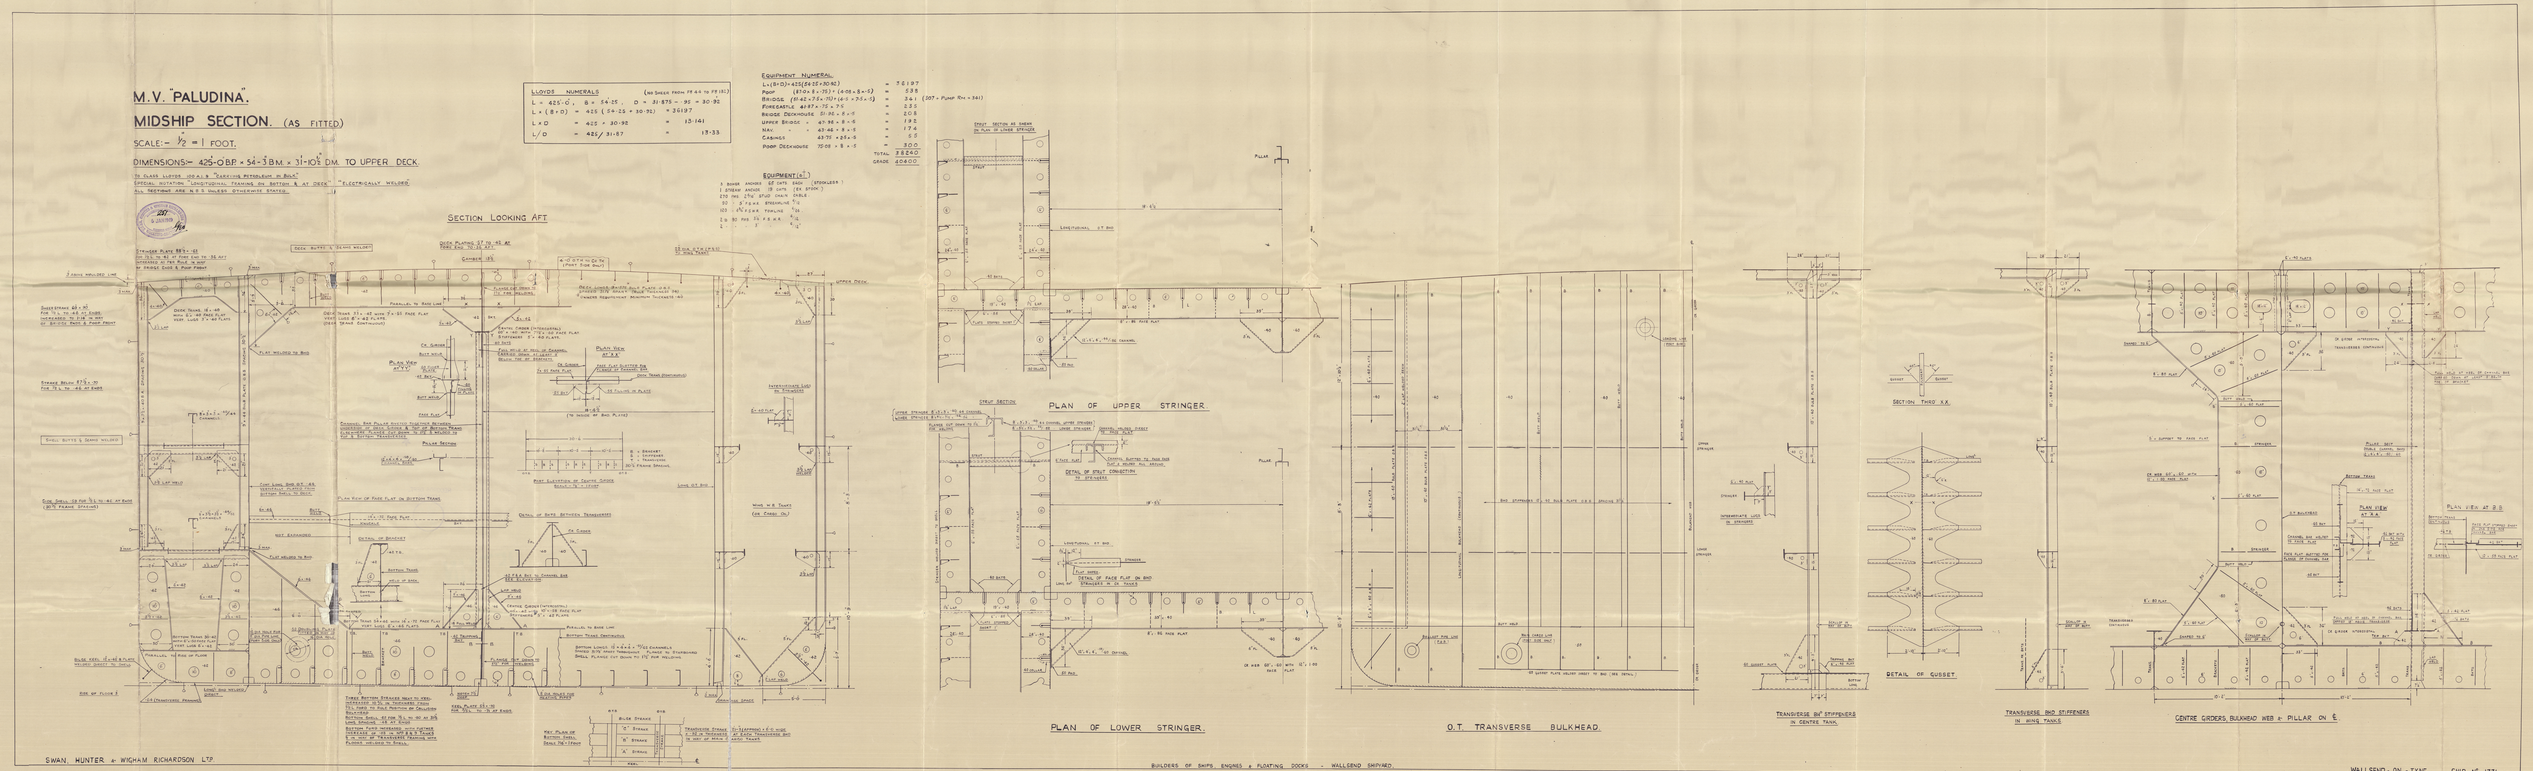

© 2021 Lloyd's Register Foundation

SWAN HUNTER & WIGHAM
RICHARDSON LTD.

No. 1771 "PALUDINA"

MIDSHIP SECTION
"AS FITTED"

NEWCASTLE-ON-TYNE, No.

"Paludina"
NEWCASTLE ON TYNE
Report No. 105889

RECORDS DEPT.,
LONDON

2

RETAIN

© 2021
Lloyd's Register
Foundation
005397-005402-0002