


- NOS 460.1-2 -
 - GENERAL ARRANGEMENT -
 - STEAM BARGE FOR CARRYING PETROLEUM -


- DIMENSIONS -

LENGTH	B.P.	140'-7"
BEAM	M.O.	27'-6"
DEPTH	M.O.	11'-6"
DRAFT	B.	10'-7"

- SCALE 1/4" = 1 FOOT -

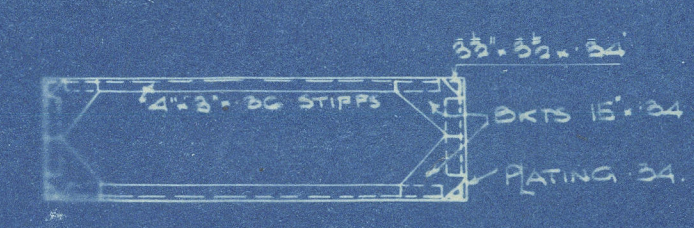


APP OF OIL PONG SUBMITTED
 LATER.

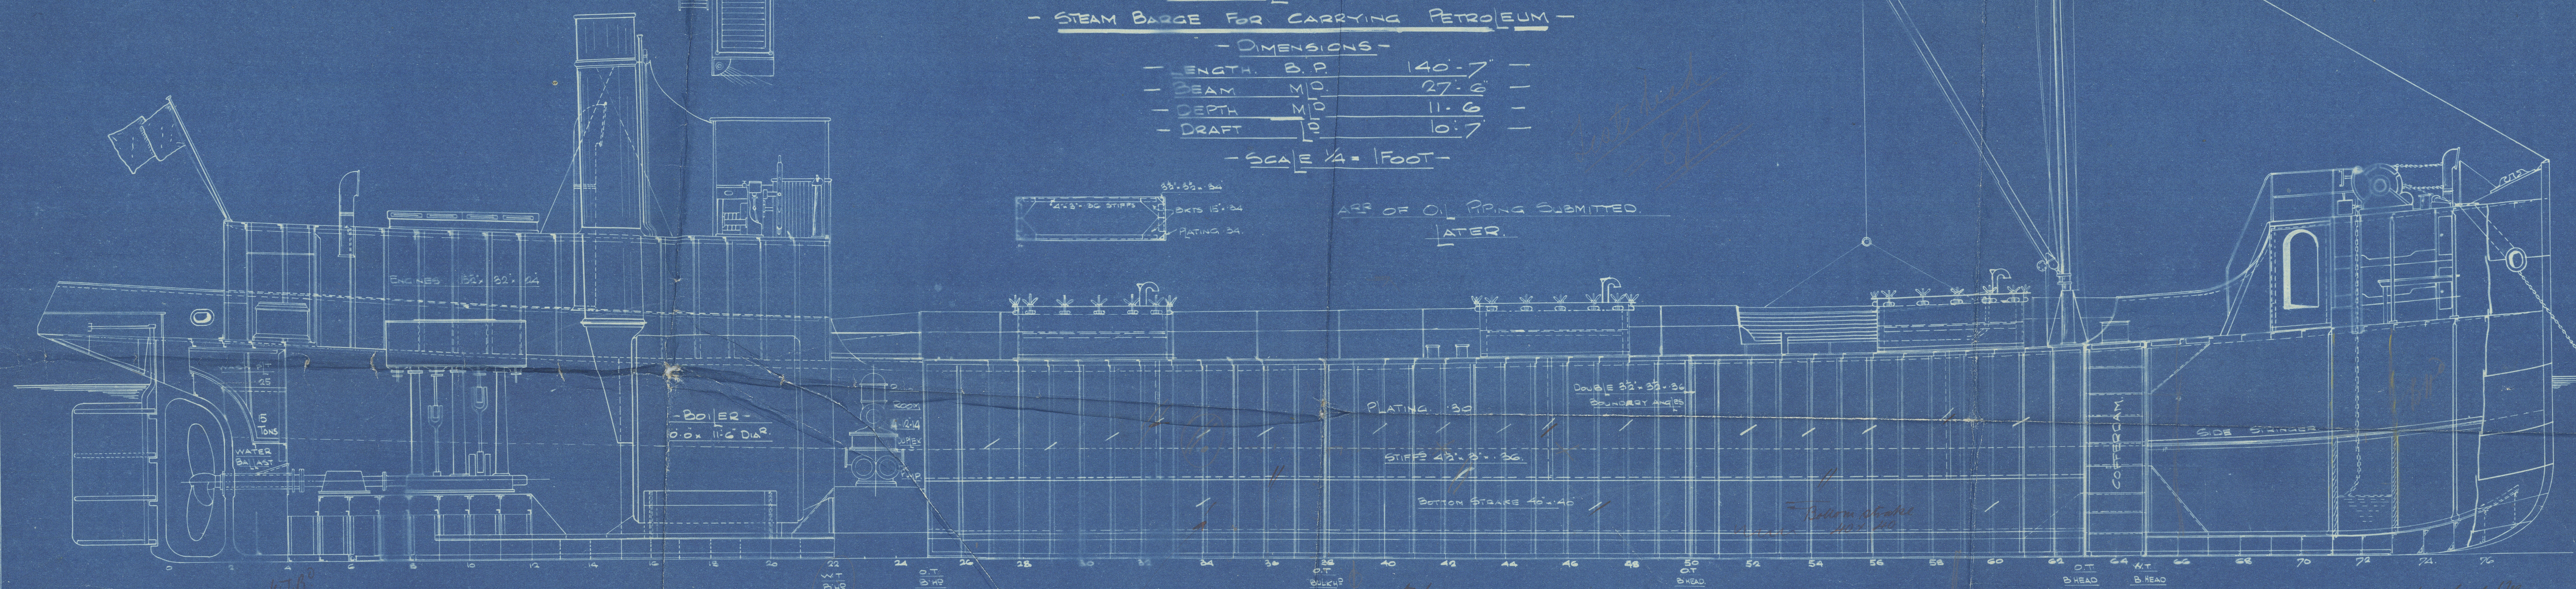

*Seams & bolts to be spaced melted
 Long. buckled & be out tight*

*Collision bulk head to be
 fitted on fore peak*

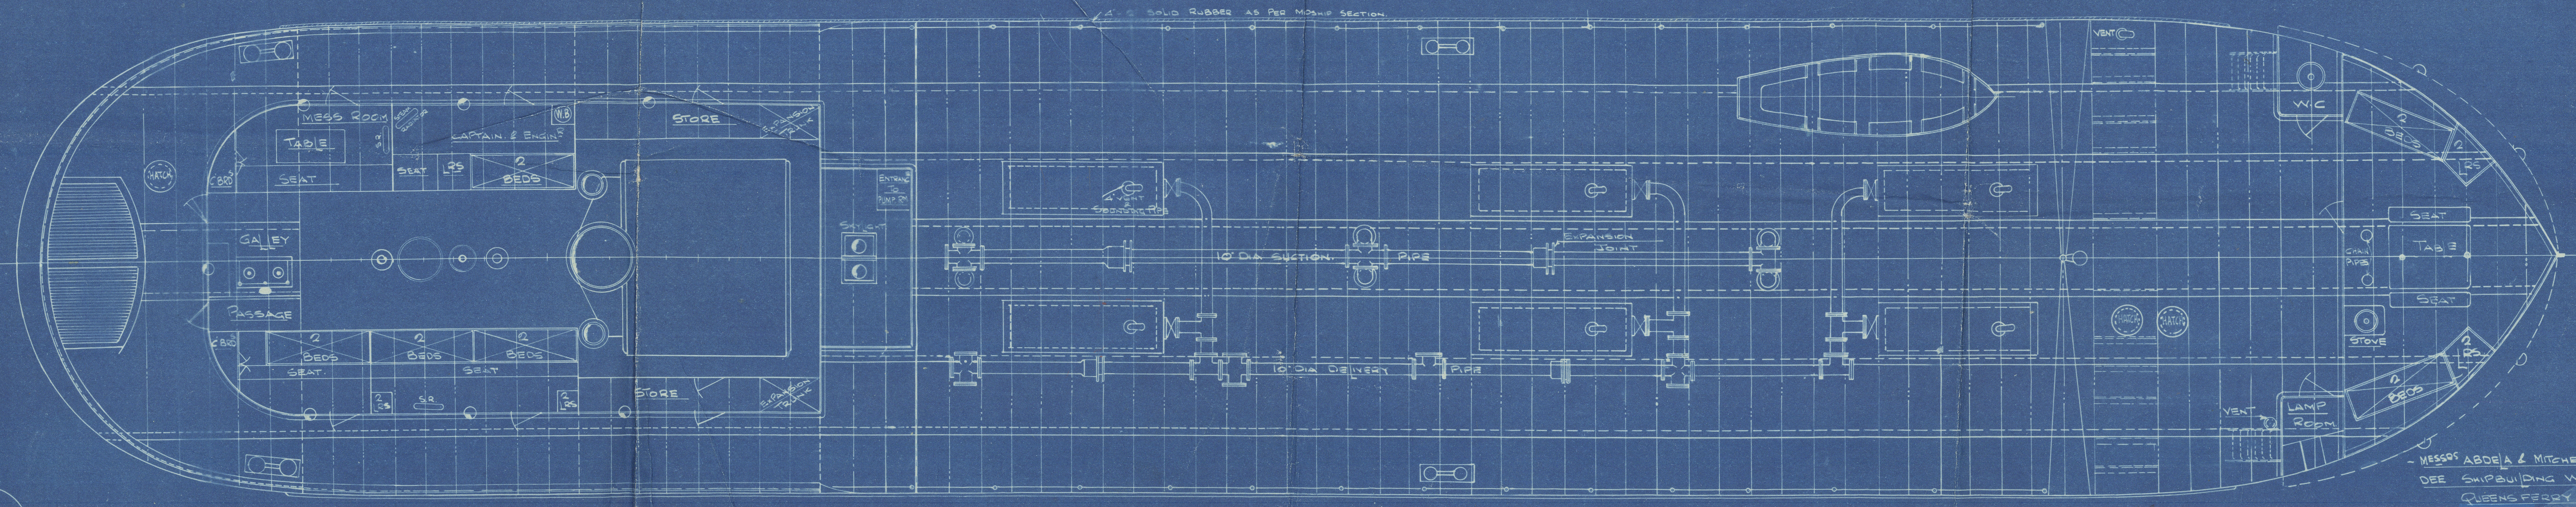

- MESSRS ABDELA & MITCHELL LTD
 DEE SHIPBUILDING WORKS
 QUEENSFERRY
 GLASGOW



Abdela Thutchell

460, 1 + 2

General arr.
"SHELL MEX 4" ❄

~~Gen Box 3107~~ →

Shell Mex 5

Liv 82656



© 2020

Lloyd's Register
Foundation

005403-005411-0024